


TIME: 14:48
FILE: RALPH2B.dwg


SCALE = 5' VERT.
= 10' HORIZ.

RECORD PLANS
12-17-2002
STA 75+25 TO 77+25

PREPARED BY:
VIA WIER & ASSOCIATES, INC.
ENGINEERS SURVEYORS LAND PLANNERS
4300 BELLEVUE PLACE SUITE 130 ARLINGTON, TEXAS 76010 METRO (817)467-7700
4100 MAIN CARTER BLVD. SUITE 200 FORT WORTH, TEXAS 76165 METRO (817)355-9437

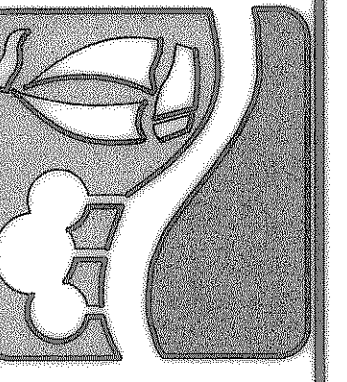

**RALPH HALL PARKWAY
CROSS-SECTIONS**

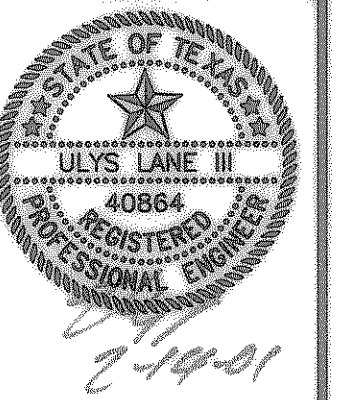

COPYRIGHT ©
WIER & ASSOCIATES, INC.
LAST SHEET EDIT
DATE 01-31-2001
WAB 97057
SHEET NO. 68