


FILE: RALPH2B.dwg
TIME: 14.48


SCALE = 5' VERT.
= 10' HORIZ.

RECORD PLANS
12-17-2002
STA 77+50 TO 78+50

PREPARED BY:
VIA WIER & ASSOCIATES, INC.
ENGINEERS SURVEYORS & LAND PLANNERS
4300 BELTWAY PLACE SUITE 130 ARLINGTON, TEXAS 76010 METRO (817)467-7700
4100 AMON CREEK BLVD. SUITE 200 FORT WORTH, TEXAS 76155 METRO (817)335-9437

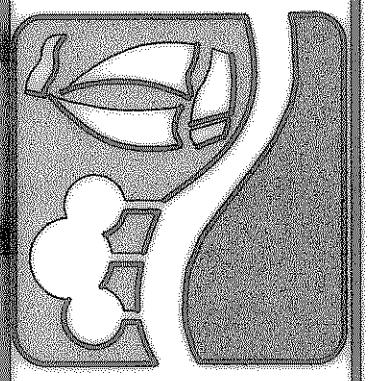

**RALPH HALL PARKWAY
CROSS-SECTIONS**

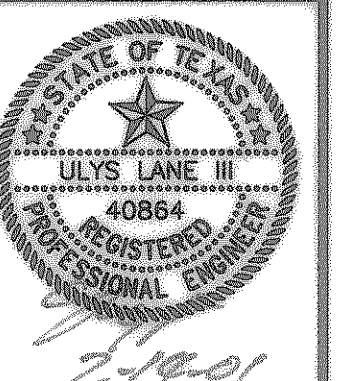

COPYRIGHT © WIER & ASSOCIATES, INC.
LAST SHEET EDIT DATE 01-31-2001
WAE 97057
SHEET NO. 69