


FILE: RALPH2B.dwg
TIME: 1/4/08


SCALE = 5' VERT.
= 10' HORIZ.

RECORD PLANS
12-17-2002
STA 78+65 TO 79+06

PREPARED BY:
VIA WIER & ASSOCIATES, INC.
ENGINEERS SURVEYORS LAND PLANNERS
4300 BELTWAY PLACE SUITE 130 ARLINGTON, TEXAS 76016 METRO (817)467-7700
4100 AMWAY CENTER BLDG. SUITE 200 FORT WORTH, TEXAS 76105 METRO (817)355-9557

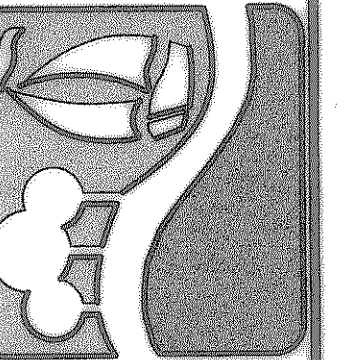

**RALPH HALL PARKWAY
CROSS-SECTIONS**

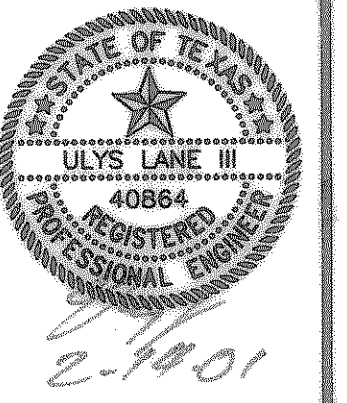

2-1901
COPYRIGHT ©
WIER & ASSOCIATES, INC.
LAST SHEET EDIT
DATE 01-31-2001
WAS 97057
SHEET NO.
70