


FILE: RALPH2B.dwg
TIME: 14:48


SCALE 1/4" = 5' VERT.
1" = 10' HORIZ.

RECORD PLANS
12-17-2002

PREPARED BY:
VIA WIER & ASSOCIATES, INC.
ENGINEERS SURVEYORS LAND PLANNERS
4300 BELTWAY PLACE SUITE 130 ARLINGTON, TEXAS 76016 METRO (817)467-7700
4106 AMON CORTER BLVD. SUITE 200 FORT WORTH, TEXAS 76165 METRO (817)395-4937

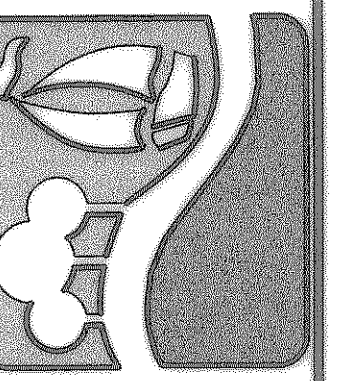

**RALPH HALL PARKWAY
CROSS-SECTIONS**

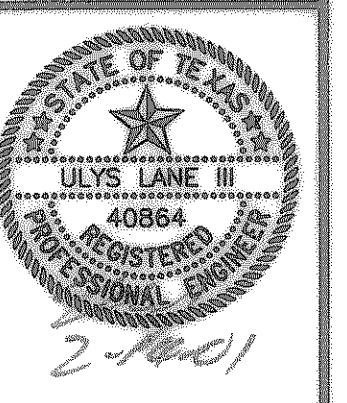

COPYRIGHT ©
WIER & ASSOCIATES, INC.
LAST SHEET EDIT
DATE 01-31-2001
W# 97057
SHEET NO. 71