


TIME 9:47
FILE:RALPH2B.dwg


SCALE 1"=5' VERT.
1"=10' HORIZ.

RECORD PLANS
12-17-2002
STA 81+30 TO 82+25

PREPARED BY:
VIA WIER & ASSOCIATES, INC.
ENGINEERS SURVEYORS LAND PLANNERS
4300 BELTWAY PLACE SUITE 130 ARLINGTON, TEXAS 76010 (817) 467-7700
4100 AMON CREEK BLVD. SUITE 200 FORT WORTH, TEXAS 76155 (817) 335-4457

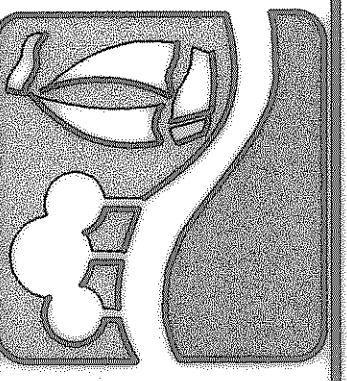

**RALPH HALL PARKWAY
CROSS-SECTIONS**

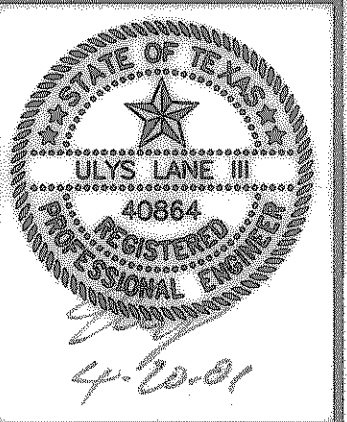

COPYRIGHT ©
WIER & ASSOCIATES, INC.
LAST SHEET EDIT
DATE 04-18-2001
WAW 97057
SHEET NO. 72