


FILE: RALPH2B.dwg  
TIME: 01:47

GUT 131.0 SQ.FT.  
SCALE: VERT. = 5'  
HORIZ. = 10'


RECORD PLANS  
12-17-2002

STA 82+26 TO 83+46

PREPARED BY:  
**VIA WIER & ASSOCIATES, INC.**  
ENGINEERS SURVEYORS LAND PLANNERS  
4300 BEECHWAY PLACE SUITE 130 ARLINGTON, TEXAS 76016 METRO (817) 467-7700  
4100 AMAR CORNER BLDG. SUITE 200 FORT WORTH, TEXAS 76165 METRO (817) 265-9457

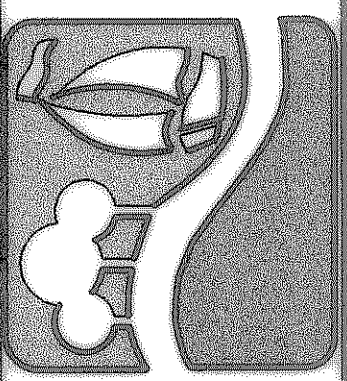

**RALPH HALL PARKWAY  
CROSS-SECTIONS**

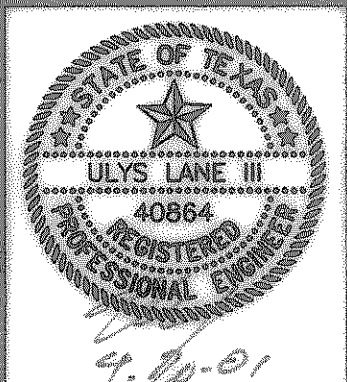

COPYRIGHT ©  
WIER & ASSOCIATES, INC.  
LAST SHEET EDIT  
DATE 04-19-2001  
WAW 97057  
**SHEET NO. 73**