


FILE: RALPH25.dwg
TIME: 9:47

SCALE
" = 5' VERT.
" = 10' HORIZ.

RECORD PLANS
12-17-2002

PREPARED BY:
VIA WIER & ASSOCIATES, INC.
ENGINEERS SURVEYORS LAND PLANNERS
4300 BELTWAY PLAZE SUITE 110 ARLINGTON, TEXAS 76010 METRO (817)447-7700
4100 ADAM CENTER BLVD. SUITE 200 FORT WORTH, TEXAS 76155 METRO (817)355-9457

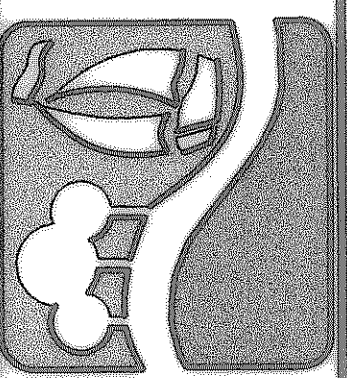

**RALPH HALL PARKWAY
CROSS-SECTIONS**



4-10-01
COPYRIGHT © WIER & ASSOCIATES, INC.
LAST SHEET EDIT DATE 04-19-2001
SHEET NO. 74