


FILE:RALPH2B.dwg
TIME:9:47

SCALE " = 5' VERT.
" = 10' HORIZ.

RECORD PLANS
12-17-2002

PREPARED BY:
VIA WIER & ASSOCIATES, INC.
ENGINEERS SURVEYORS LAND PLANNERS
4300 BELLEVUE PLACE SUITE 130 ARLINGTON TEXAS 76010 METRO (817)467-7700
4100 NORTH CORDER BLVD. SUITE 200 FORT WORTH, TEXAS 76104 METRO (817)355-4477

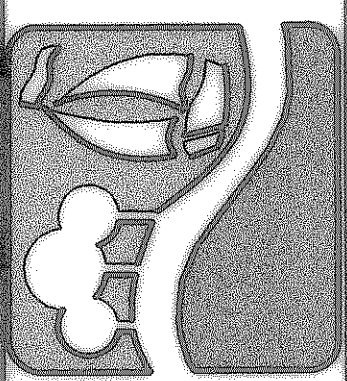

**RALPH HALL PARKWAY
CROSS-SECTIONS**



COPYRIGHT ©
WIER & ASSOCIATES, INC.
LAST SHEET EDIT
DATE: 04-28-2001
WAW: 97057
SHEET NO. 76