



TIME: 01:47
FILE: RALPH2B.dwg

RECORD PLANS
12-17-2002
STA 87+25 TO 87+25

PREPARED BY:
VIA WIER & ASSOCIATES, INC.
ENGINEERS SURVEYORS LAND PLANNERS
4300 BELTWAY PLACE SUITE 130 ARLINGTON TEXAS 76010 METRO (817) 467-7700
4100 AUDA CENTER BLVD. SUITE 200 FORT WORTH, TEXAS 76155 METRO (817) 355-4347

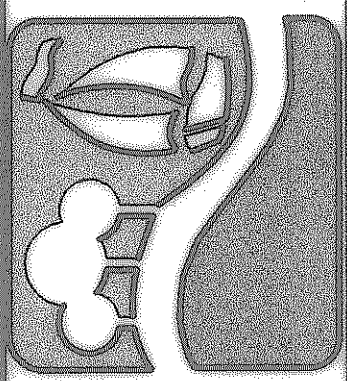

**RALPH HALL PARKWAY
CROSS-SECTIONS**

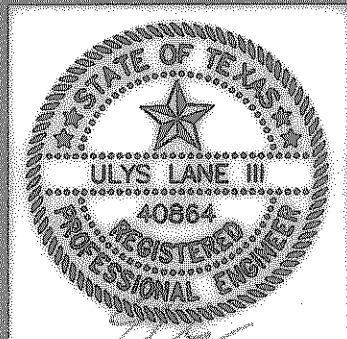

4/20/01
COPYRIGHT ©
WIER & ASSOCIATES, INC.
LAST SHEET EDIT
DATE 04-19-2001
WAR 97057
SHEET NO.
77