


WIA WIER & ASSOCIATES, INC.
 ENGINEERS SURVEYORS LAND PLANNERS
 4300 BELLEVUE PLACE SUITE 130 ARLINGTON, TEXAS 76010 METRO (817) 467-7700
 4100 AMAR CORNER BLVD. SUITE 200 FORT WORTH, TEXAS 76105 METRO (817) 335-4377



**S. H. 205 (GOLIAD STREET)
 CROSS-SECTIONS**

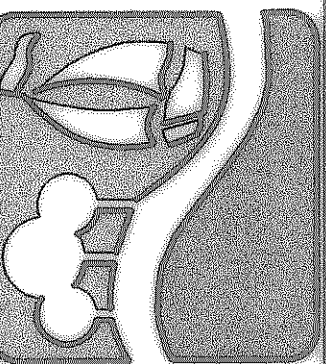

RECORD PLANS
 12-17-2002

STA 457+75 TO 460+00

SHEET NO. 79

COPYRIGHT © WIER & ASSOCIATES, INC.
 LAST SHEET EDIT DATE 04-19-2001
 WAW 97057