


FILE: GOLIAD.dwg
TIME: 9:54

SCALE
"=5' VERT.
"=10' HORIZ.

RECORD PLANS
12-17-2002

STA 460+25 TO 462+00

PREPARED BY:
VIA WIER & ASSOCIATES, INC.
ENGINEERS SURVEYORS LAND PLANNERS
4300 BELTWAY PLACE SUITE 130 ARLINGTON, TEXAS 76010 METRO (817) 467-7700
4100 AVON CREEK BLVD. SUITE 200 FORT WORTH, TEXAS 76105 METRO (817) 285-4477

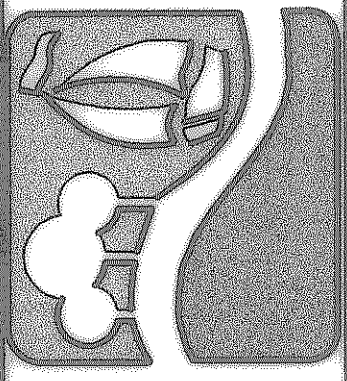

S. H. 205 (GOLIAD STREET)
CROSS-SECTIONS



4-2001
COPYRIGHT ©
WIER & ASSOCIATES, INC.
LAST SHEET EDIT
DATE 04-18-2001
WAW 97067
SHEET NO.
80