


TIME 8:54  
FILE: GOLIAD.dwg


SCALE  
"=5' VERT.  
"=10' HORIZ.

RECORD PLANS  
12-17-2002

PREPARED BY:  
**VIA WIER & ASSOCIATES, INC.**  
ENGINEERS SURVEYORS LAND PLANNERS  
4800 BELLEVUE PLACE, SUITE 130, FORT WORTH, TEXAS 76116 (817) 451-7700  
4108 AMARILLO CORNER BLDG., SUITE 200, FORT WORTH, TEXAS 76104 (817) 355-9417

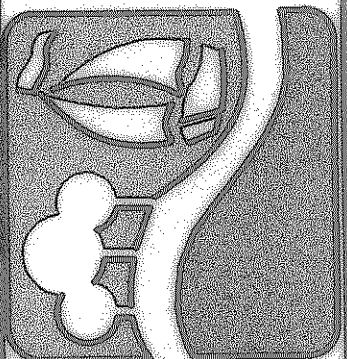

S. H. 205 (GOLIAD STREET)  
CROSS-SECTIONS

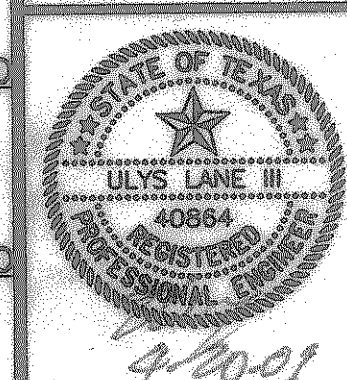

4/20/01  
COPYRIGHT ©  
WIER & ASSOCIATES, INC.  
LAST SHEET EDIT  
DATE 04-19-2001  
WAW 97087

SHEET NO.  
81