

MATCH LINE STA 54+00

STATE OF TEXAS
VOL. 65, PG. 591
D.R.R.C.T.

L & B LAND
CATTLE COMPANY
VOL. 1406, PG. 120
D.R.R.C.T.

PRS REALTY II, LP
VOL. 961, PG. 55
D.R.R.C.T.

PHASE "A" STORM DRAIN CONSTRUCTION.
PROVIDE PHASE I & II INLET TREATMENT.
MAINTAIN UNTIL PARKWAYS ARE SEEDED.

PHASE "A" STORM DRAIN CONSTRUCTION.
PROVIDE PHASE I & II DROP INLET
TREATMENT. MAINTAIN UNTIL SLOPES
ARE SEEDED.

INSTALL 510 L.F. REINFORCED SILT FENCE
ALONG TOE OF SLOPE. MAINTAIN UNTIL
PARKWAYS AND SLOPES ARE SEEDED.

PRS REALTY II, LP
VOL. 961, PG. 55
D.R.R.C.T.

PHASE "A" CONSTRUCTION. INSTALL 15 L.F.
18" HIGH ROCK BERM AT END OF EXCAVATION.
REMOVE BY SCATTERING ROCK IN DITCH ONCE
SLOPES ARE REVEGETATED.

INSTALL 290 L.F. REINFORCED SILT
FENCE ALONG TOE OF SLOPE.
MAINTAIN UNTIL PARKWAYS AND
SLOPES ARE SEEDED.



MATCH LINE STA 64+00

LEGEND

- PHASE "A" CONSTRUCTION
- PHASE "B" CONSTRUCTION
- PHASE "C" CONSTRUCTION
- PHASE "D" CONSTRUCTION
- DENOTES INLET TREATMENT
- DENOTES REINFORCED SILT FENCE

PRS REALTY II, LP
VOL. 961, PG. 55
D.R.R.C.T.

PHASE "A" STORM DRAIN CONSTRUCTION.
PROVIDE PHASE I & II INLET TREATMENT.
MAINTAIN UNTIL PARKWAYS ARE SEEDED.

LOT 1, BLOCK C
ROCKWALL BUSINESS PARK EAST
PHASE THREE
CAB. B, SLIDE 291
P.R.R.C.T.

MATCH LINE STA 64+00

INSTALL 130 L.F. REINFORCED SILT FENCE
ALONG TOE OF SLOPE. MAINTAIN UNTIL
PARKWAYS AND SLOPES ARE SEEDED.

PRS REALTY II, LP
VOL. 961, PG. 55
D.R.R.C.T.

- NOTES:
- REFER TO SHEET 40 FOR CONSTRUCTION SEQUENCING NOTES.
 - REFER TO SHEET 43 AND 44 FOR EROSION CONTROL DETAILS.
 - ALL TRAFFIC CONTROL DEVICES AND LAYOUT SHALL CONFORM TO THE LATEST EDITION OF THE MANUAL ON UNIFORM TRAFFIC CONTROL DEVICES.
 - PROVIDE TRAFFIC CONTROL DEVICES TO DELINEATE TEMPORARY STEEP PAVEMENT EDGES.
 - UTILITY CROSSINGS OF EXISTING PAVEMENT WILL BE ALLOWED AS LONG AS TWO-WAY TRAFFIC IS KEPT IN SERVICE.


LOT 1, BLOCK B
ROCKWALL BUSINESS PARK EAST
PHASE THREE
CAB. B, SLIDE 291
P.R.R.C.T.




RECORD PLANS
12-17-2002

MATCH LINE STA 74+00

PREPARED BY:
WIA WIER & ASSOCIATES, INC.
ENGINEERS SURVEYORS LAND PLANNERS
4300 BELTWAY PLACE SUITE 130 ARLINGTON TEXAS 76016 METRO (817)467-7700
4100 MAIN CENTER BLVD. SUITE 200 FORT WORTH, TEXAS 76165 METRO (817)365-9457

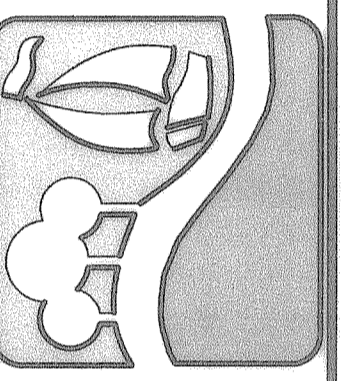

CONSTRUCTION SEQUENCE
& EROSION CONTROL PLAN
STA 54+00 TO 74+00

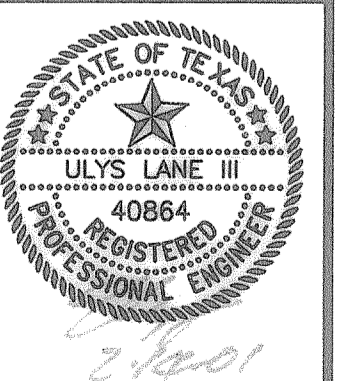

COPYRIGHT ©
WIER & ASSOCIATES, INC.
LAST SHEET EDIT
DATE 01-30-2001
WA# 97057

SHEET NO.
37

TIME: 11:41:21 FILE: traffic5.dwg