
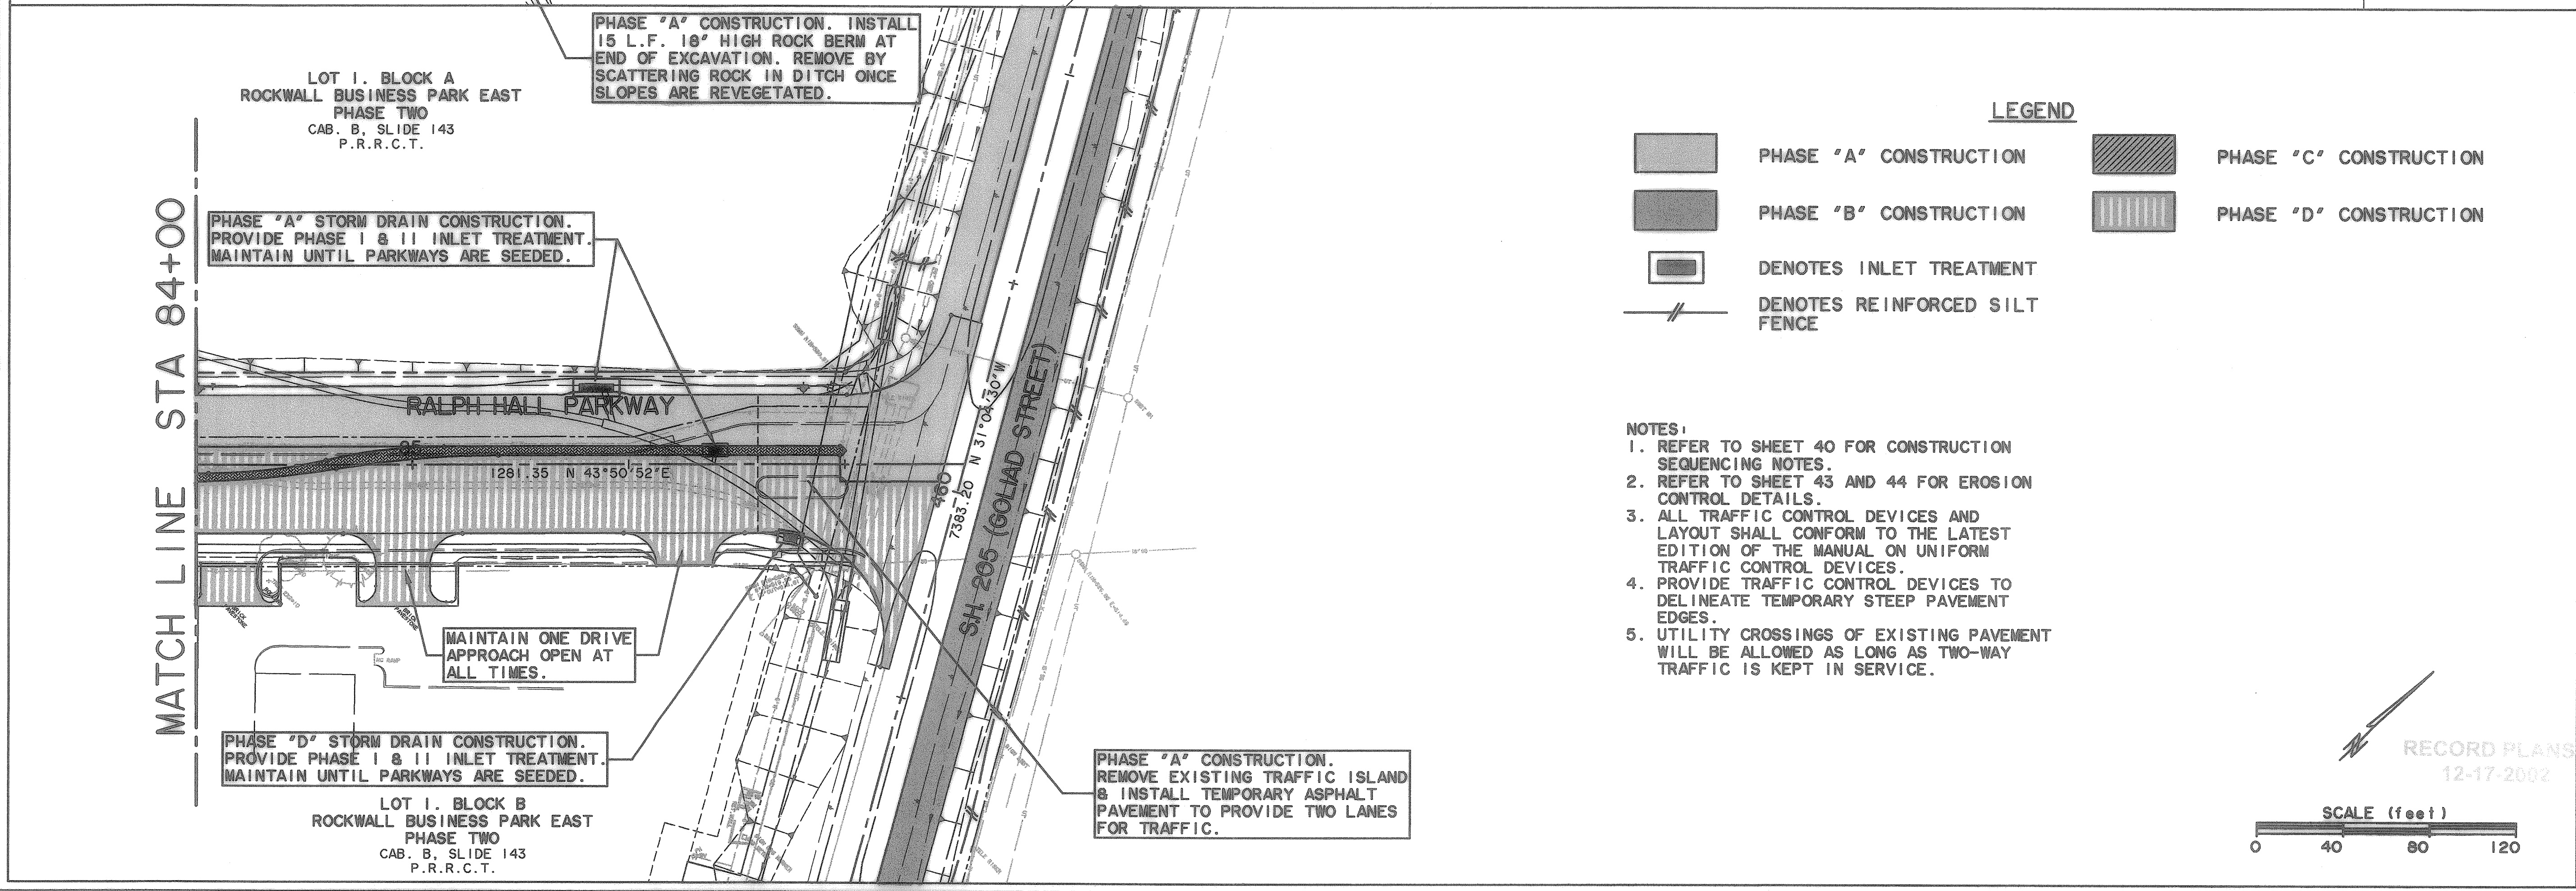


TIME: 10:28 FILE: 1 TRAFFIC6.dwg

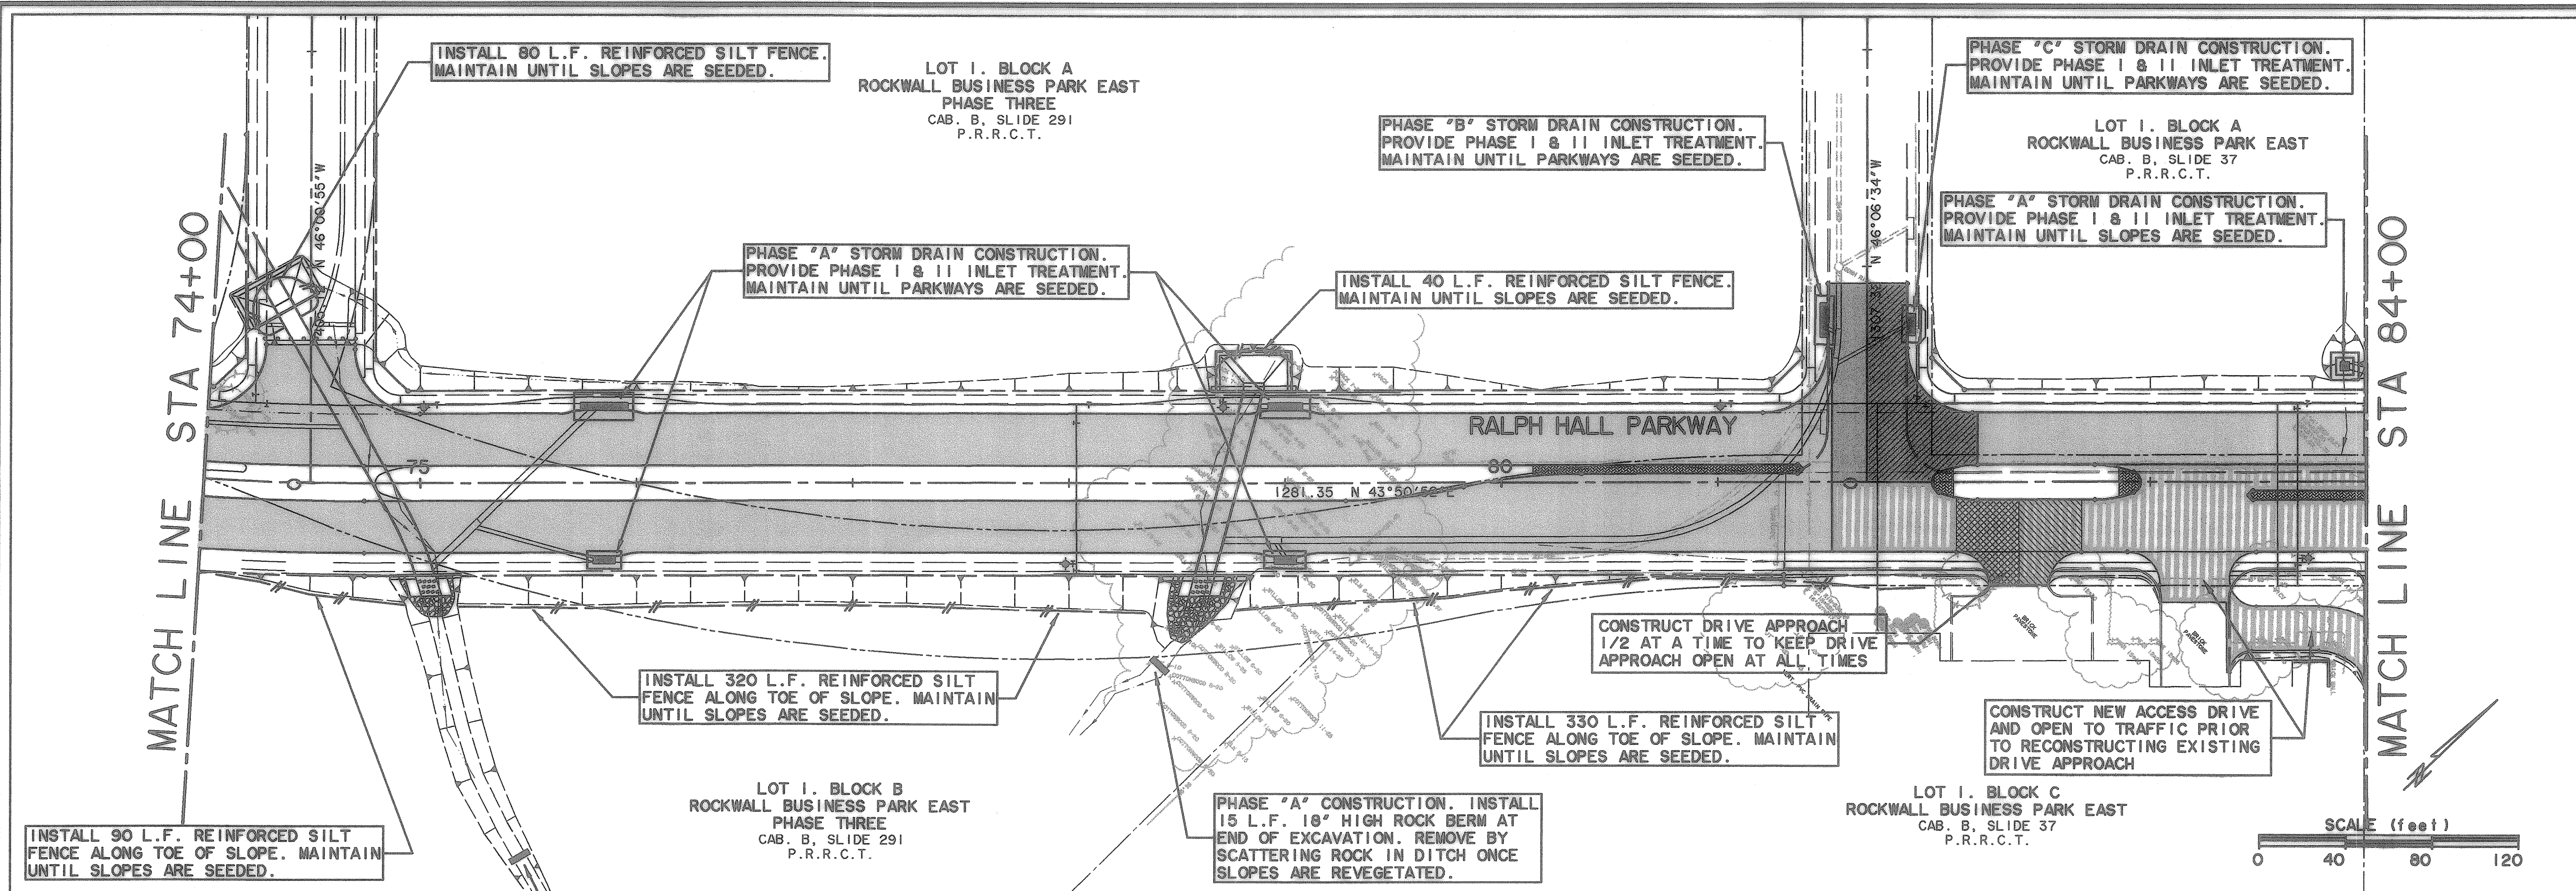

LEGEND


	PHASE "A" CONSTRUCTION		PHASE "C" CONSTRUCTION
	PHASE "B" CONSTRUCTION		PHASE "D" CONSTRUCTION
	DENOTES INLET TREATMENT		
	DENOTES REINFORCED SILT FENCE		

- NOTES:**
- REFER TO SHEET 40 FOR CONSTRUCTION SEQUENCING NOTES.
 - REFER TO SHEET 43 AND 44 FOR EROSION CONTROL DETAILS.
 - ALL TRAFFIC CONTROL DEVICES AND LAYOUT SHALL CONFORM TO THE LATEST EDITION OF THE MANUAL ON UNIFORM TRAFFIC CONTROL DEVICES.
 - PROVIDE TRAFFIC CONTROL DEVICES TO DELINEATE TEMPORARY STEEP PAVEMENT EDGES.
 - UTILITY CROSSINGS OF EXISTING PAVEMENT WILL BE ALLOWED AS LONG AS TWO-WAY TRAFFIC IS KEPT IN SERVICE.

RECORD PLANS
12-17-2002

SCALE (feet)
0 40 80 120

PREPARED BY:
VIA WIER & ASSOCIATES, INC.
ENGINEERS SURVEYORS LAND PLANNERS
4300 BELLEVUE PLACE SUITE 130 ARLINGTON, TEXAS 76016 METRO (817)747-7700
4100 NORTH CARTER BLVD. SUITE 200 FORT WORTH, TEXAS 76105 METRO (817)365-9457

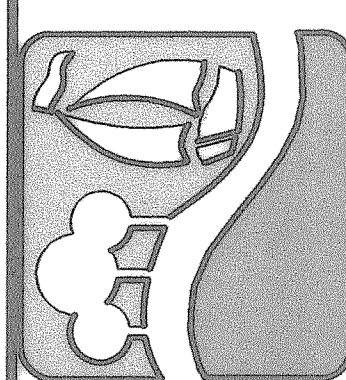

**CONSTRUCTION SEQUENCE
& EROSION CONTROL PLAN**
STA 74+00 TO END

STATE OF TEXAS
REGISTERED PROFESSIONAL ENGINEER
4086
4-2001

COPYRIGHT ©
WIER & ASSOCIATES, INC.
LAST SHEET EDIT
DATE: 04-18-2001
WAR 97057

SHEET NO.
38