



TIME: 14:27 FILE: Traffic7.dwg

PREPARED BY:
WIA WIER & ASSOCIATES, INC.
 ENGINEERS SURVEYORS LAND PLANNERS
 4320 BELLEVUE PLACE SUITE 130 ARLINGTON, TEXAS 76018 METRO (817)461-7700
 4108 AMAR CENTER BLDG. SUITE 200 FORT WORTH, TEXAS 76155 METRO (817)355-4457

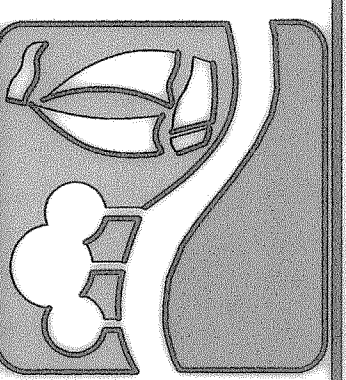

**CONSTRUCTION SEQUENCE
 & EROSION CONTROL PLAN
 S.H. 205 (GOLIAD STREET)**

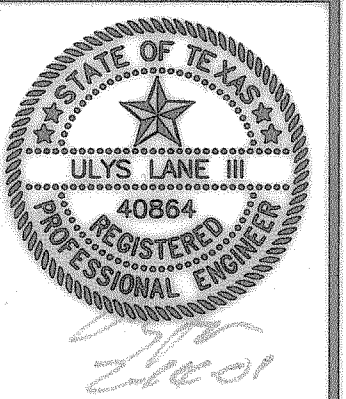

RECORD PLANS
 12-17-2002
 COPYRIGHT ©
 WIER & ASSOCIATES, INC.
 LAST SHEET EDIT
 DATE: 01-30-2001
 WA# 97057
SHEET NO. 39