

PHASE "A" CONSTRUCTION SEQUENCE

UTILITY CONSTRUCTION:

- A. INSTALL EROSION CONTROL FACILITIES.
- B. CONSTRUCT 12" WATER LINE ALONG RALPH HALL PARKWAY FROM MIMS ROAD TO EXISTING 6" WATER LINE ALONG S. H. 205 (GOLIAD STREET).
- C. CONSTRUCT INLETS "K-7", "K-9", "K-9.1", "L-5", "L-6", "L-6.1", "M-3", "M-4.5", "N-2", "N-2.1", AND "N-2.2".
- D. CONSTRUCT STORM DRAIN LINE "K", STORM DRAIN LINE "K-8", LATERALS "K-9" & "K-9.1", STORM DRAIN LINE "L", LATERALS "L-4", "L-5", "L-6" & "L-6.1", STORM DRAIN LINE "M", LATERALS "M-3", "M-4", AND "M-4.5". CONSTRUCT STORM DRAIN LATERAL "M-4" STA 0+00 TO 3+10. CONSTRUCT STORM DRAIN LINE "N" BY OPEN CUT AND TEMPORARY ASPHALT PATCH. CONSTRUCT LATERAL "N-2" BY OPEN CUT AND TEMPORARY ASPHALT PATCH. CONSTRUCT LATERALS "N-2.1" AND "N-2.2". CONSTRUCT DOWNSTREAM DITCH IMPROVEMENTS FOR STORM DRAIN LINES "K-8", "L" AND "M".

PAVEMENT CONSTRUCTION:

- A. INSTALL TRAFFIC CONTROL DEVICES.
- B. LIME STABILIZE AND COMPACT SUBGRADE.
- C. INSTALL STREET LIGHT AND IRRIGATION CONDUITS.
- D. CONSTRUCT REINFORCED CONCRETE PAVEMENT:
 - 1. EASTBOUND AND WESTBOUND LANES FOR RALPH HALL PARKWAY STA 55+35 TO 81+50.
 - 2. WESTBOUND LANES FOR RALPH HALL PARKWAY STA 82+18 TO S.H. 205.
 - 3. SOUTHBOUND WIDENING OF S.H. 205 FROM STA 459+00 TO 464+15
- E. INSTALL PAVESTONE MEDIAN CAPS.
- F. CLEAN UP, SOD PARKWAYS AND HYDROMULCH SEED CUT AND FILL SLOPES STA 55+35 TO S.H. 205 AND ALONG SOUTHBOUND WIDENING OF S.H. 205.
- G. FINAL CLEANUP, REMOVAL OF CONSTRUCTION SIGNS ALONG RALPH HALL PARKWAY. INSTALL TEMPORARY PAVEMENT MARKINGS ALONG WESTBOUND LANES TO PROVIDE FOR TWO-WAY TRAFFIC.
- H. OPEN WIDENED SOUTHBOUND S. H. 205 TO TRAFFIC.

PHASE "B" CONSTRUCTION SEQUENCE

UTILITY CONSTRUCTION:

- A. INSTALL EROSION CONTROL FACILITIES.
- B. CONSTRUCT INLET "M-4.3".
- C. CONSTRUCT STORM DRAIN LATERAL "M-4" STA 3+10 TO END AND LATERAL "M-4.3". CONSTRUCT STORM DRAIN LATERAL "M-4.4" STA 0+00 TO 0+17.

PAVEMENT CONSTRUCTION:

- A. INSTALL TRAFFIC CONTROL DEVICES.
- B. LIME STABILIZE AND COMPACT SUBGRADE FOR WEST ONE-HALF OF PLAZA DRIVE AND SOUTHBOUND WIDENING OF S.H. 205 FROM STA 455+75 TO 463+40.
- C. CONSTRUCT REINFORCED CONCRETE PAVEMENT:
 - 1. WEST ONE-HALF OF PLAZA DRIVE.
 - 2. SOUTHBOUND WIDENING OF S.H. 205 FROM STA 455+75 TO 463+40
- D. CONSTRUCT HANDICAP RAMP WEST CURB RETURN PLAZA DRIVE.
- E. CLEAN UP, SOD PARKWAYS AND HYDROMULCH SEED CUT AND FILL SLOPES.

PHASE "C" CONSTRUCTION SEQUENCE

UTILITY CONSTRUCTION:

- A. INSTALL EROSION CONTROL FACILITIES.
- B. CONSTRUCT INLET "M-4.4".
- C. CONSTRUCT STORM DRAIN LATERAL "M-4.4" STA 0+17 TO END.

PAVEMENT CONSTRUCTION:

- A. INSTALL TRAFFIC CONTROL DEVICES.
- B. LIME STABILIZE AND COMPACT SUBGRADE FOR EAST ONE-HALF OF PLAZA DRIVE.
- C. CONSTRUCT REINFORCED CONCRETE PAVEMENT FOR EAST ONE-HALF OF PLAZA DRIVE.
- D. CONSTRUCT HANDICAP RAMP EAST CURB RETURN PLAZA DRIVE.
- E. CLEAN UP, SOD PARKWAY AND HYDROMULCH SEED CUT AND FILL SLOPES.
- F. FINAL CLEANUP, REMOVAL OF CONSTRUCTION SIGNS ALONG RALPH HALL PARKWAY. INSTALL TEMPORARY PAVEMENT MARKINGS ALONG WESTBOUND LANES TO PROVIDE FOR TWO-WAY TRAFFIC.
- G. OPEN WESTBOUND LANES OF RALPH HALL PARKWAY TO TWO-WAY TRAFFIC.

PHASE "D" CONSTRUCTION SEQUENCE

UTILITY CONSTRUCTION:

- A. INSTALL EROSION CONTROL FACILITIES.
- B. CONSTRUCT INLETS "N-2.3".
- C. CONSTRUCT STORM DRAIN LATERAL "N-2.3".

PAVEMENT CONSTRUCTION:


- A. INSTALL TRAFFIC CONTROL DEVICES.
- B. LIME STABILIZE AND COMPACT SUBGRADE.
- C. INSTALL STREET LIGHT AND IRRIGATION CONDUITS.
- D. CONSTRUCT REINFORCED CONCRETE PAVEMENT FOR EASTBOUND LANES FOR RALPH HALL PARKWAY STA 81+50 TO S.H. 205.
- E. CONSTRUCT NEW CROSS ACCESS DRIVE BETWEEN LOT 1, BLOCK "B" AND LOT 1, BLOCK "C", ROCKWALL BUSINESS PARK EAST AND OPEN TO TRAFFIC PRIOR TO CLOSING EAST DRIVE APPROACH TO LOT 1, BLOCK "C" FOR RECONSTRUCTION.
- F. CONSTRUCT WEST DRIVE APPROACH TO LOT 1, BLOCK "C", ROCKWALL BUSINESS PARK EAST ONE-HALF AT A TIME TO KEEP DRIVE OPEN AT ALL TIMES.
- G. INSTALL PAVESTONE MEDIAN CAPS.
- H. CLEAN UP AND HYDROMULCH SEED CUT AND FILL SLOPES STA 81+50 TO S.H. 205 AND ALONG NORTHBOUND WIDENING OF S.H. 205.
- I. FINAL CLEANUP, REMOVAL OF CONSTRUCTION SIGNS ALONG RALPH HALL PARKWAY. REMOVE TEMPORARY PAVEMENT MARKERS AND INSTALL PERMANENT PAVEMENT MARKINGS.
- J. OPEN COMPLETED RALPH HALL PARKWAY AND S.H. 205.

NOTES:

- 1. ALL WORK, LABOR, MATERIALS AND EQUIPMENT REQUIRED FOR TEMPORARY TRAFFIC CONTROL INCLUDING GUARD RAILS, BARRICADES, SIGNAGE, ETC. SHALL BE CONSIDERED SUBSIDIARY TO OTHER PAY ITEMS.
- 2. ALL TRAFFIC CONTROL DEVICES AND LAYOUT SHALL CONFORM TO THE LATEST EDITION OF THE MANUAL ON UNIFORM TRAFFIC CONTROL DEVICES.
- 3. UTILITY CROSSINGS OF EXISTING PAVEMENT WILL BE ALLOWED AS LONG AS TWO-WAY TRAFFIC IS KEPT IN SERVICE.

TIME: 16:50 FILE: TRAFFICS.dwg

PREPARED BY:
WIA WIER & ASSOCIATES, INC.
 ENGINEERS SURVEYORS LAND PLANNERS
 4300 BELLEVUE PLACE SUITE 130 ARLINGTON, TEXAS 76010 METRO (817)747-7700
 4100 AMAR CENTER BLVD. SUITE 200 FORT WORTH, TEXAS 76105 METRO (817)365-0437

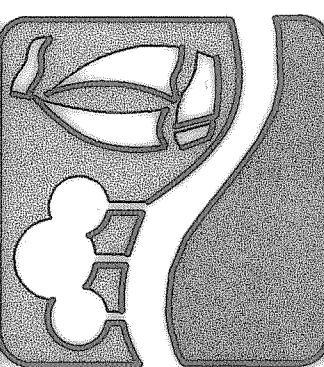

CONSTRUCTION SEQUENCE NOTES



COPYRIGHT ©
 WIER & ASSOCIATES, INC.
 LAST SHEET EDIT
 DATE 04-18-2001
 WAW 37057

RECORD PLANS
12-17-2002

SHEET NO.
40