




* LEGEND *


- A-1
14.62 DRAINAGE AREA DESIGNATION
DRAINAGE AREA SIZE (AC.)
- I DENOTES DESIGN POINTS
- PROPOSED INLET
- EXISTING STORM DRAIN LINE
- PROPOSED STORM DRAIN LINE
- DRAINAGE AREA DIVIDE
- DRAINAGE AREA SUBDIVIDE

TIME 17.154 FILE: dmap03.dwg

PREPARED BY:
WIA WIER & ASSOCIATES, INC.
 ENGINEERS SURVEYORS LAND PLANNERS
 4300 BELTWAY PLACE, SUITE 130 ARLINGTON, TEXAS 76016 METRO (817)467-7700
 4106 AMON CARRIER ROAD, SUITE 200 FORT WORTH, TEXAS 76155 METRO (817)355-9457

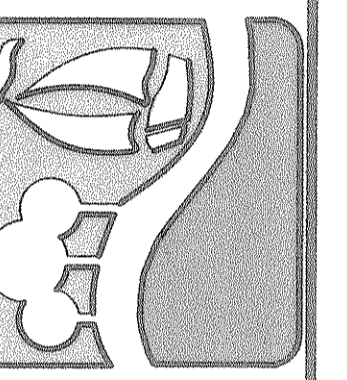

**DRAINAGE
 AREA MAP**

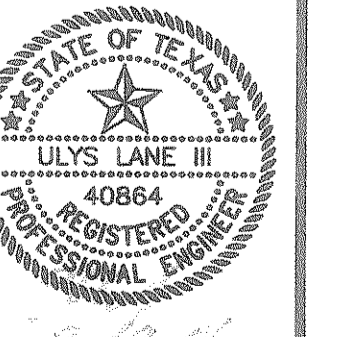

COPYRIGHT ©
 WIER & ASSOCIATES, INC.
 LAST SHEET EDIT
 DATE 01-26-2001
 WA# 97057

SHEET NO.
 16

