

CURVE C1531	CURVE C1532	CURVE C1538
A D R T L E	A D R T L E	A D R T L E
15°41'56"	30°45'35"	16°17'18"
38°11'50"	47°44'47"	38°11'50"
150.00	120.00	150.00
20.68	33.01	21.47
41.10	64.42	42.64
1.42	4.46	1.53

BENCHMARKS

GPS CONTROL MONUMENT #7 AT SOUTHEAST CORNER OF I-30 AND MIMS STREET.
ELEV. 566.25

BOX CUT IN THE NW CURB RETURN AT THE INTERSECTION OF WOODCREEK AND ROCKWALL PARKWAY.
ELEV. 528.53

LOT 1, BLOCK B
ROCKWALL BUSINESS PARK EAST
PHASE THREE
CAB. B, SLIDE 291
P.R.R.C.T.

INSTALL 22 S.Y. 8" TO 12" DIA. GROUDED HARD ROCK RUBBLE RIPRAP

TEMP. DRAIN. ES'MT.

SEE SHEET 22 FOR DITCH SECTION

PT1538
+21.18

STA 1+87.66 S.D. LINE "L"
=50.74' RT. ST. STA 75+04.58
PC1531

STA 1+97.22 S.D. LINE "L"
=STA 0+00.00 S.D. LAT. "L-6"
=41.53' RT. ST. STA 75+02.07

STA 0+31.48 S.D. LAT. "L-6"
=STA 0+00.00 S.D. LAT. "L-6.1"
=19.62' RT. ST. STA 75+24.68

STA 0+57.52 S.D. LAT. "L-6.1"
=35.38' RT. ST. STA 75+80.00

=34.00' RT. ST. STA 75+85.00
CONST. 10' REC. CURB INLET
TOP = 530.51
E = 525.51

STA 3+27.09 S.D. LINE "L"
=STA 0+00.00 S.D. LAT. "L-3"
=7.52' LT. ST. STA 0+73.08
TEMP. CONST. ES'MT.

STA 3+16.83 S.D. LINE "L"
=STA 0+00.00 S.D. LAT. "L-4"
=2.51' LT. ST. STA 0+64.13

STA 2+72.91 S.D. LINE "L"
=STA 0+00.00 S.D. LAT. "L-5"
=26.00' LT. ST. STA 74+68.12

RALPH HALL PARKWAY

STA 0+12.98 S.D. LAT. "L-3"
=20.50' LT. ST. STA 0+73.25

=20.50' LT. ST. STA 0+77.00
FUTURE 15' CURB INLET
TOP = 532.65
E = 528.15

STA 0+10.64 S.D. LAT. "L-4"
=STA 0+00.00 S.D. LAT. "L-4.2"
=2.54' RT. ST. STA 0+73.49

TEMP. DRAIN. ES'MT.

LOT 1, BLOCK C
ROCKWALL BUSINESS PARK EAST
PHASE THREE
CAB. B, SLIDE 291
P.R.R.C.T.

STA 3+35.00 S.D. LINE "L"
=11.39' LT. ST. STA 0+79.98
CONSTRUCT HEADWALL & RIPRAP
PER DETAIL SHEET 56B.

STA 0+64.68 S.D. LAT. "L-4"
=14.50' RT. ST. STA 1+25.72
PT1532

MAYFAIR DRIVE



STA 0+17.96 S.D. LAT. "L-4.2"
=20.50' RT. ST. STA 0+73.25
FUTURE 15' CURB INLET
TOP = 532.20
E = 527.70

STA 2+28.76 S.D. LINE "L"
=12.56' RT. ST. STA 74+89.72
PT1531

STA 1+08.53 S.D. LAT. "L-6"
=34.00' LT. ST. STA 75+80.00


LOT 1, BLOCK A
ROCKWALL BUSINESS PARK EAST
PHASE THREE
CAB. B, SLIDE 291
P.R.R.C.T.

=34.00' LT. ST. STA 75+85.00
CONST. 20' REC. CURB INLET
TOP = 530.51
E = 525.51

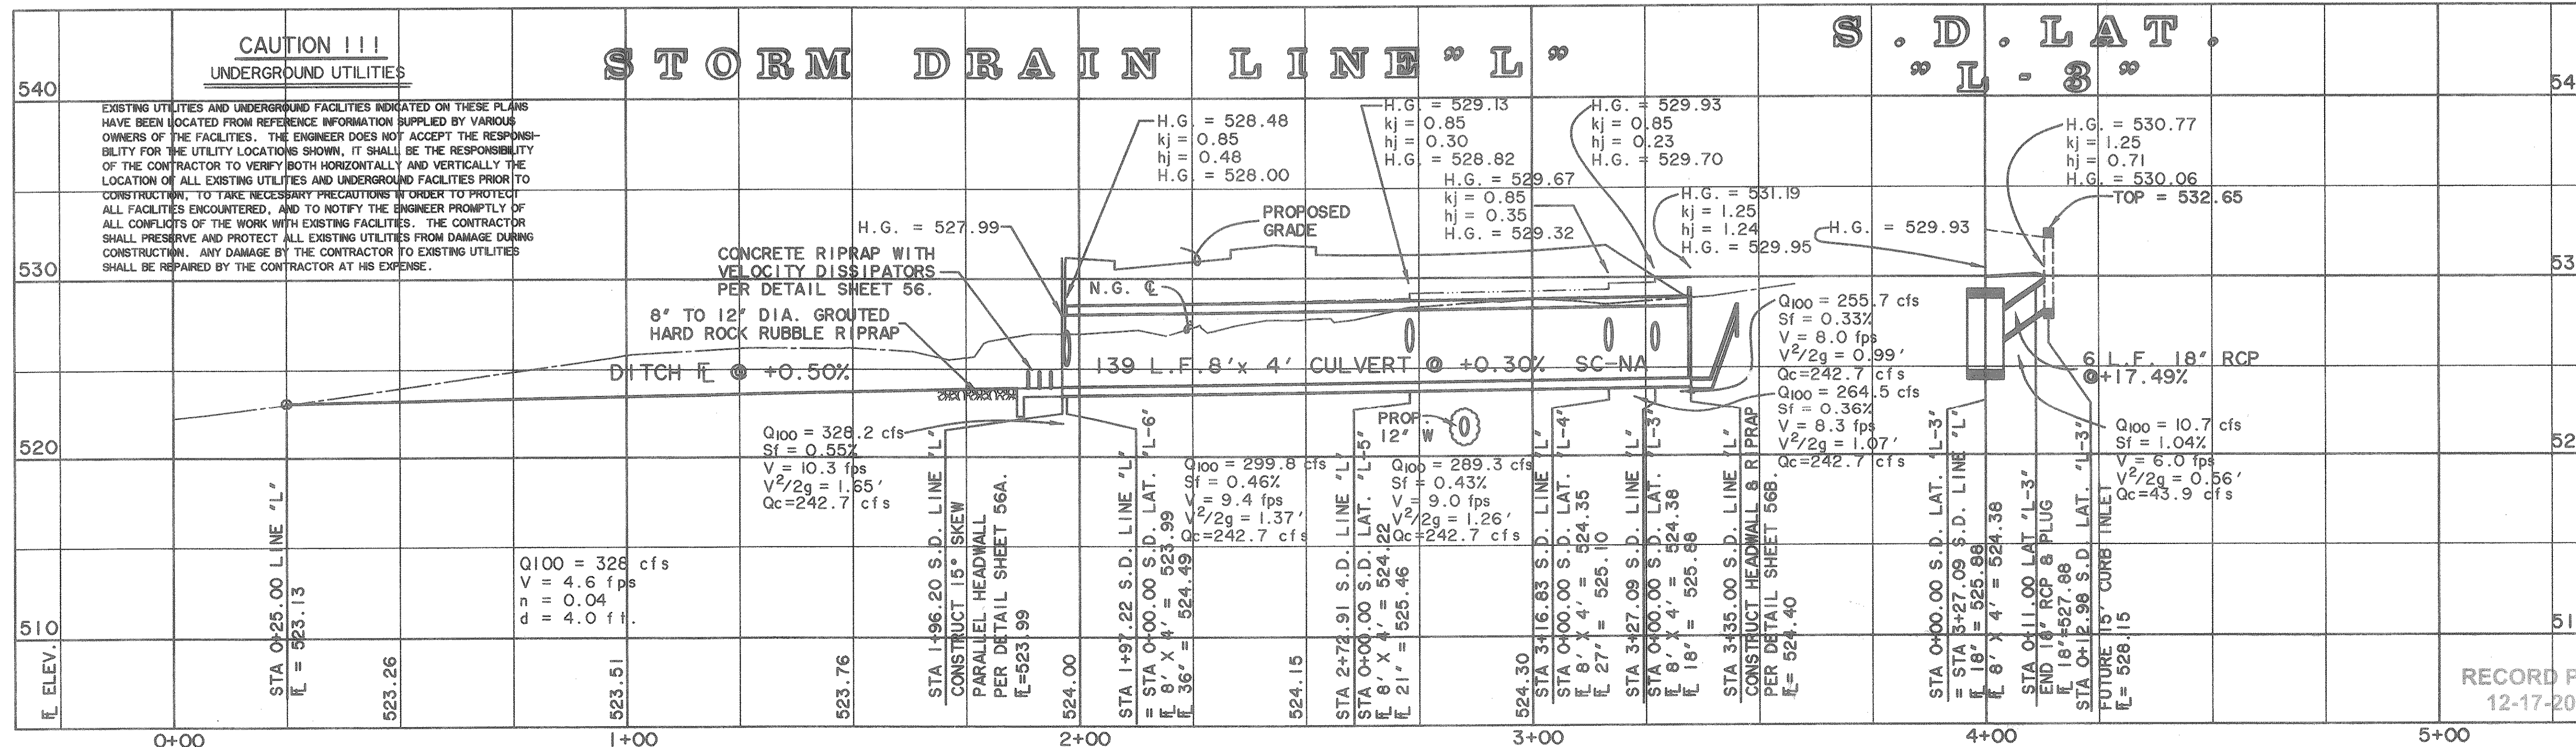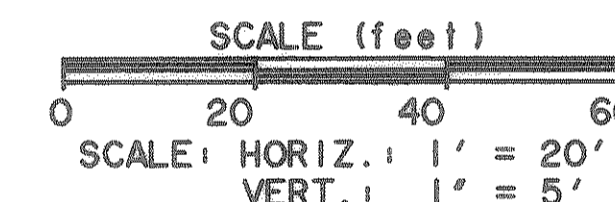


TIME: 7:20 FILE: SDPP24.dwg

PREPARED BY:
VIA WIER & ASSOCIATES, INC.
ENGINEERS SURVEYORS LAND PLANNERS
4300 BELTWAY PLACE SUITE 130 ARLINGTON, TEXAS 76010 METRO (817)461-7700
4100 MIMM CREEK BLVD. SUITE 200 FORT WORTH, TEXAS 76155 METRO (817)355-9437

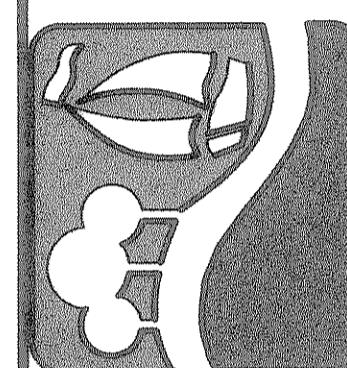

STORM DRAIN LINE "L"
PLAN & PROFILE
STA 0+00 TO END

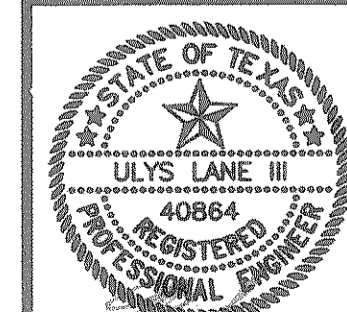

COPYRIGHT ©
WIER & ASSOCIATES, INC.
LAST SHEET EDIT
DATE: 02-09-2001
WAW 97057

RECORD PLANS
12-17-2002

SHEET NO.
23