




TIME: 11:19 FILE: SDPPSO.dwg

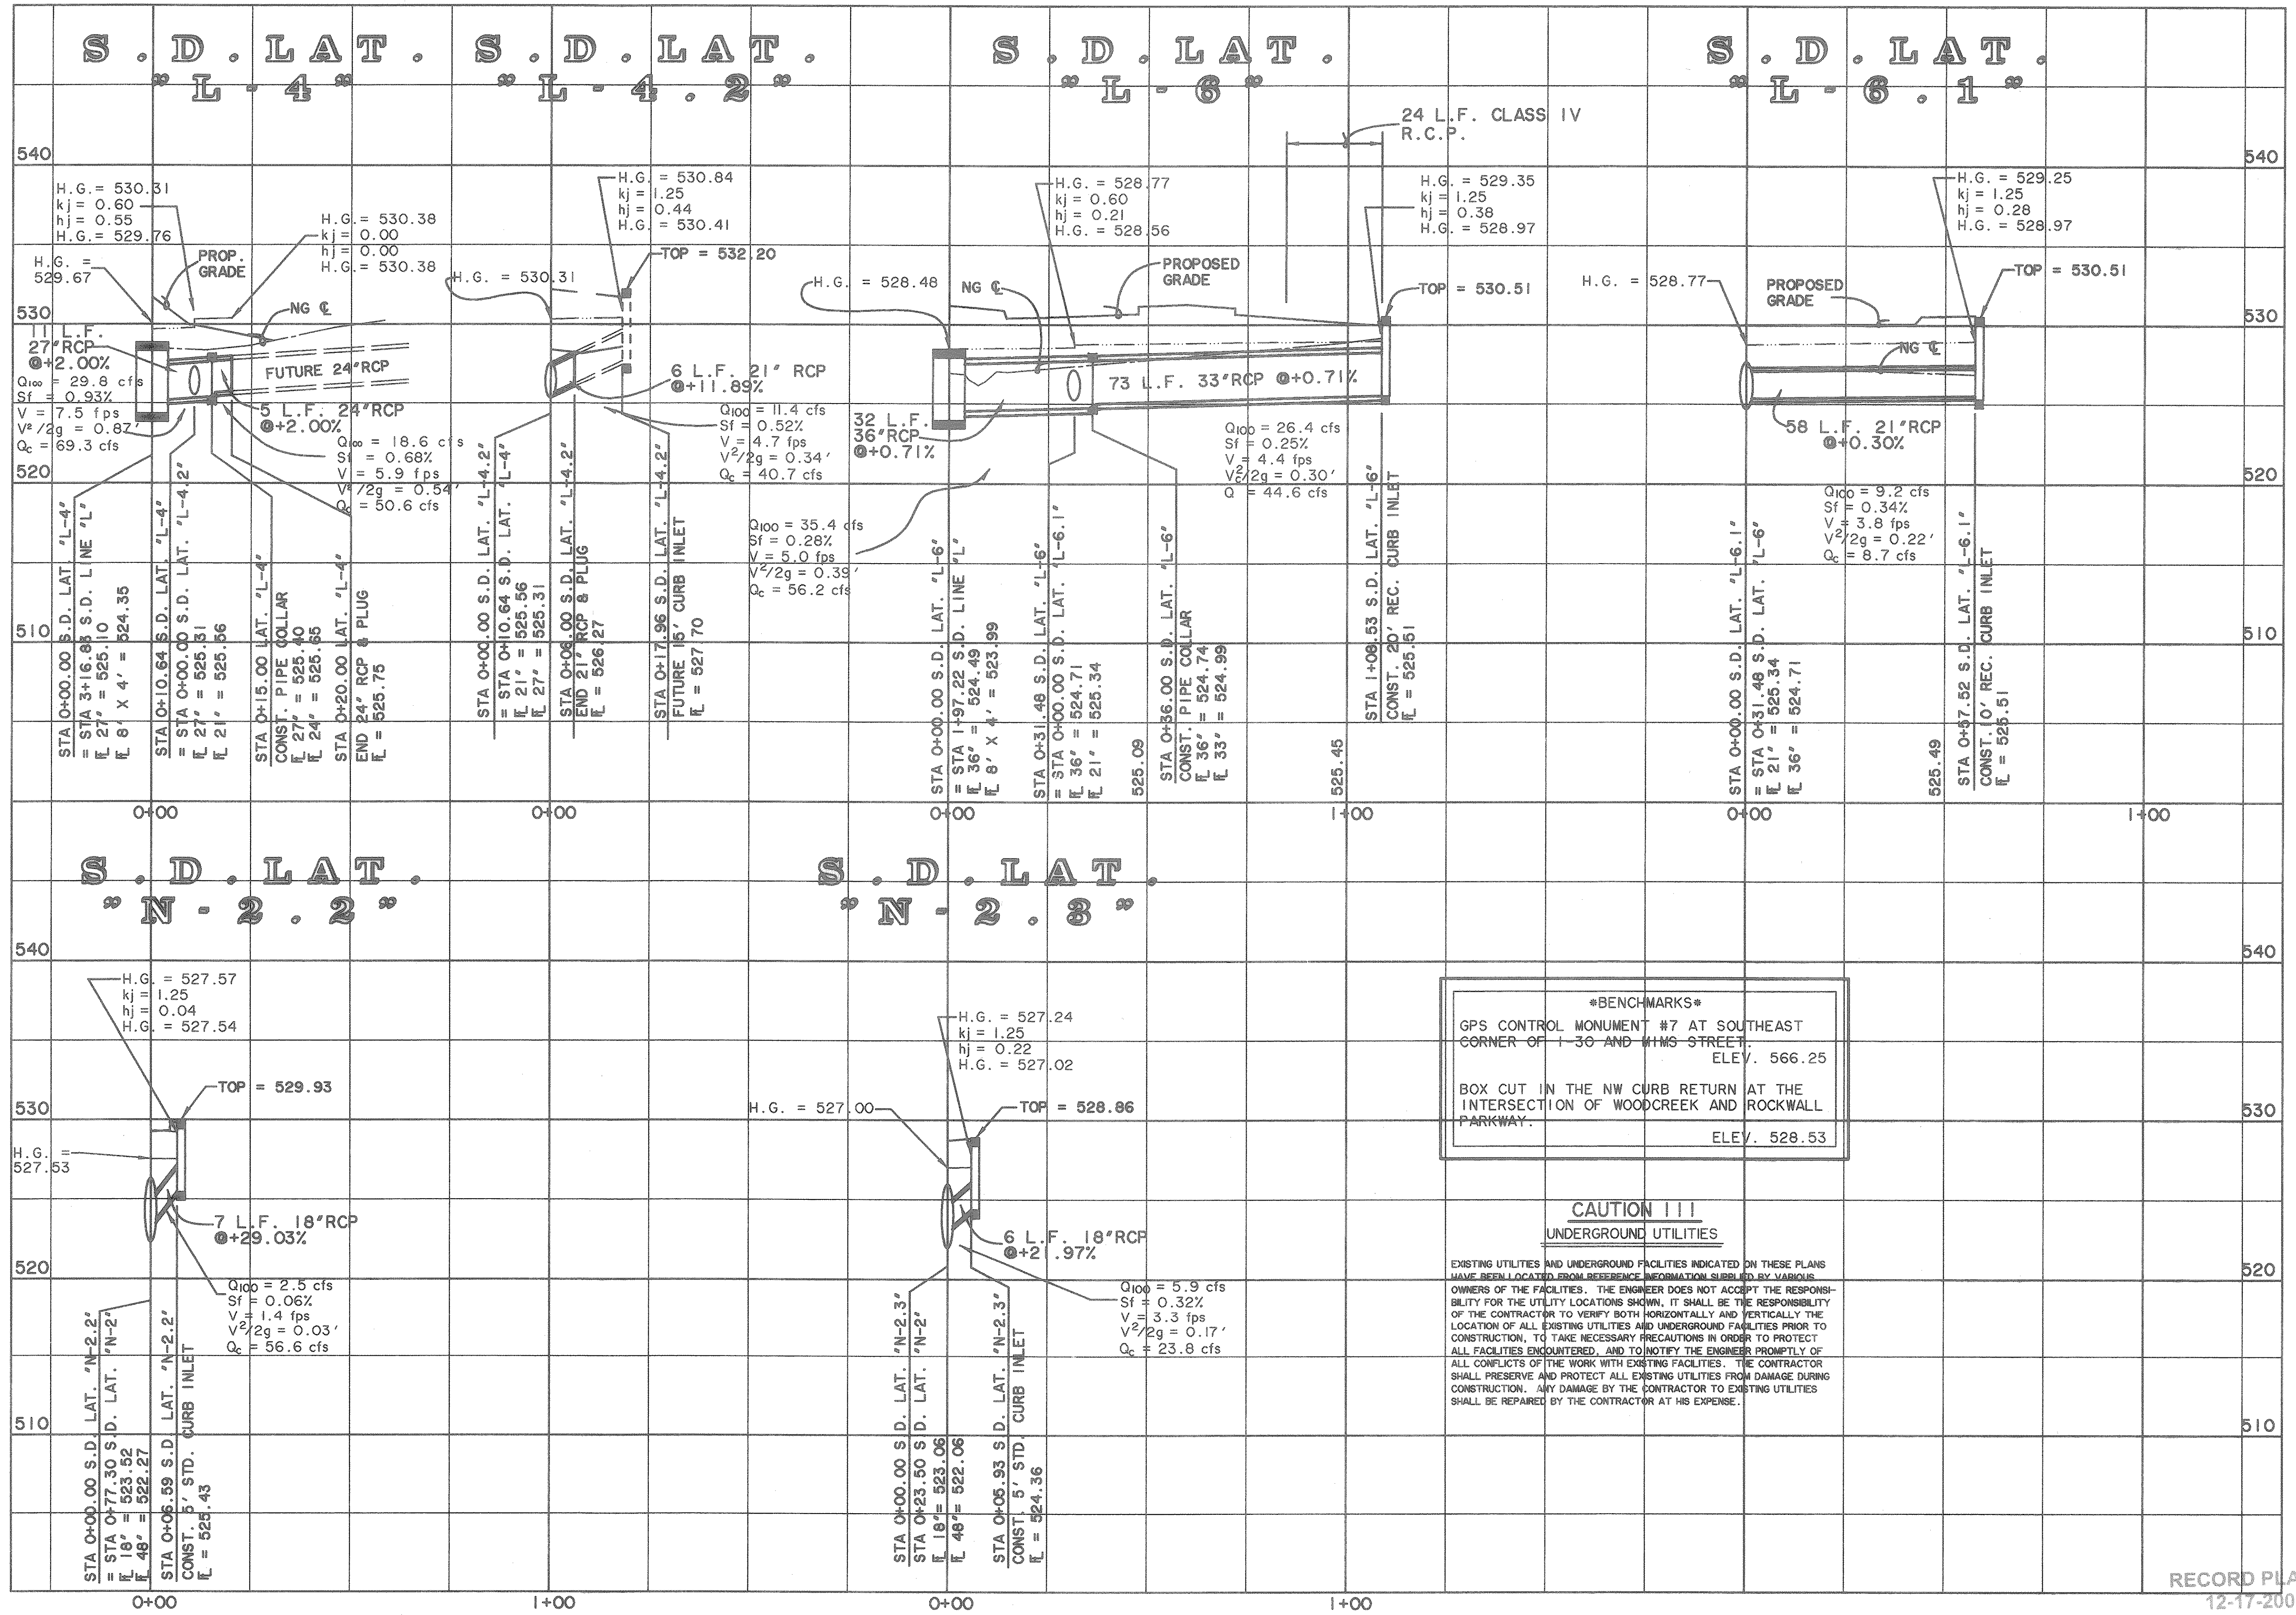

PREPARED BY:
VIA WIER & ASSOCIATES, INC.
 ENGINEERS SURVEYORS LAND PLANNERS
 4300 BELLEVUE PLACE SUITE 130 ARLINGTON, TEXAS 76018 METRO (817)767-7700
 4100 NORTH CARRIER ROAD SUITE 200 FORT WORTH, TEXAS 76155 METRO (817)355-937

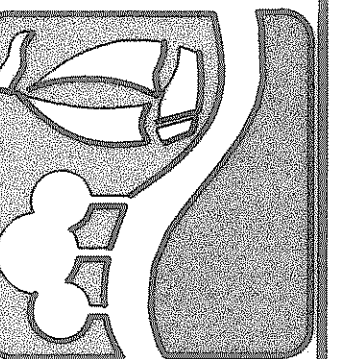

**STORM DRAIN
 LATERAL PROFILES**

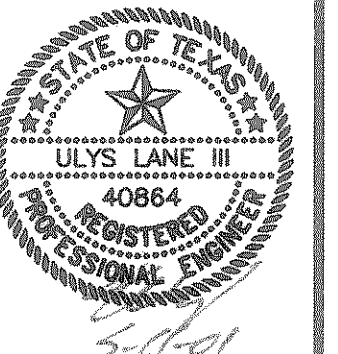

COPYRIGHT ©
 WIER & ASSOCIATES, INC.
 LAST SHEET EDIT
 DATE 06-11-2001
 WA# 97057

SHEET NO. 29

RECORD PLANS
 12-17-2002