



TIME: 7:43 FILE: STRPEZ.dwg

PREPARED BY:
WIA WIER & ASSOCIATES, INC.
 ENGINEERS SURVEYORS LAND PLANNERS
 4300 DELWAY PLACE, SUITE 130 ARLINGTON, TEXAS 76010 METRO (817) 467-7700
 4106 AMON CREEK BLVD. SUITE 200 FORT WORTH, TEXAS 76155 METRO (817) 385-9457

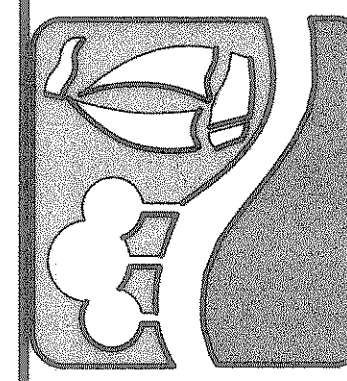

**RALPH HALL PARKWAY
 STRIPING PLAN**
 STA 54+00 TO 74+00

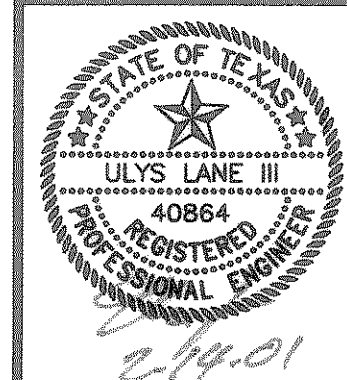

COPYRIGHT ©
 WIER & ASSOCIATES, INC.
 LAST SHEET EDIT
 DATE 01-26-2001
 WA# 97087
SHEET NO. 13