




MATCH LINE STA 74+00




MATCH LINE STA 84+00

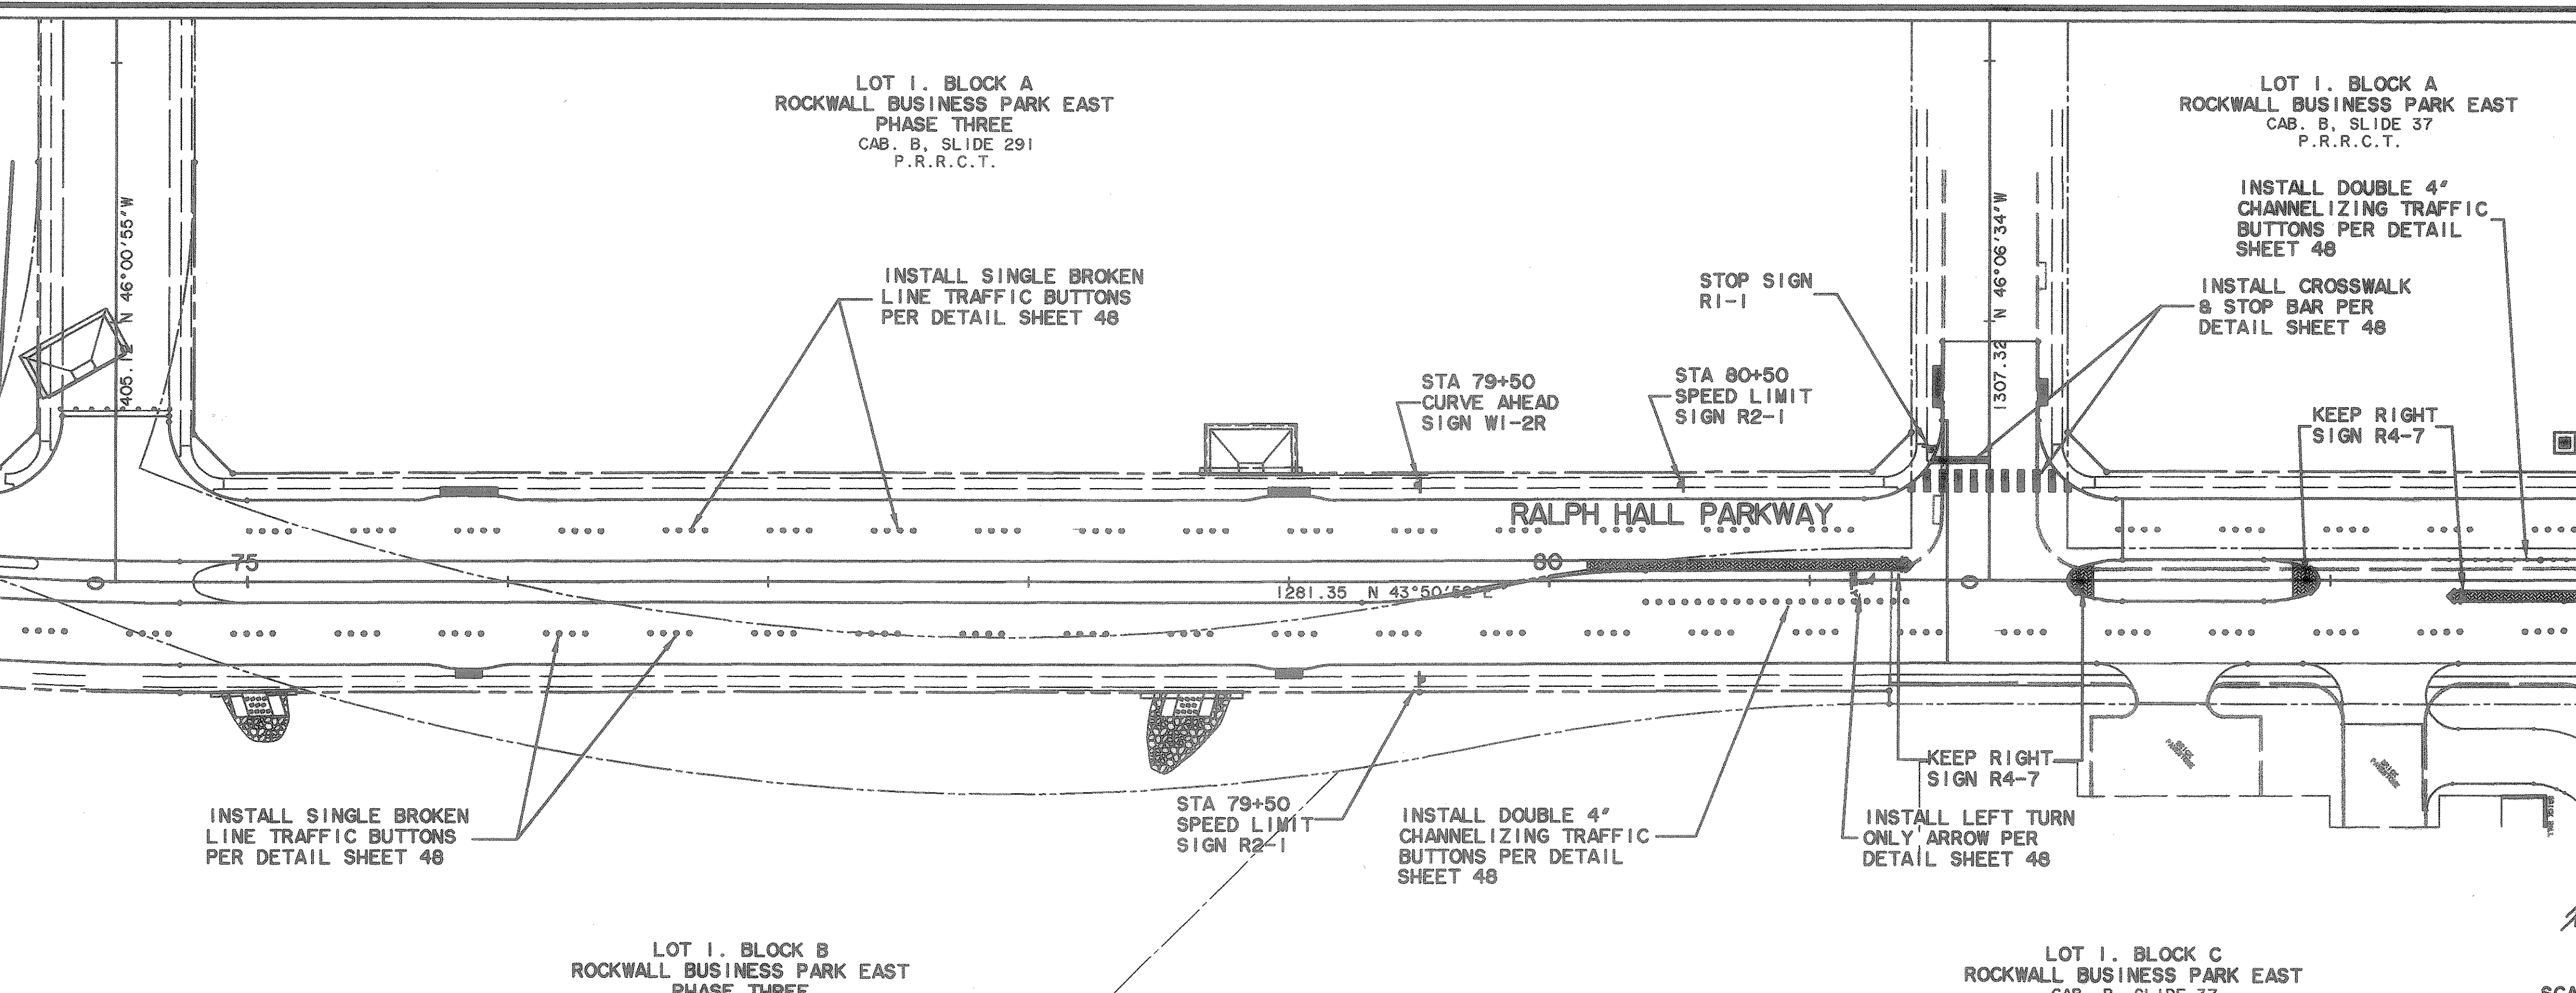

MATCH LINE STA 84+00

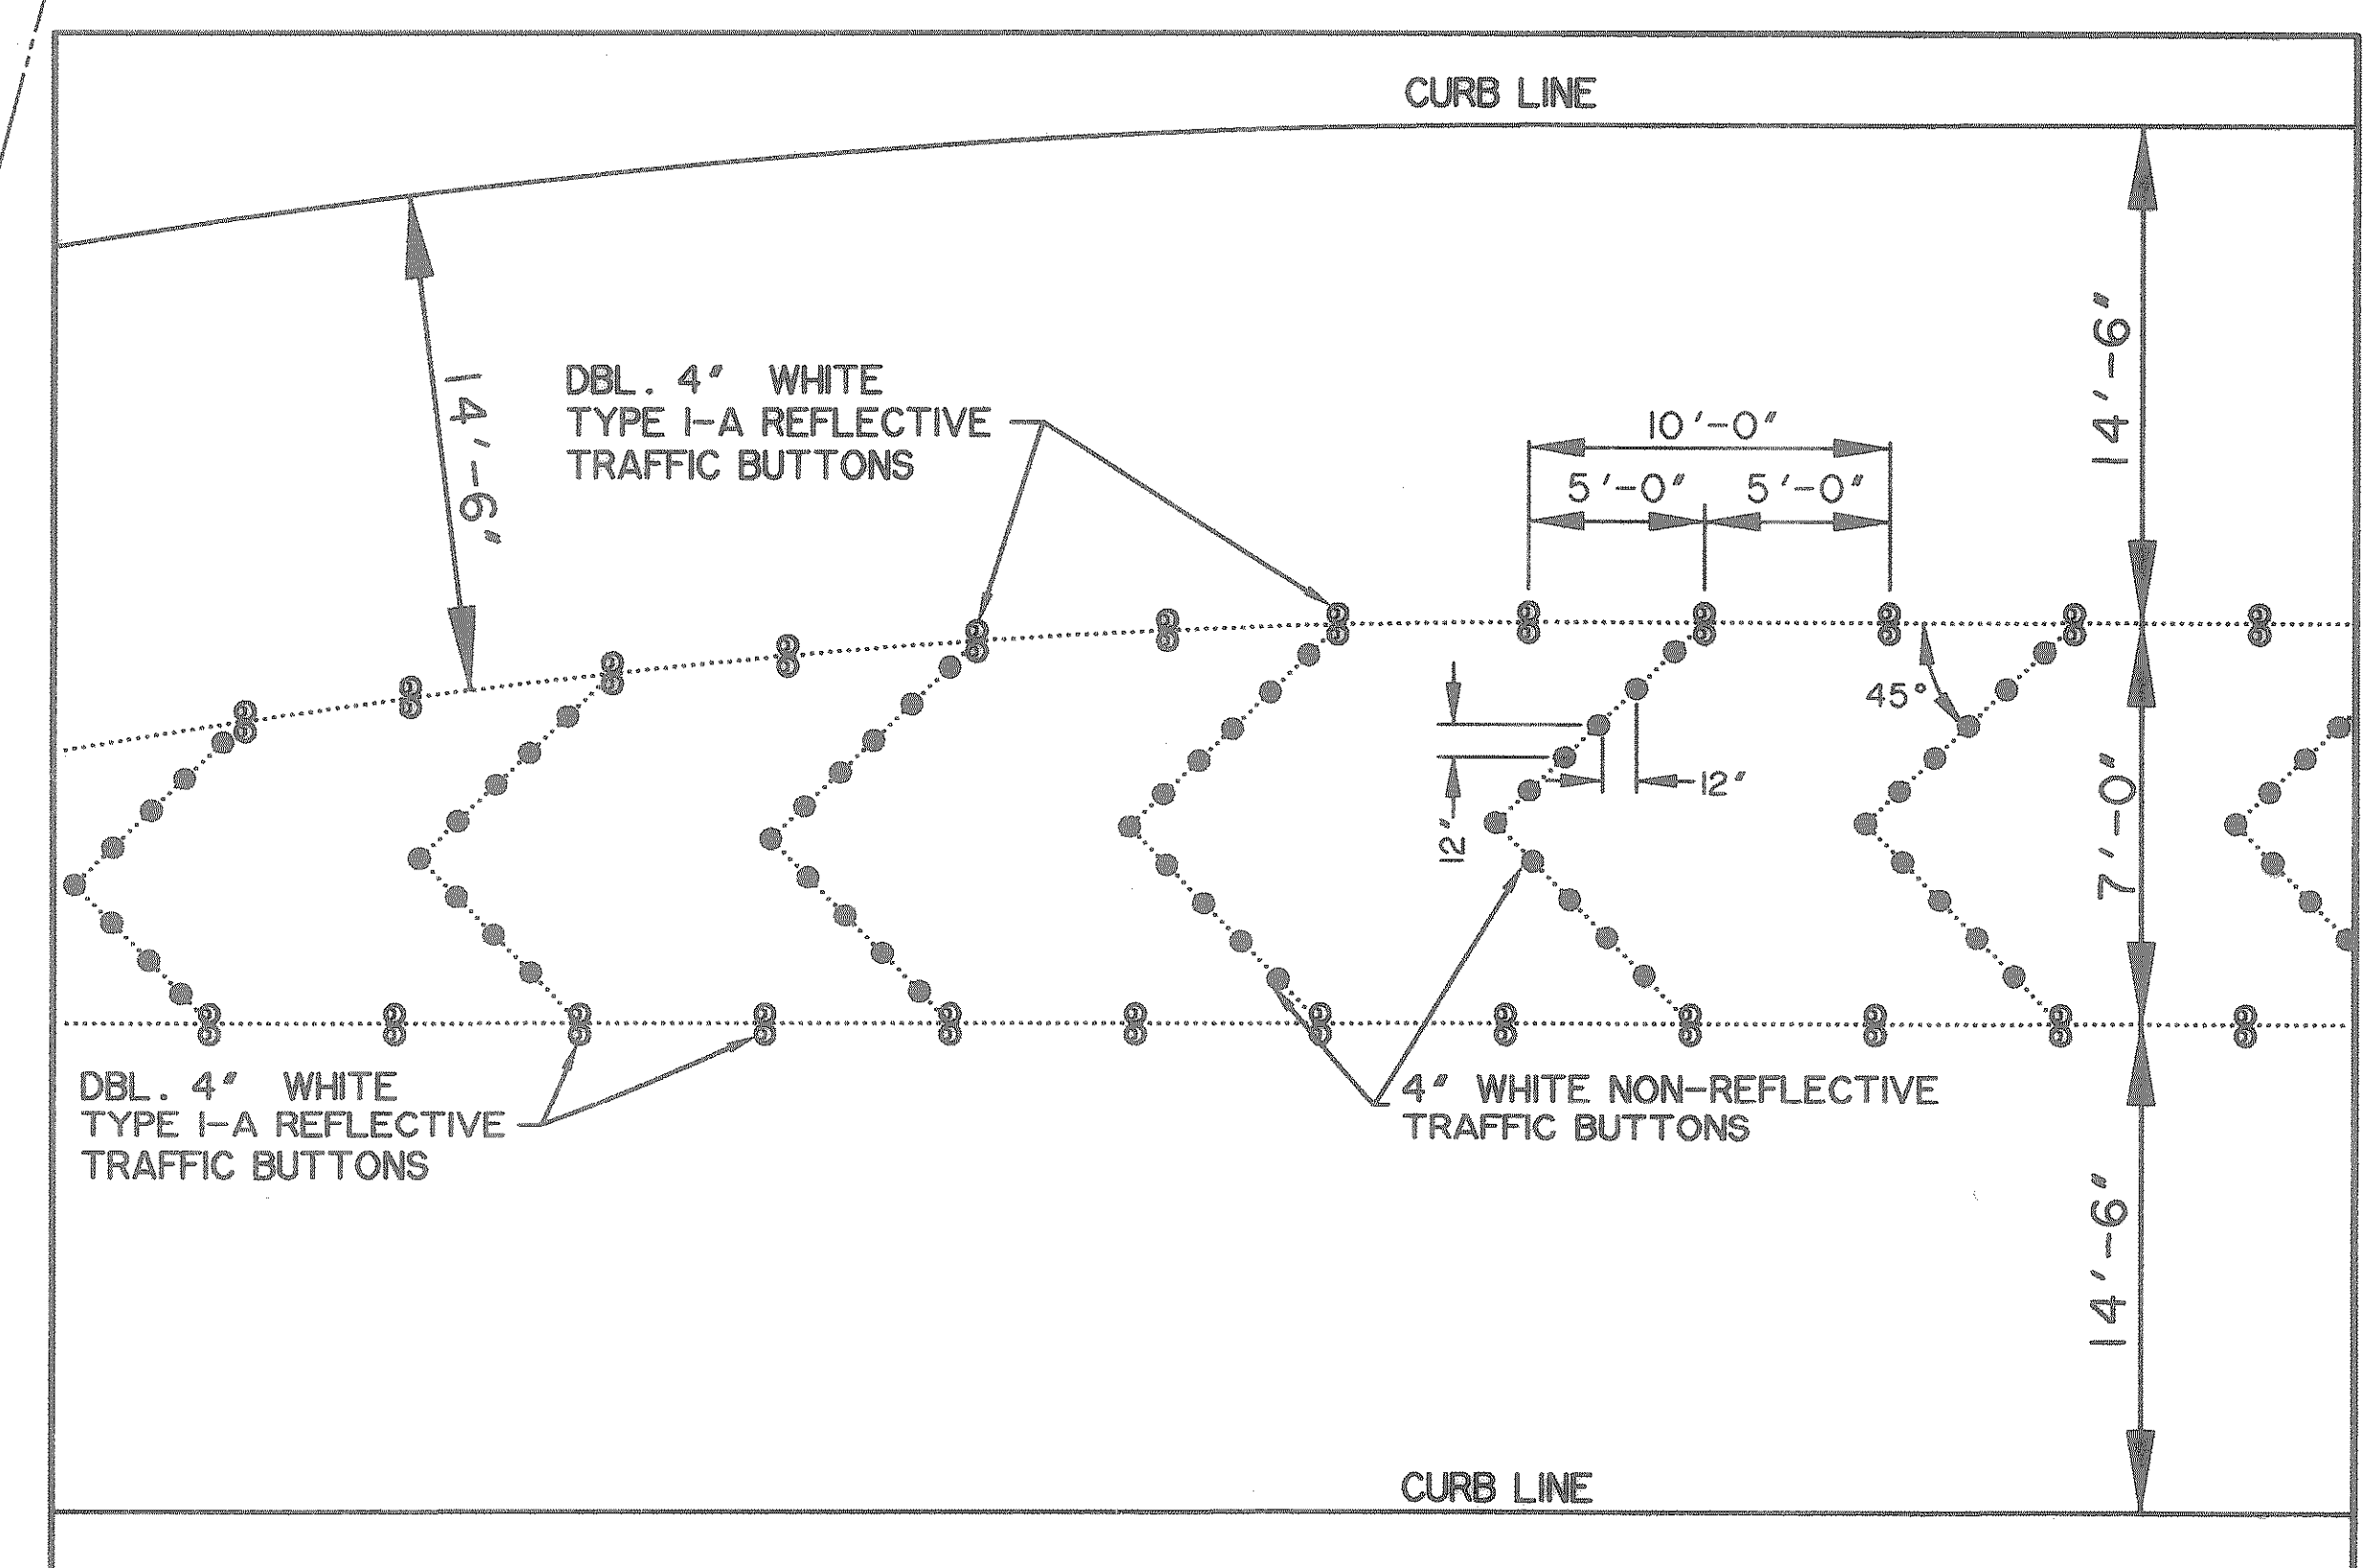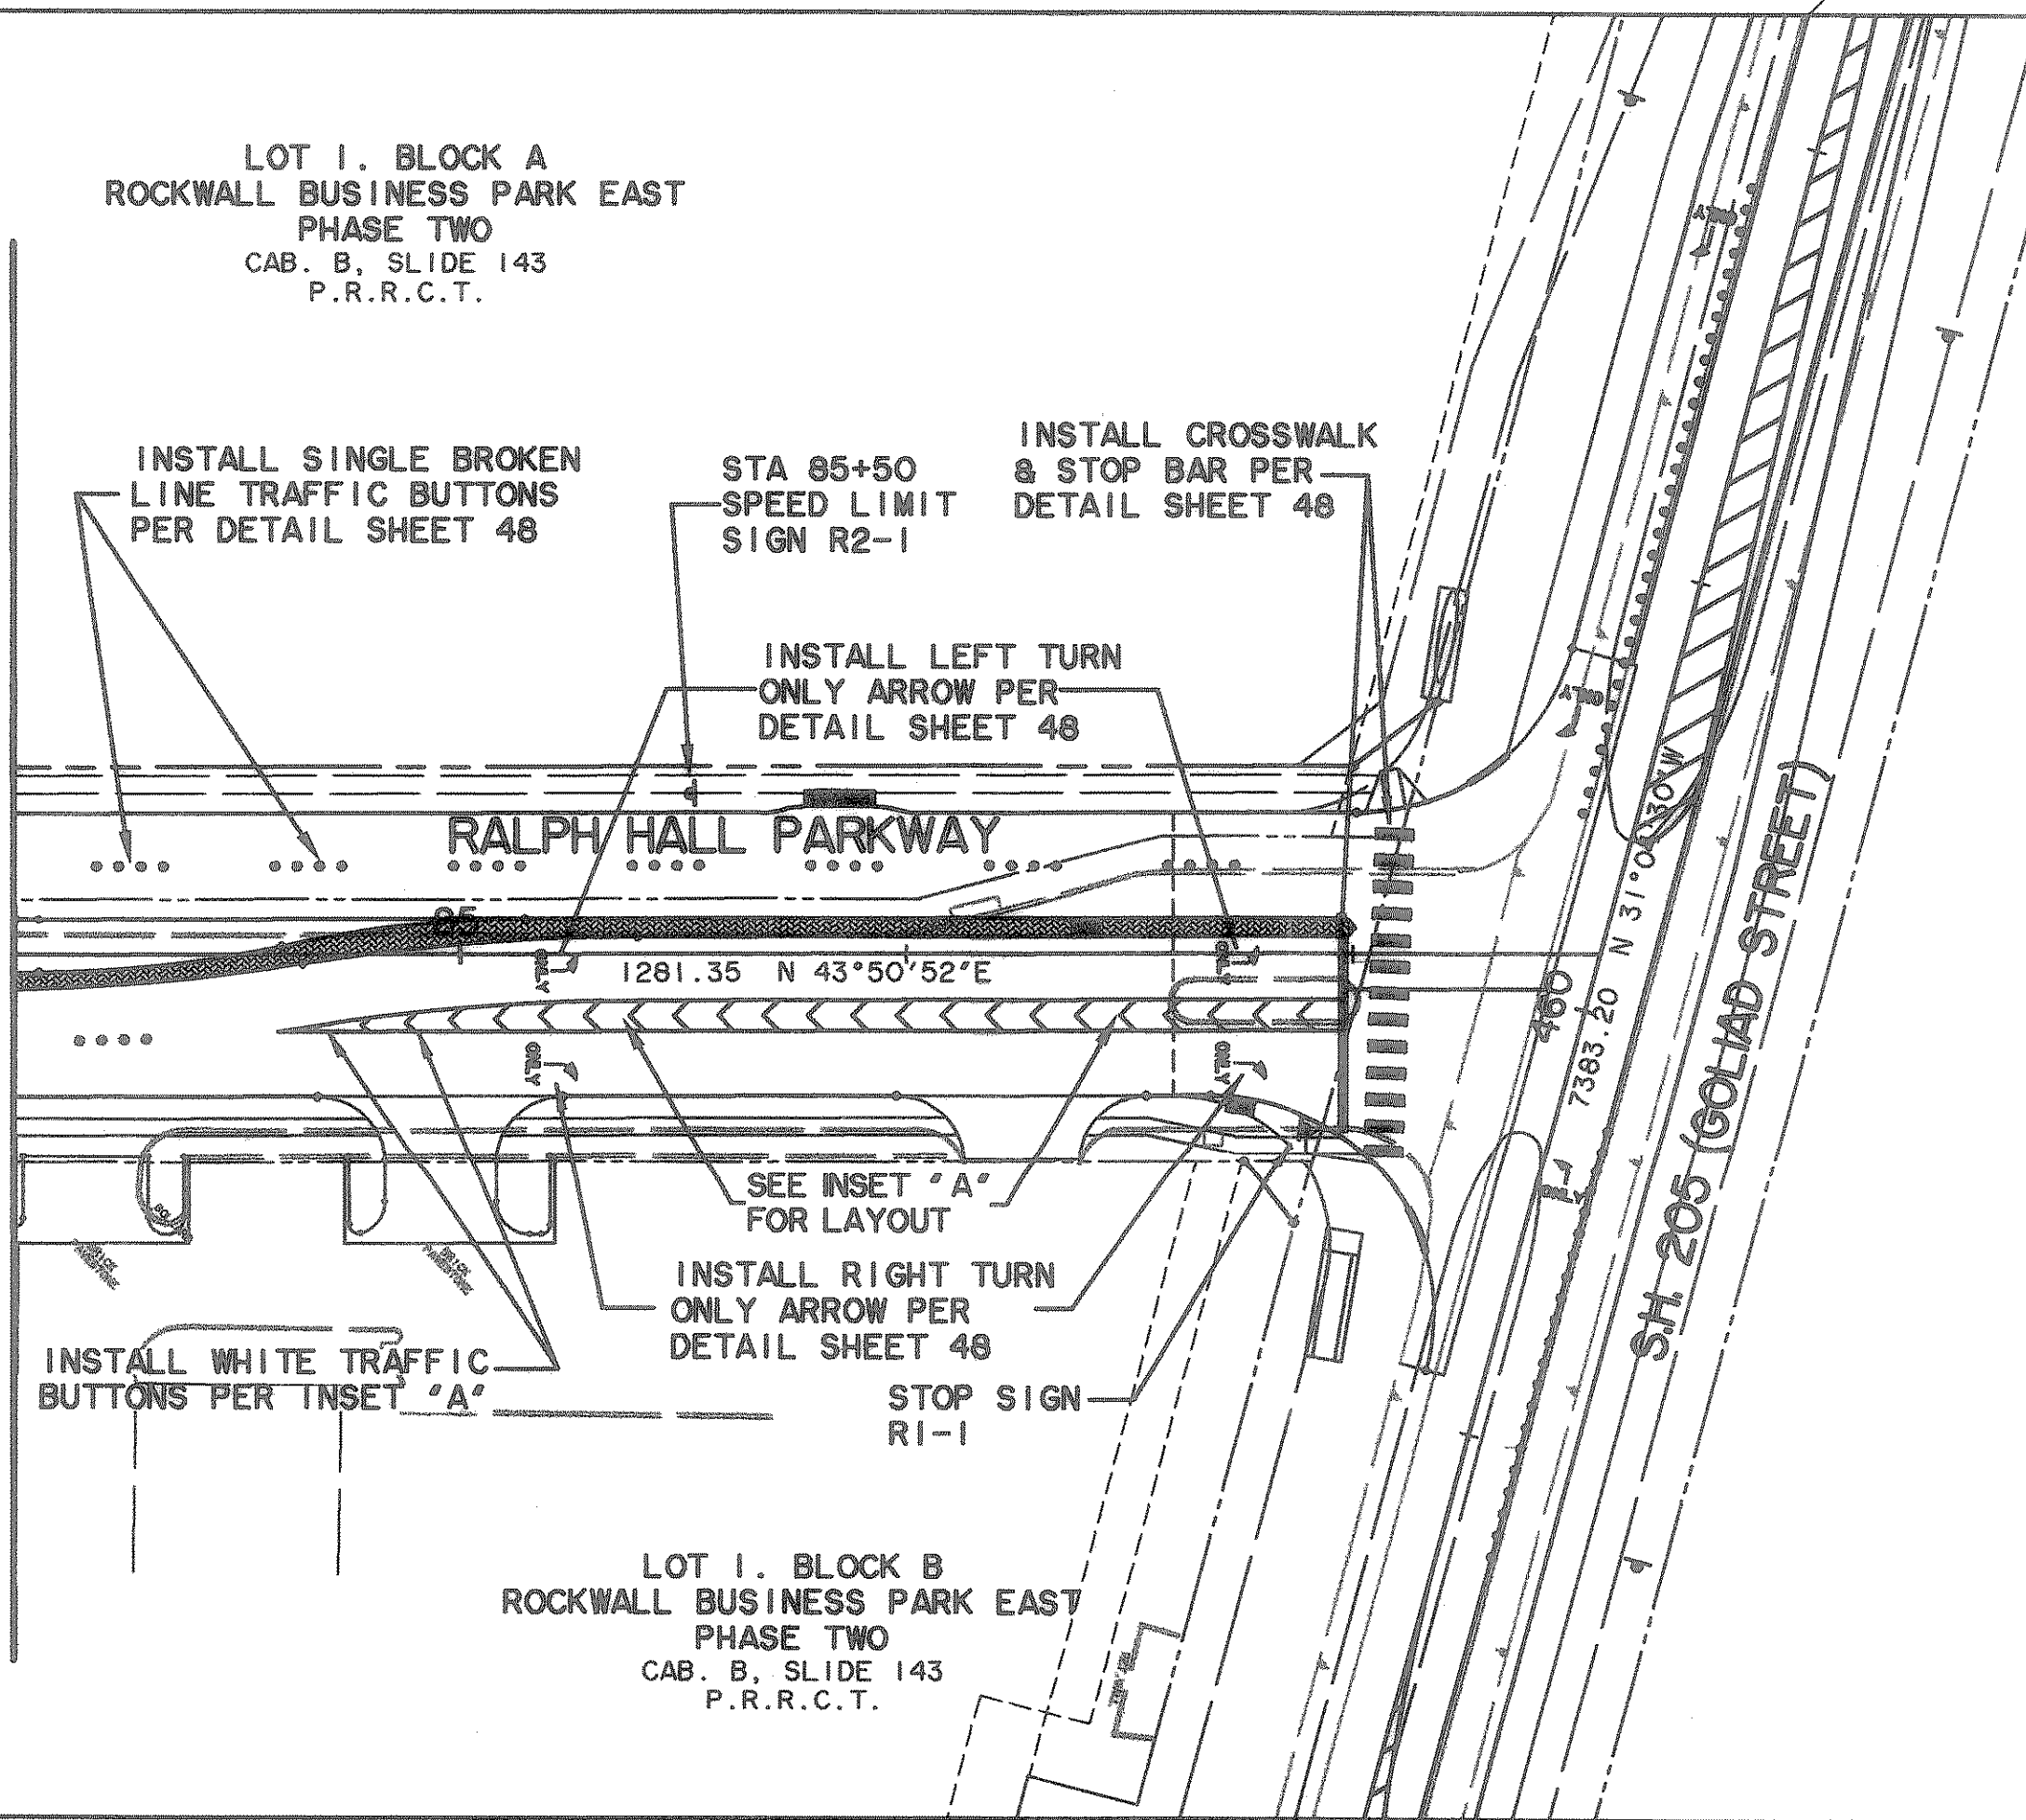


INSET "A" N.T.S.

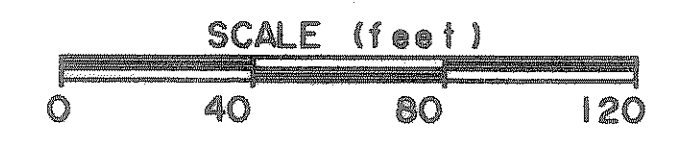


TIME: 11:23 FILE: stripe3.dwg

PREPARED BY:
VIA WIER & ASSOCIATES, INC.
 ENGINEERS SURVEYORS LAND PLANNERS
 4300 RETIRED PLACE SUITE 130 ARLINGTON, TEXAS 76010 METRO (817)467-7700
 4100 AMAR CORNER BLVD. SUITE 200 FORT WORTH, TEXAS 76115 METRO (817)365-9457

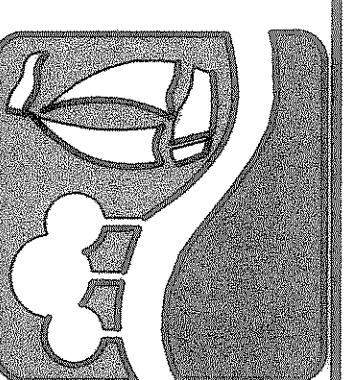

RALPH HALL PARKWAY
STRIPING PLAN
 STA 74+00 TO END

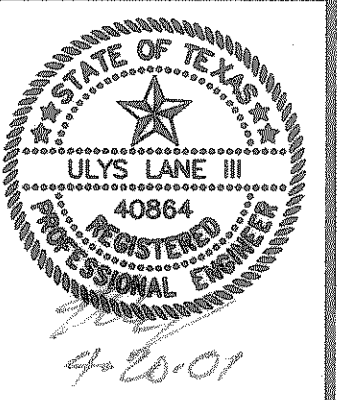

RECORD PLANS
 12-17-2002
 COPYRIGHT ©
 WIER & ASSOCIATES, INC.
 LAST SHEET EDIT
 DATE 04-17-2001
 WAW 97057
SHEET NO.
14