

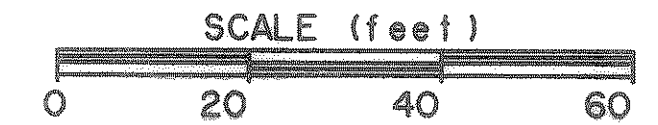
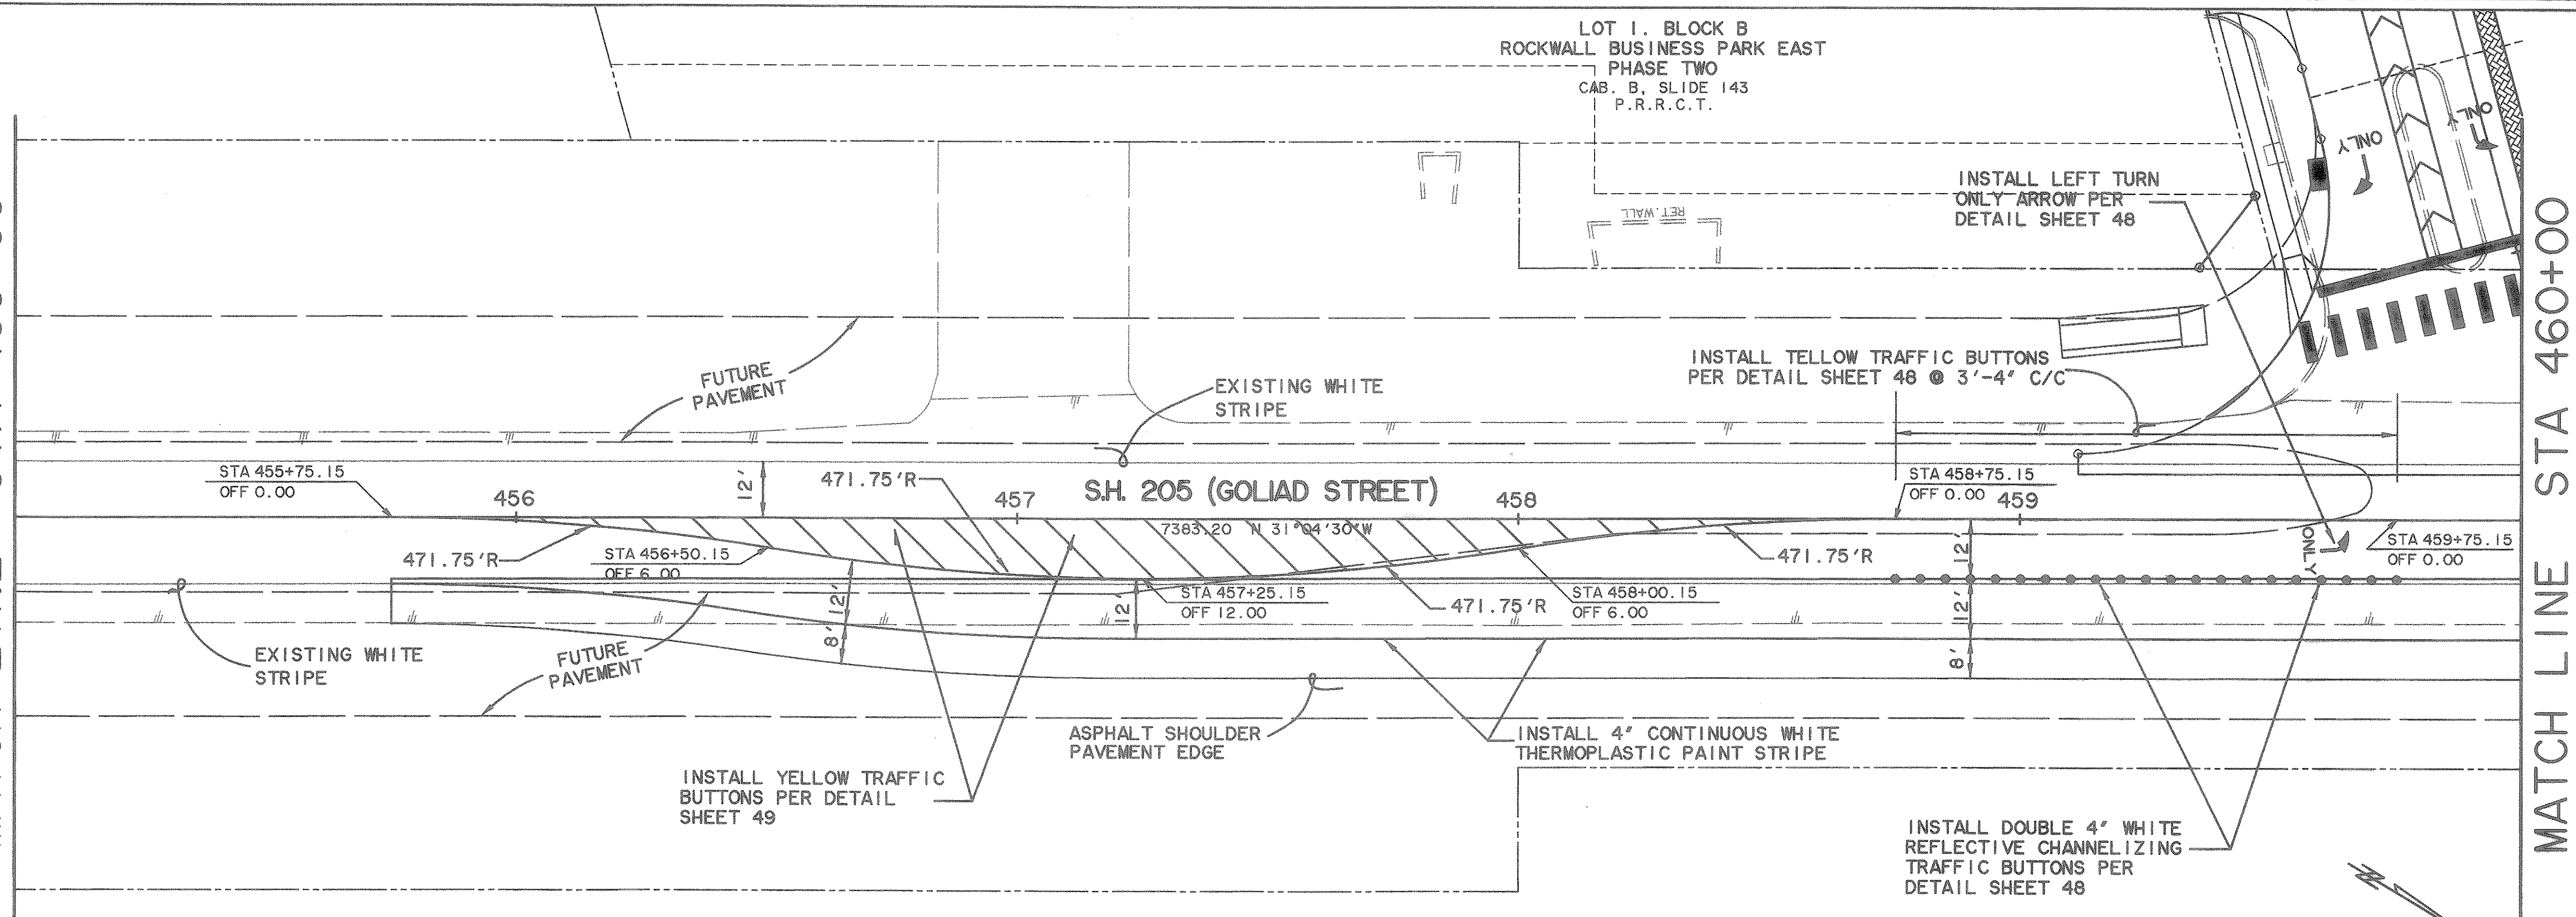


TIME 17.56
FILE STRIPE4.dwg

MATCH LINE STA 455+00

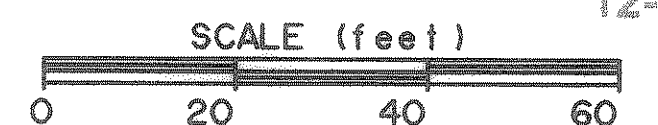

MATCH LINE STA 460+00

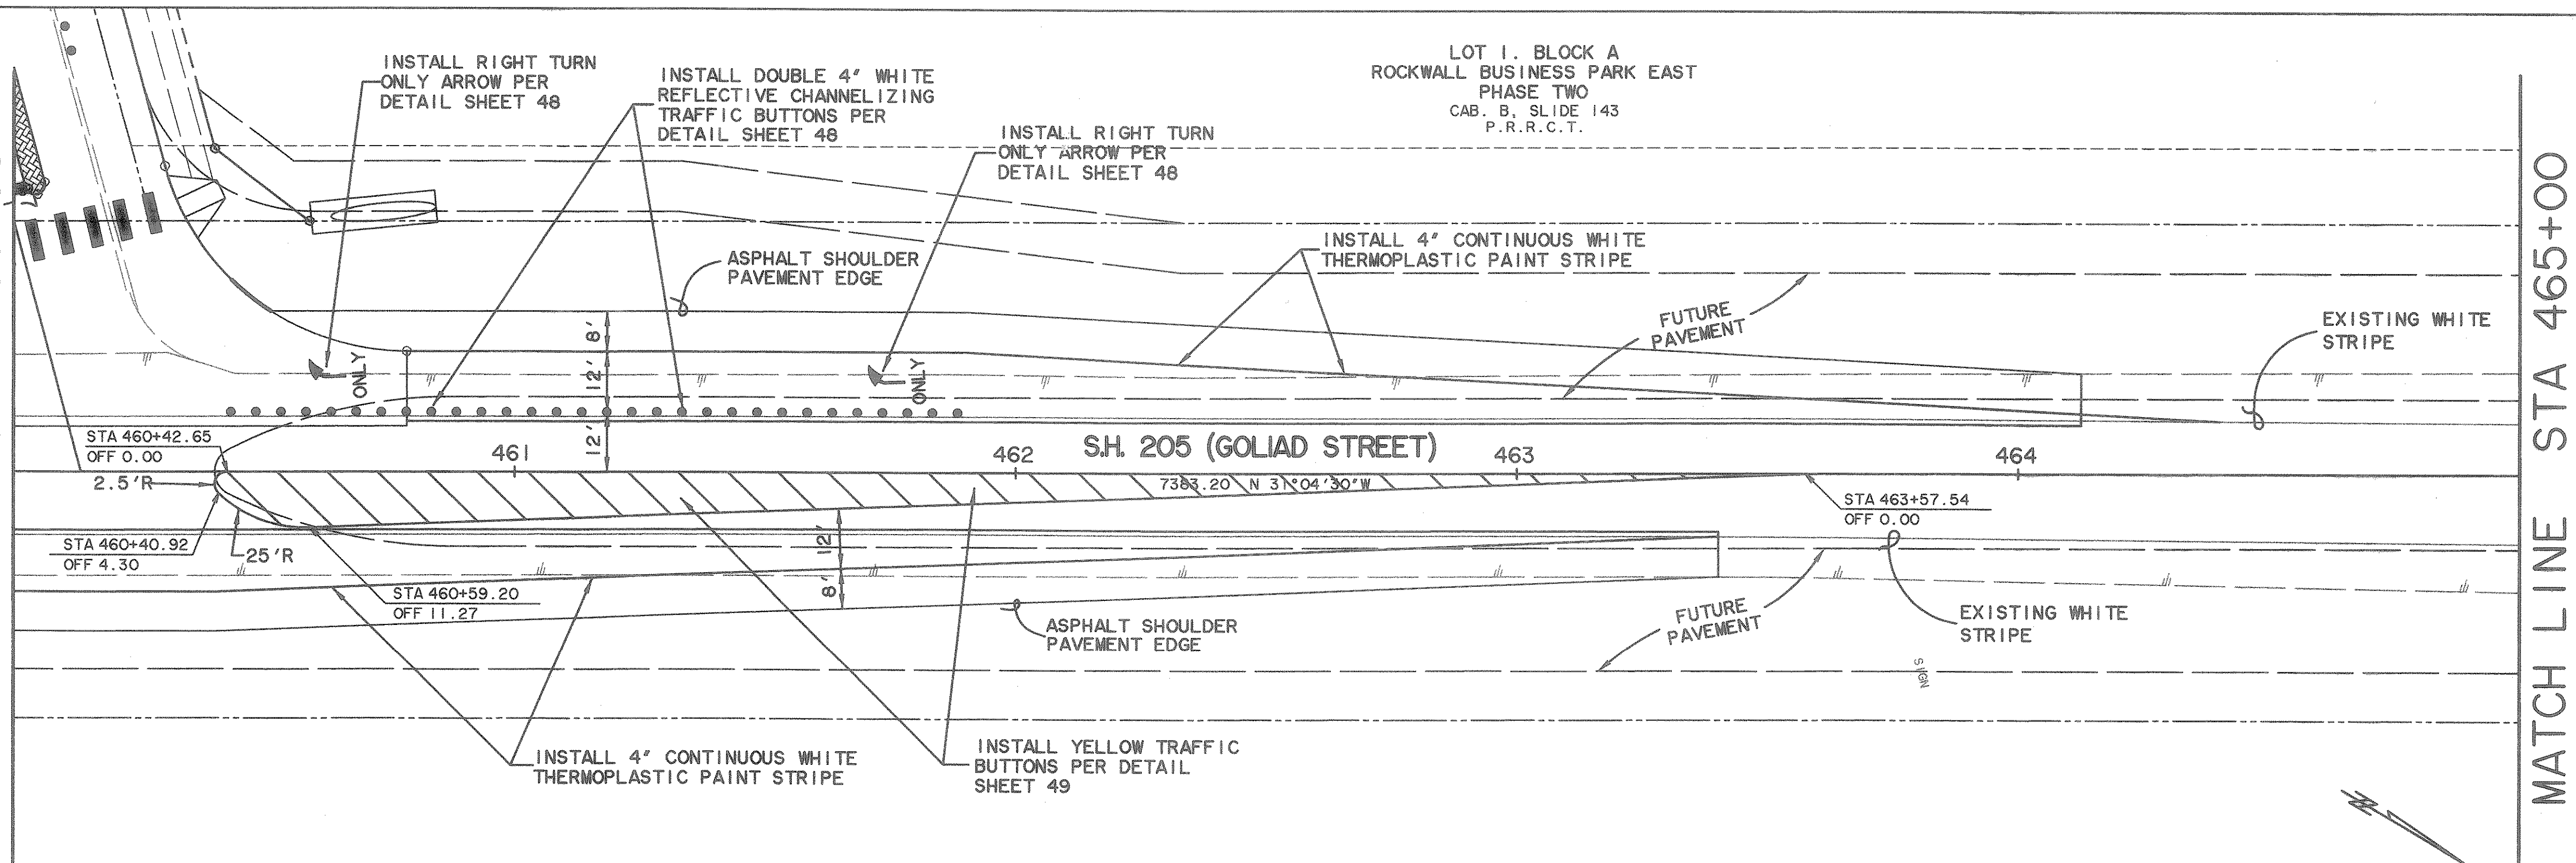


RECORD PLANS
12-17-2002


LOT I, BLOCK B
ROCKWALL BUSINESS PARK EAST
PHASE TWO
CAB. B, SLIDE 143
P.R.R.C.T.

LOT I, BLOCK A
ROCKWALL BUSINESS PARK EAST
PHASE TWO
CAB. B, SLIDE 143
P.R.R.C.T.

PREPARED BY:
VIA WIER & ASSOCIATES, INC.
ENGINEERS SURVEYORS LAND PLANNERS
4300 BELLEVUE PLACE SUITE 130 ARLINGTON, TEXAS 76018 METRO (817)467-7700
4100 AMUNDY CARTER BLVD. SUITE 200 FORT WORTH, TEXAS 76155 METRO (817)355-9437

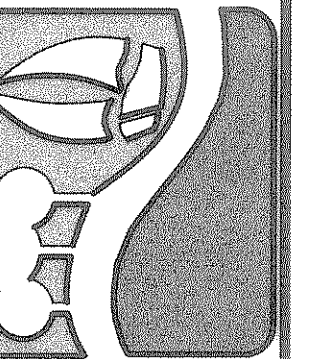

**S.H. 205 (GOLIAD STREET)
STRIPING PLAN**
STA 455+00 TO 465+00

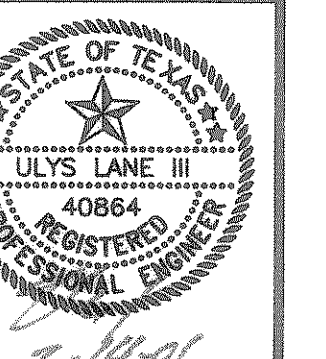

COPYRIGHT ©
WIER & ASSOCIATES, INC.
LAST SHEET EDIT
DATE 01-31-2001
W/A# 37087

SHEET NO.
15