

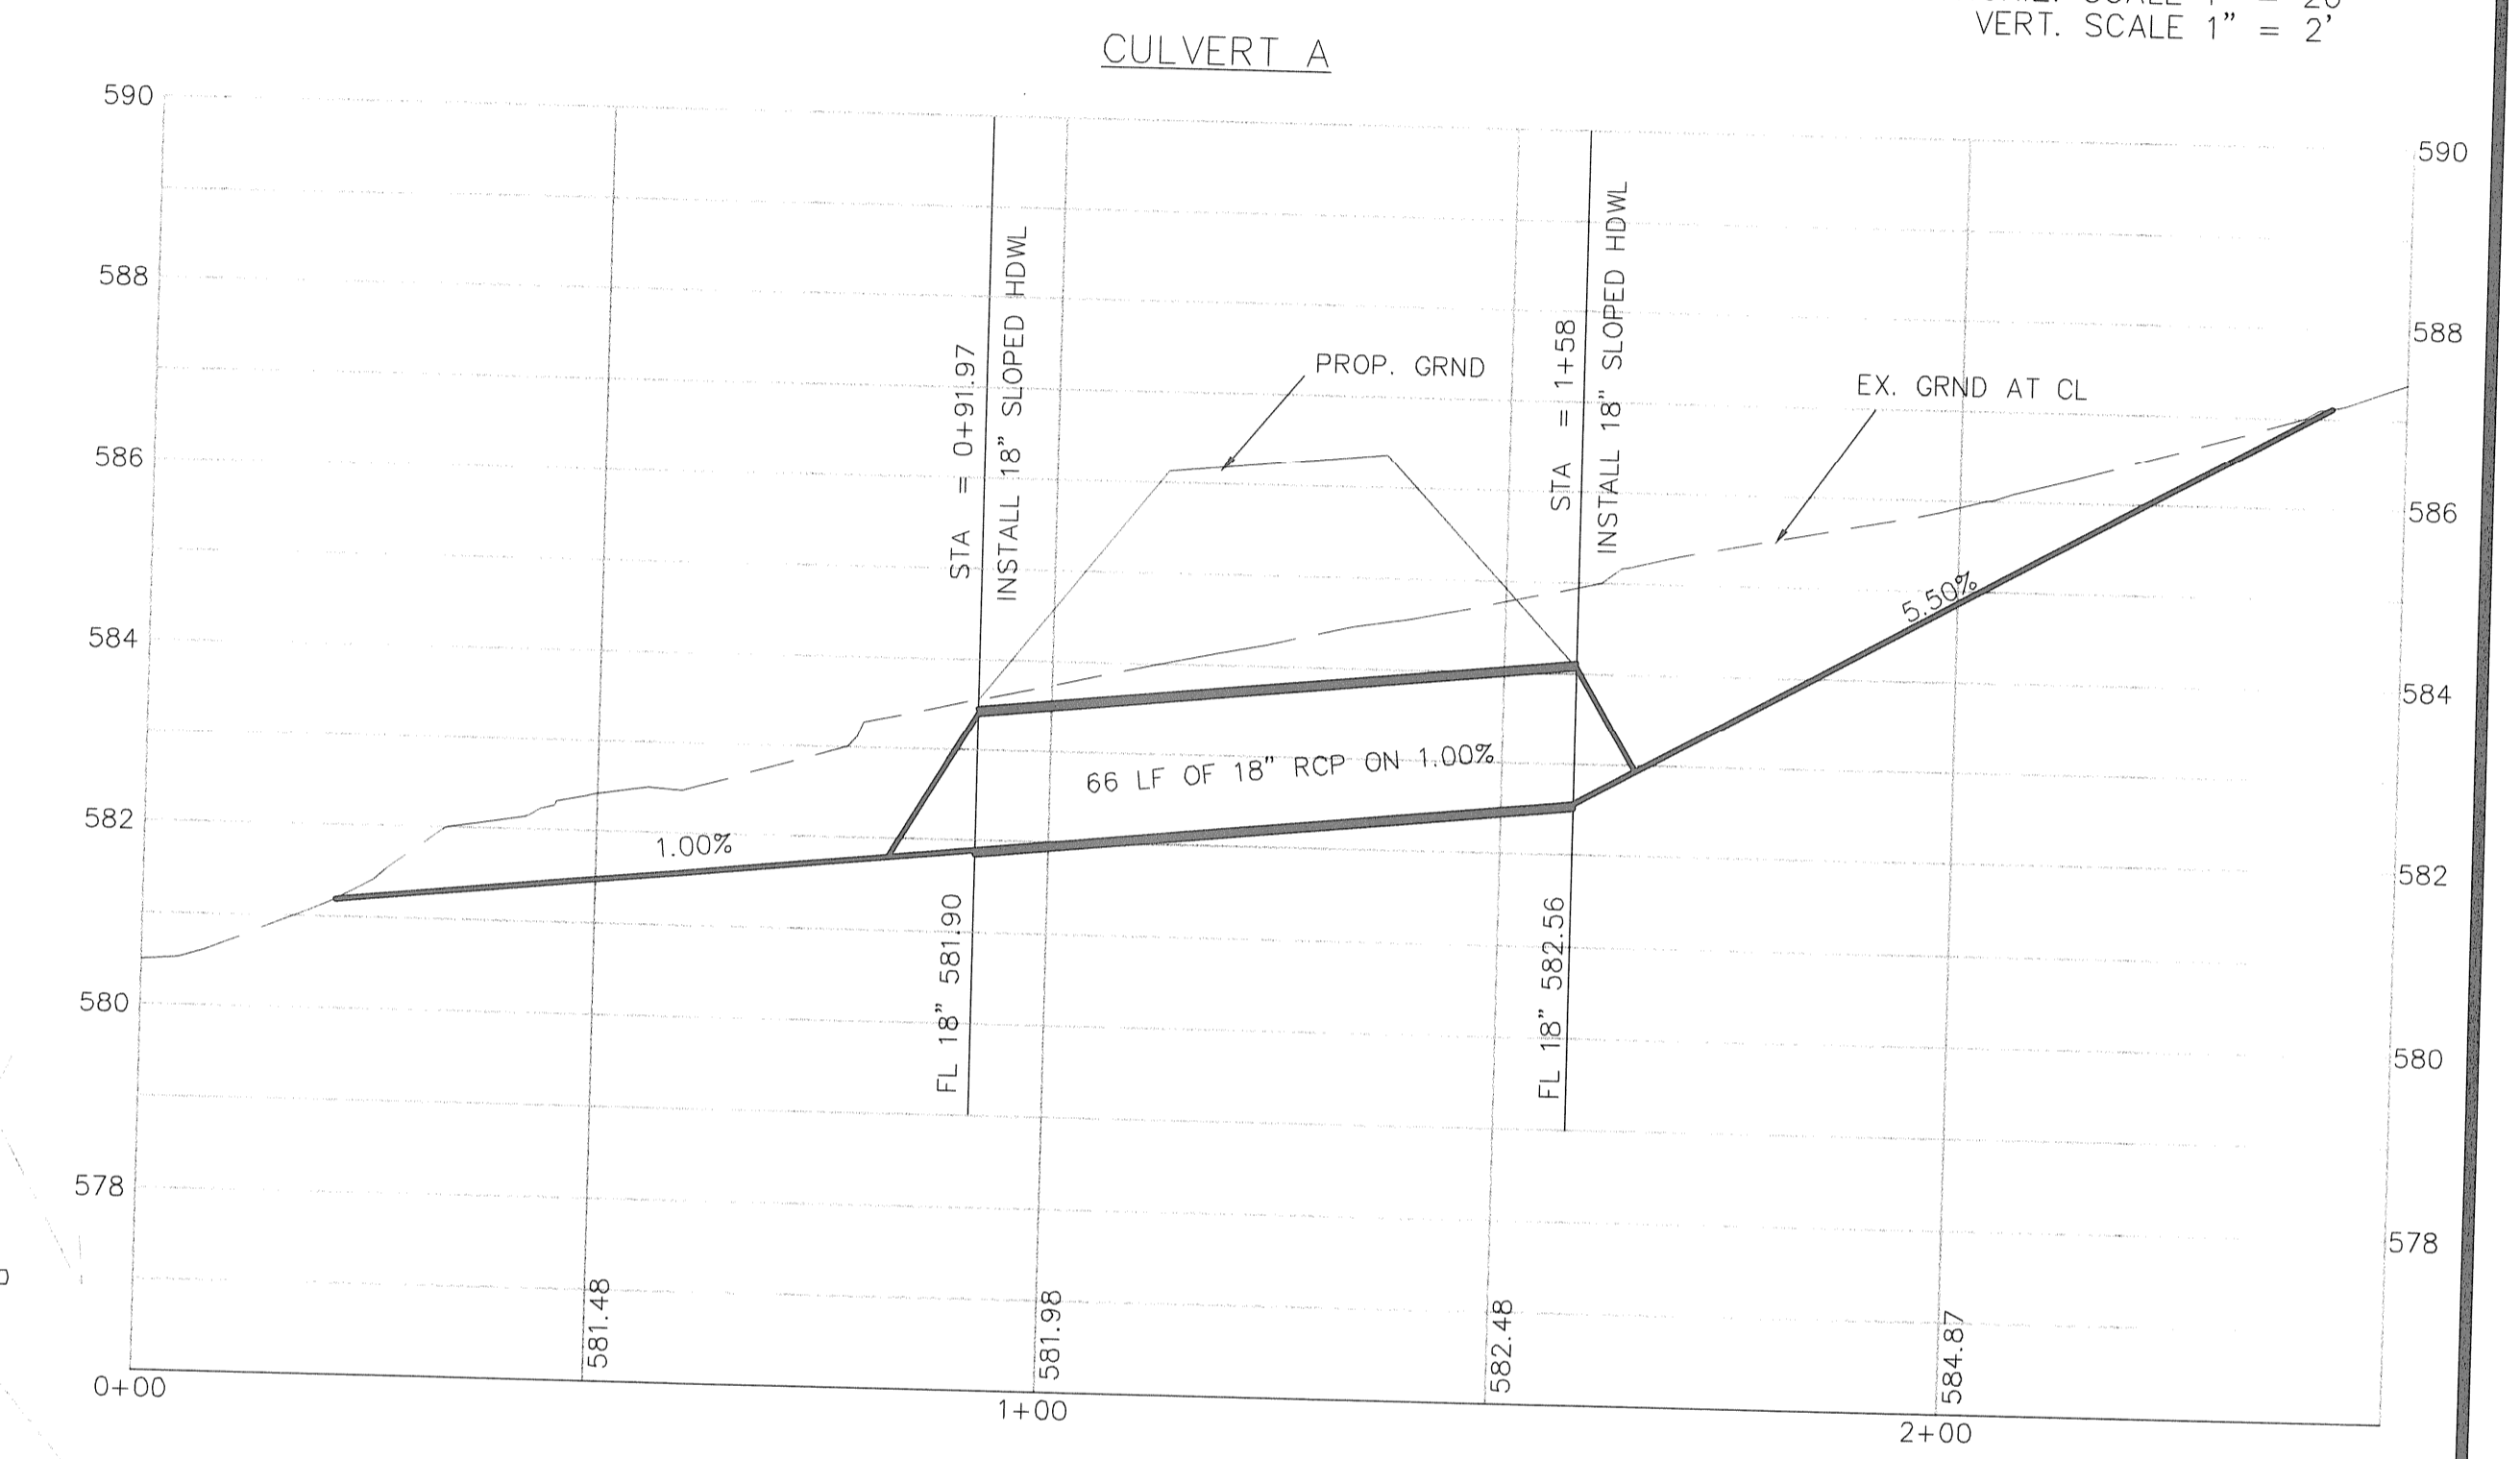


HORIZ. SCALE 1" = 20'  
VERT. SCALE 1" = 2'

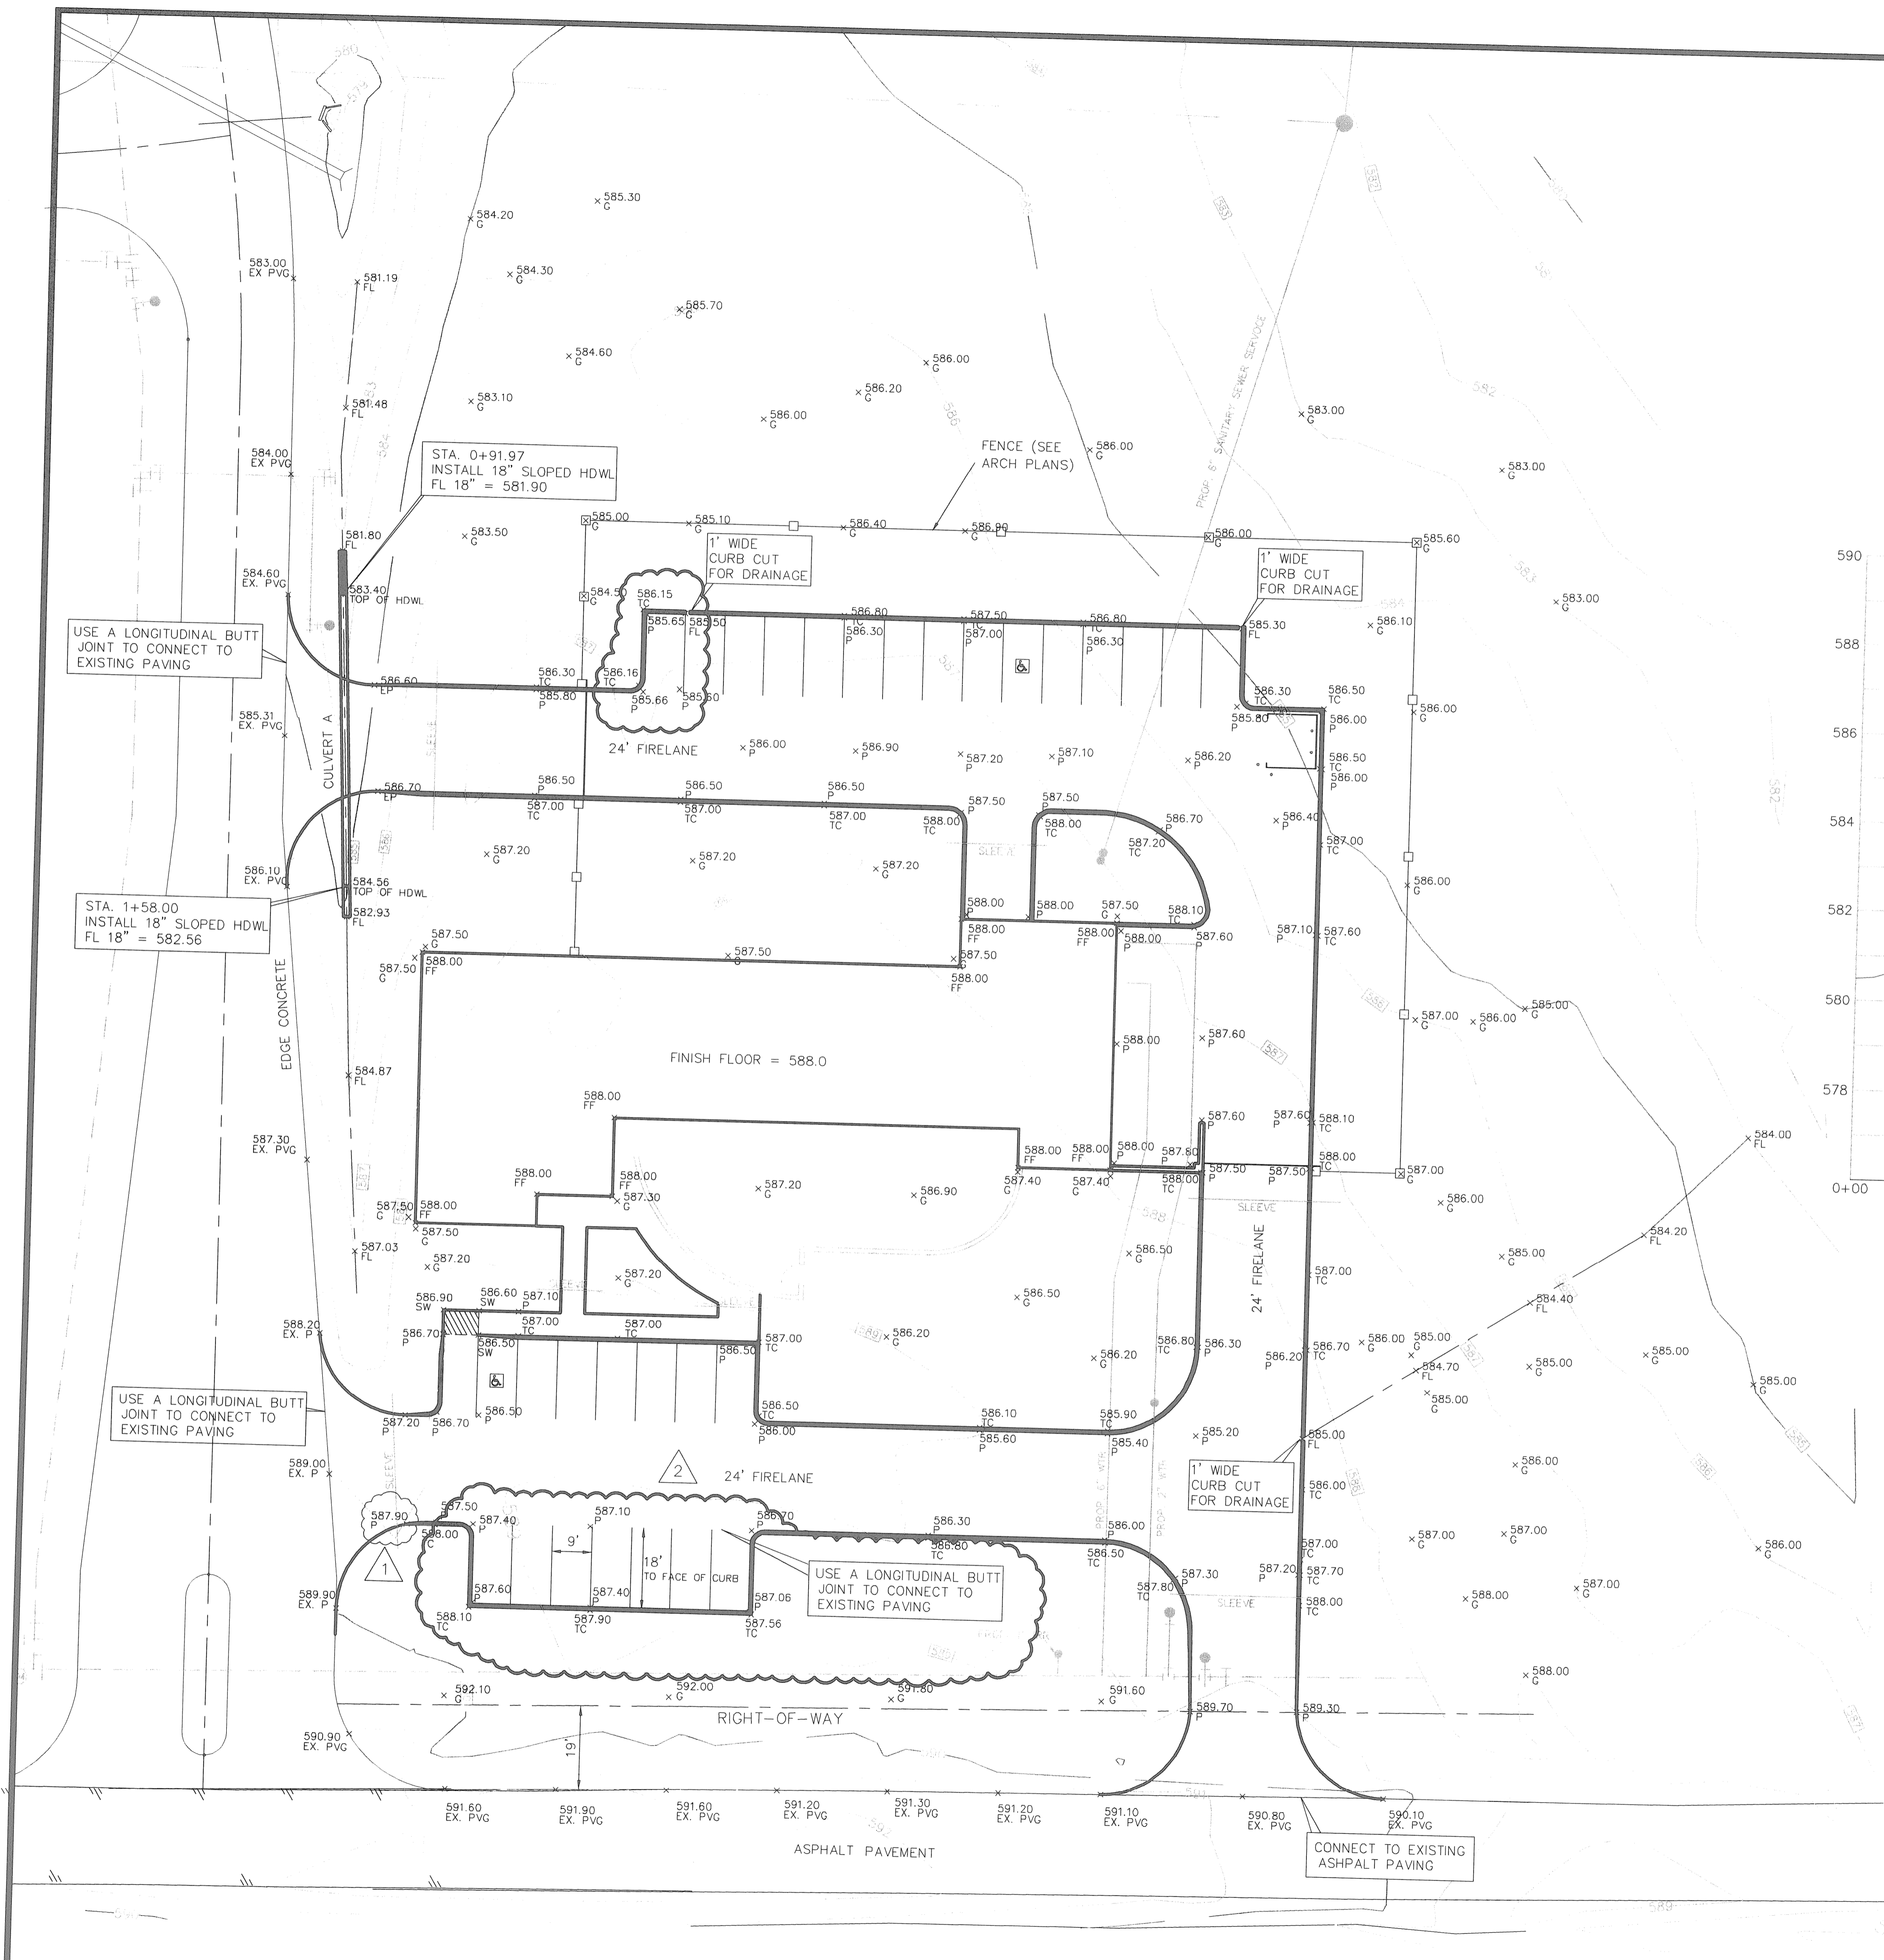

KEY  
FF=FINISHED FLOOR  
FL=FLOWLINE  
G=GROUND  
P=PAVING  
SW=SIDEWALK  
TC=TOP OF CURB

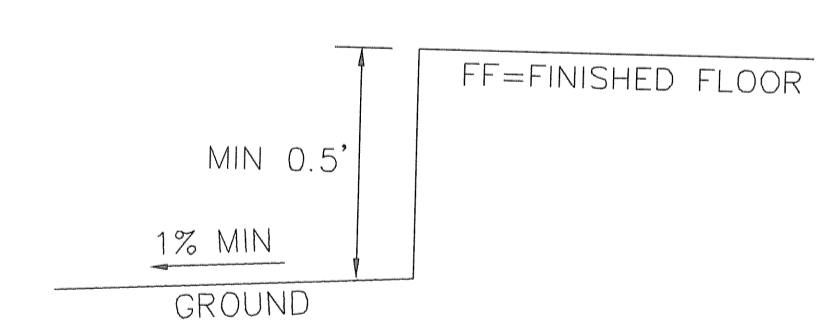

DETAIL  
NTS  
FINISHED FLOOR TO BE MINIMUM OF 0.5'  
ABOVE GROUND.


GRADING AND STORM WATER  
ROCKWALL ANIMAL ADOPTION CENTER  
**ROCKWALL, TEXAS**  
CITY OF ROCKWALL  
"THE NEW HORIZON"

REVISION NO.	REMARKS	DATE
1	CHGD. ELEV	7-10-07
2	ADDING PARKING	3-05-08

DESIGNED: A.J.W.  
DRAWN: LD2006  
JOB NO. GRADING.DWG

THE SEAL APPEARING ON THIS DOCUMENT WAS AUTHORIZED BY CHARLES A. TODD TEXAS P.E. NO. 55647 ON

DATE: 03/2007  
C2

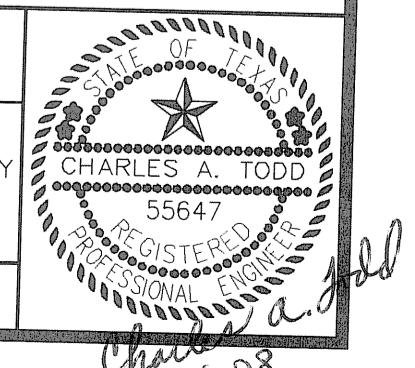

3-14-08