


**SECTION "A-A"**  
(NO SCALE)

**DETAIL "B"**  
(NO SCALE)

**LEGEND:**  
 [19.0] FINISHED PAVEMENT ELEVATION  
 \*EP-19.0 EXISTING PAVEMENT ELEVATION

BENCH MARK:  
 "D" IN BACK OF CURB 9' WEST  
 & 5' NORTH OF ROCKWALL SERVICE  
 CENTER FRONT DOOR  
 ELEVATION ASSUMED = 100.0

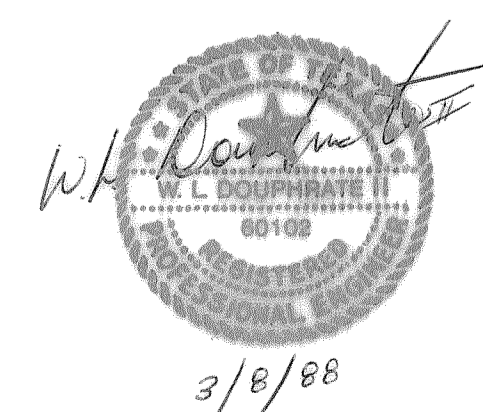

<b>GRADING PLAN</b>						
PARKING	LOT					
BASEBALL FIELDS						
CITY OF ROCKWALL, TEXAS						
DESIGN	DRAWN	DATE	SCALE	NOTES	FILE	NO.

3/8/88