


FOR ELEVATIONS SEE ADA ACCESSIBLE ENTRANCE GRADING SHEET 3 OF 3

FOR ELEVATIONS SEE ADA ACCESSIBLE ENTRANCE GRADING SHEET 3 OF 3

20' BY 20' STABILIZED ROCK RIP RAP FOR EROSION CONTROL BMP.

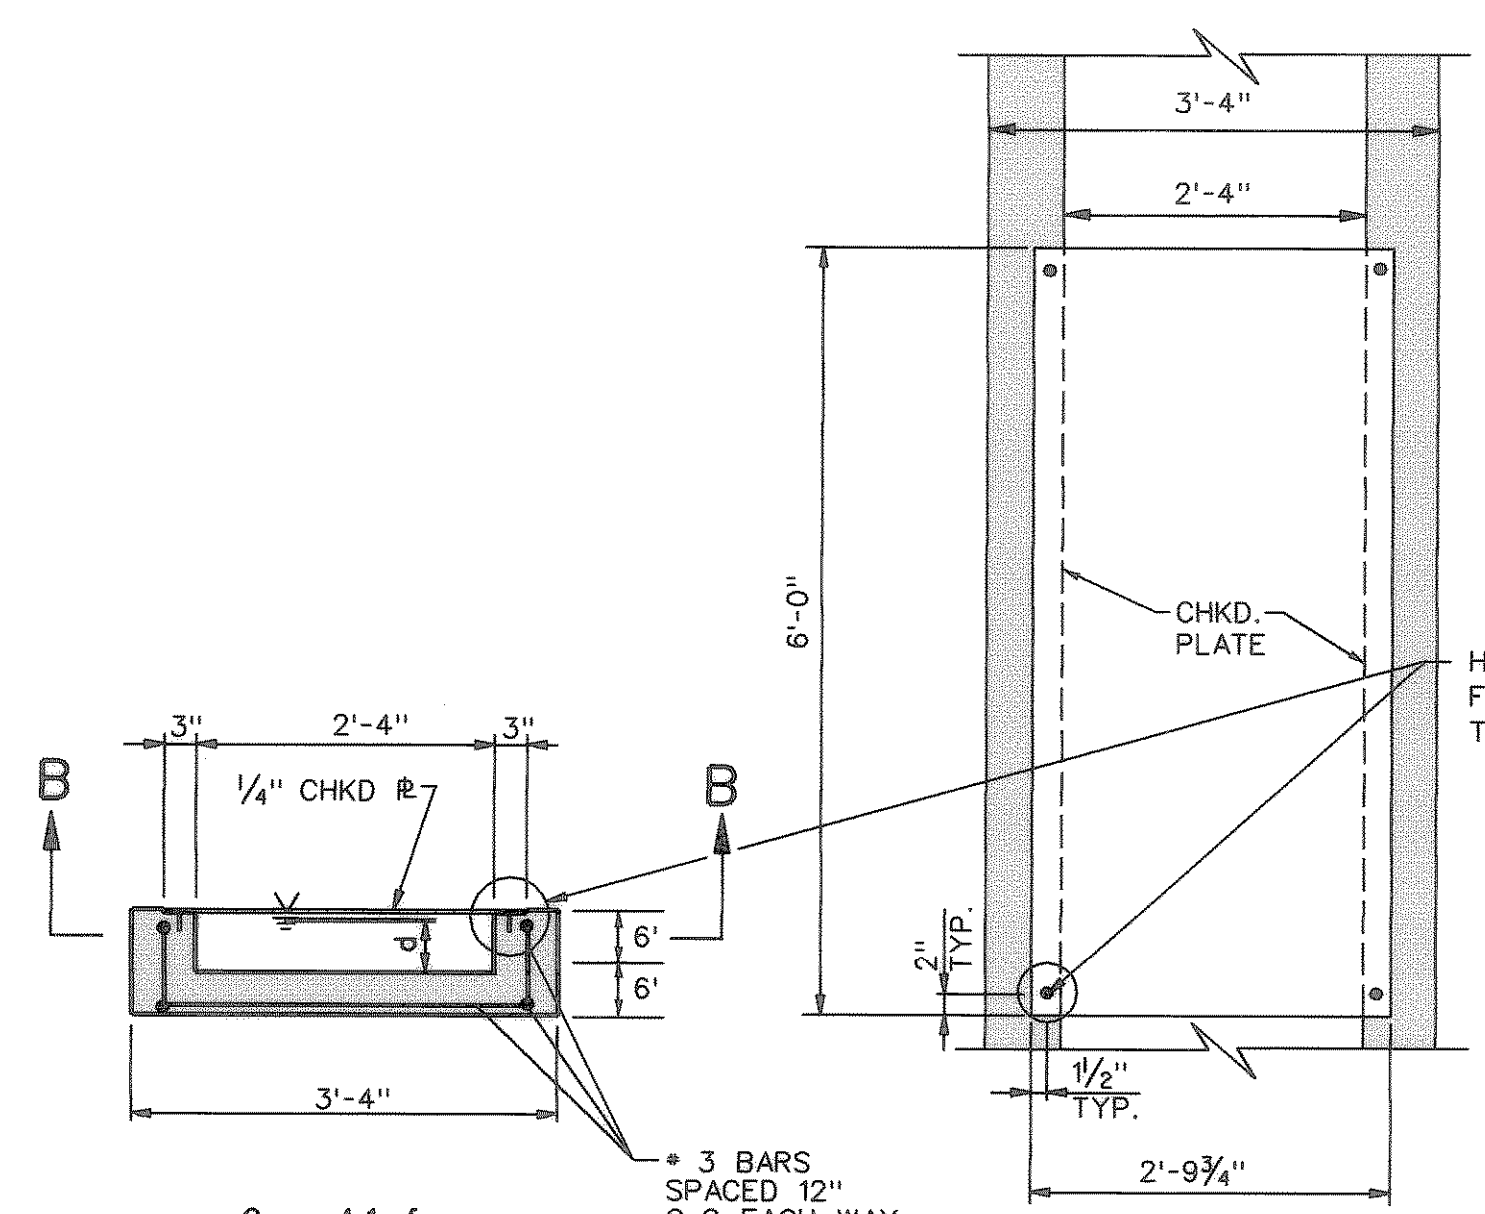


SECTION B-B - PLAN VIEW  
N.T.S.

SECTION A-A  
N.T.S.

SIDEWALK PLATE COVERING  
N.T.S.

NOTE: CONTRACTOR SHALL FIELD VERIFY THE LOCATION AND DEPTH OF ALL EXISTING UTILITIES (SHOWN ON PLANS OR NOT) PRIOR TO CONSTRUCTION. IF FIELD CONDITIONS DIFFER SIGNIFICANTLY FROM LOCATIONS SHOWN ON PLANS, THE CONTRACTOR SHALL CONTACT THE ENGINEER PRIOR TO PROCEEDING WITH CONSTRUCTION. R-DELTA ENGINEERS, INC. WILL NOT BE RESPONSIBLE FOR ANY WORK BY THE CONTRACTOR NEGLECTING TO LOCATE THESE UTILITIES.

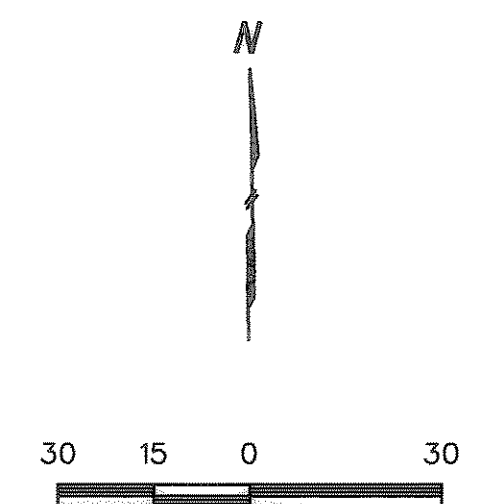


LEGEND:

- TS TOP OF SURFACE ELEVATION
- TC TOP OF CURB ELEVATION
- FF FINISHED FLOOR ELEVATION
- FP FINISHED PAD ELEVATION
- X SPOT ELEVATION
- NG NATURAL GROUND ELEVATION
- TW TOP OF RET. WALL ELEVATION
- TD TOP OF DRAIN ELEVATION

BENCHMARK:  
FOUND GENERALLY AT THE NORTHWEST CORNER OF S. ALAMO ST. AND WEST WASHINGTON ST. AND LOCATED 4.60' EAST OF THE BACK OF THE CURB ALONG WEST SIDE OF S. ALAMO ST. CITY OF ROCKWALL SURVEY MONUMENT R012 ELEV. = 594.25

AS-BUILT PLANS

NOTE: THE INTENT OF THE OWNER AND ENGINEER WAS TO CONSTRUCT THESE IMPROVEMENTS IN ACCORDANCE WITH THESE PLANS AS APPROVED BY THE CITY OF ROCKWALL. THE UTILITIES AND GRADES WERE SET ON THE GROUND FOR CONSTRUCTION ACCORDING TO SAID PLANS AND THE CITY OF ROCKWALL INSPECTED THE CONSTRUCTION. THE OWNER OR ENGINEER DID NOT VERIFY LINES OR GRADES AFTER CONSTRUCTION.

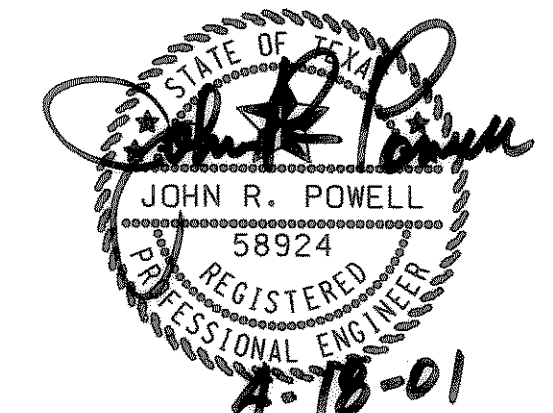

THE SEAL APPEARING ON THIS DOCUMENT WAS AUTHORIZED BY JOHN R. POWELL, P.E. 58924 ON FEBRUARY 12, 2001. ALTERATION OF A SEALED DOCUMENT WITHOUT PROPER NOTIFICATION TO THE RESPONSIBLE ENGINEER IS AN OFFENSE UNDER THE TEXAS ENGINEERING PRACTICE ACT.

MATCH LINE SHEET 2

GRADING PLAN Sheet 1 of 3

ROCKWALL CITY HALL COMPLEX

CITY OF ROCKWALL, TEXAS

R-DELTA ENGINEERS, INC.  
418 MAIN STREET GARLAND, TEXAS 75040  
Phone (972) 494-5051 WWW.RDELTA.COM

DESIGN: JRP/ABF	CHECK:	SCALE: AS SHOWN	SHEET
DRAWN: ABF/MDP	DATE: FEBRUARY 2001	RDE PROJECT: 98-755	C3 OF 13