
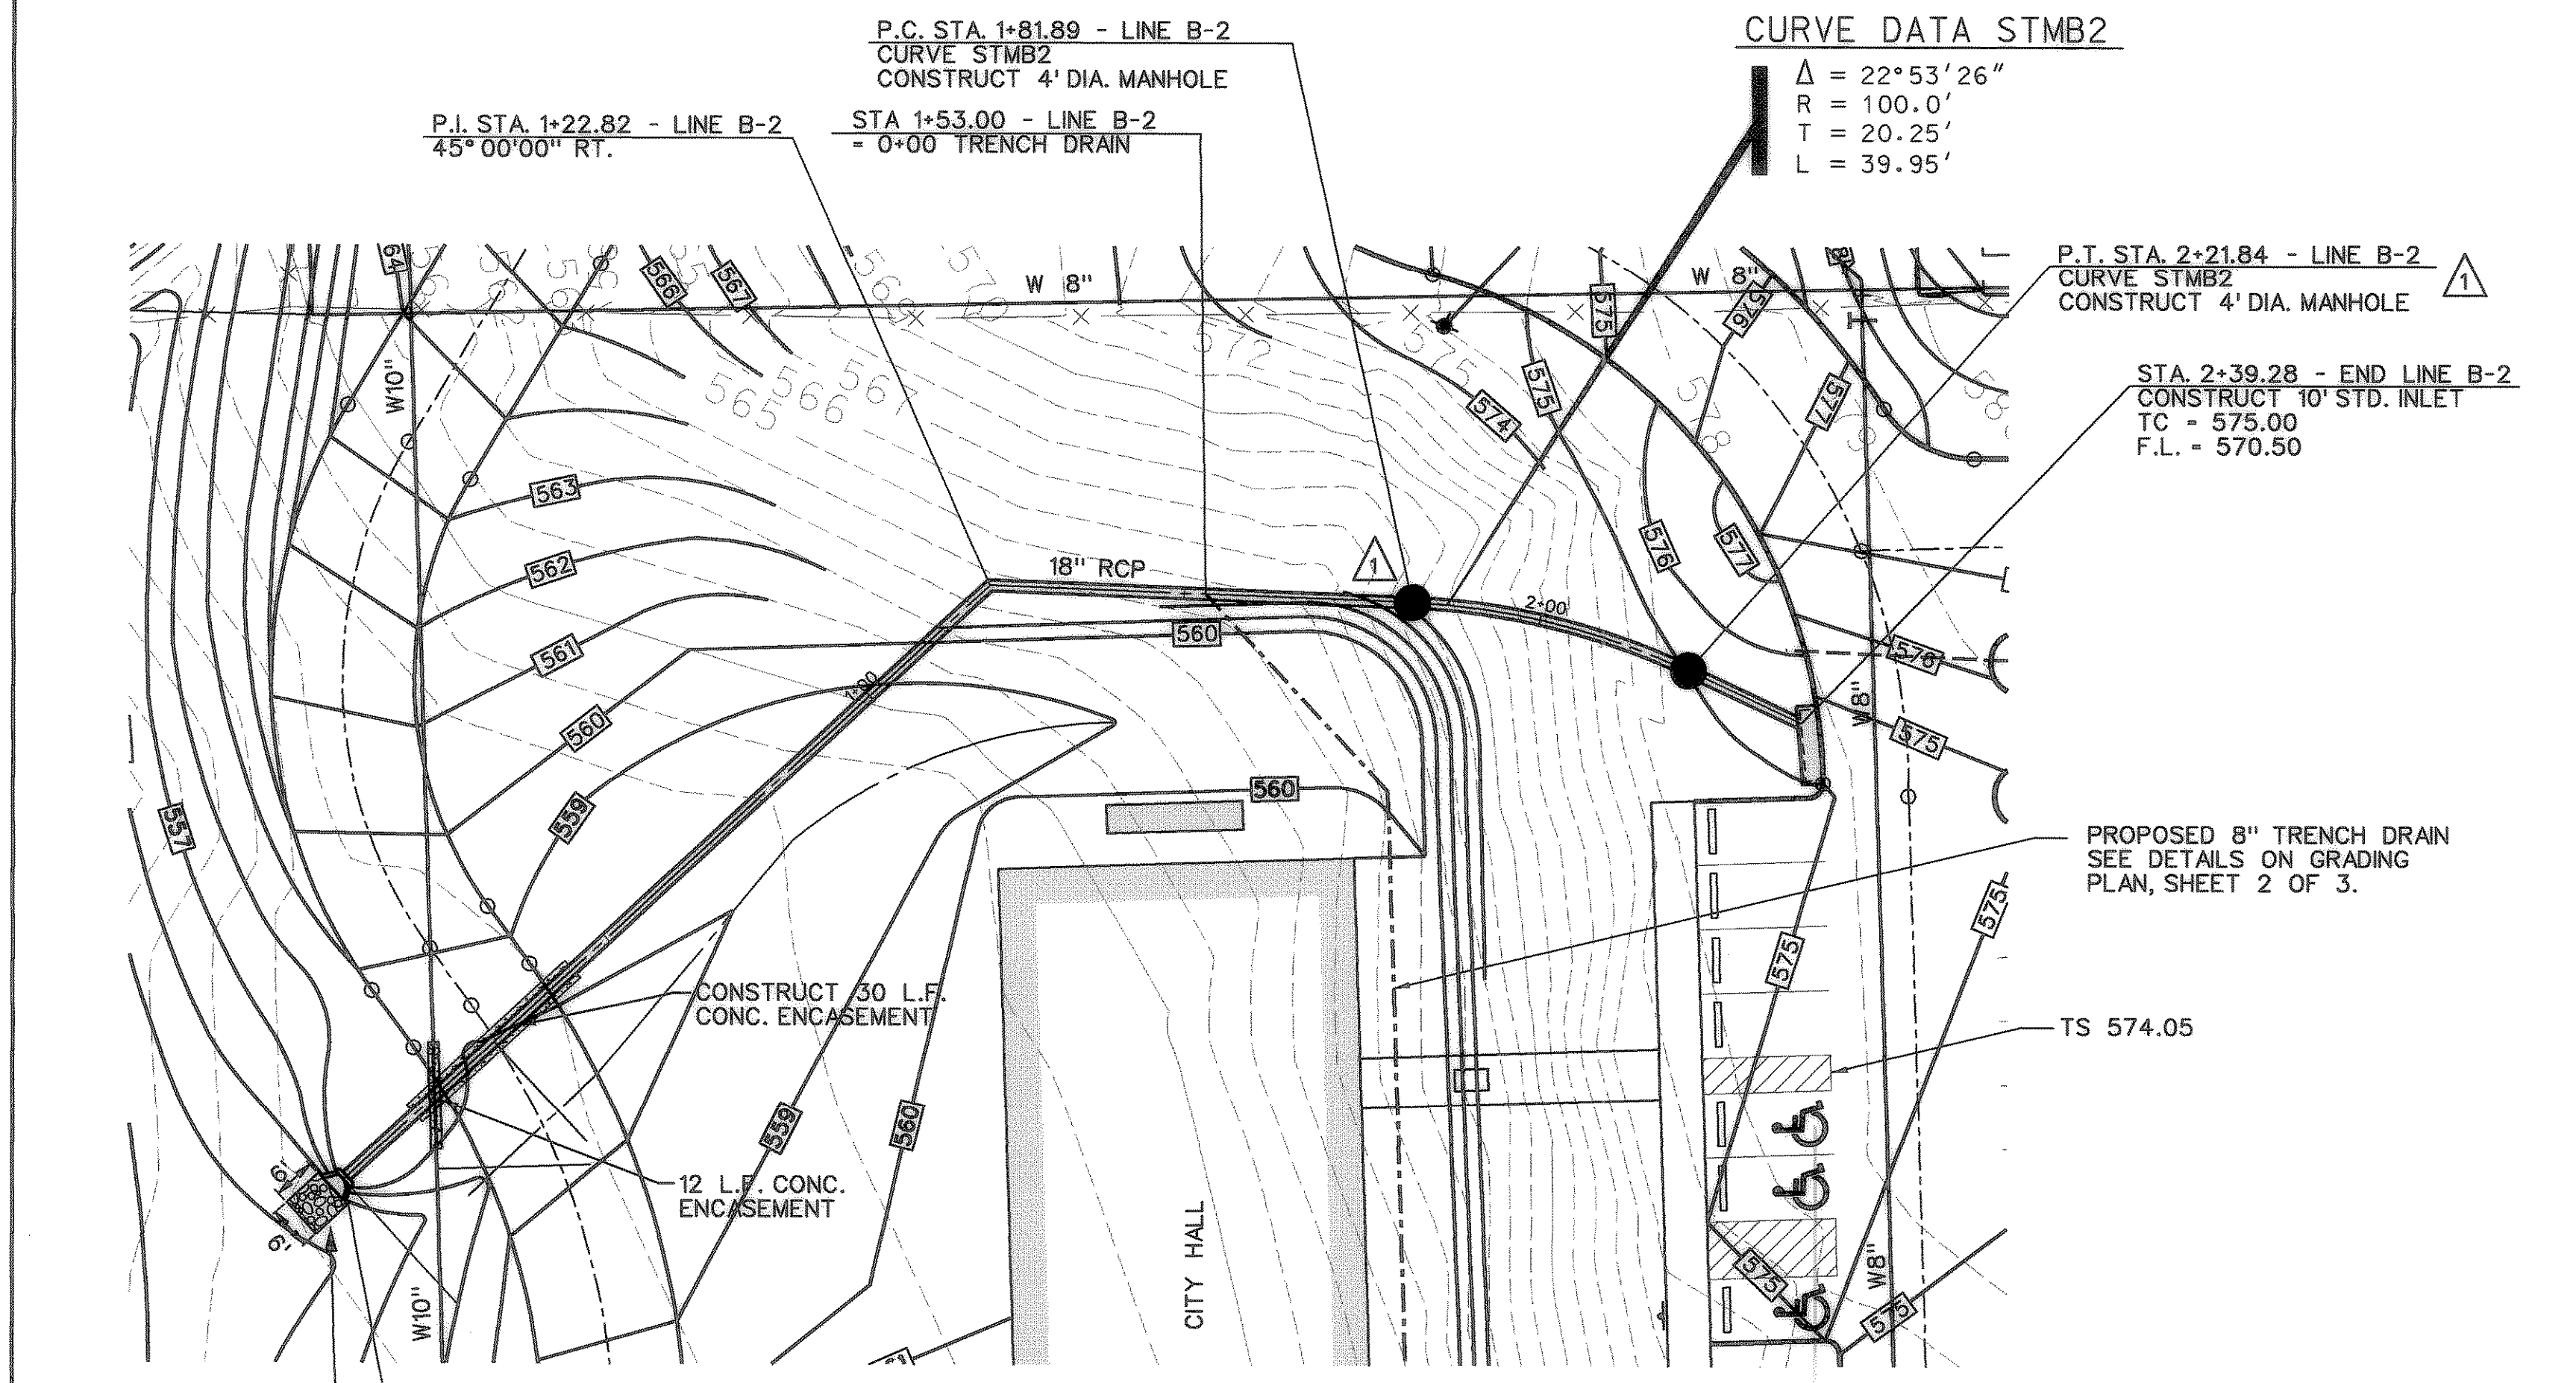


HORIZONTAL ALIGNMENT DATA			
STA.	NORTHING	EASTING	DESCRIPTION
LINE B-2			
0+00	5257.02	4733.14	POB
1+22.82	5340.41	4823.31	P. I.
1+81.89	5338.11	4882.34	P.C. CURVE B-2, M.H.
2+21.84	5328.73	4920.90	P.T. CURVE B-2, M.H.
2+39.28	5321.32	4936.69	POE @ INLET

NOTE:
CONTRACTOR SHALL FIELD VERIFY THE LOCATION AND DEPTH OF ALL EXISTING UTILITIES (SHOWN ON PLANS OR NOT) PRIOR TO CONSTRUCTION. IF FIELD CONDITIONS DIFFER SIGNIFICANTLY FROM LOCATIONS SHOWN ON PLANS, THE CONTRACTOR SHALL CONTACT THE ENGINEER PRIOR TO PROCEEDING WITH CONSTRUCTION. R-DELTA ENGINEERS, INC. WILL NOT BE RESPONSIBLE FOR ANY WORK BY THE CONTRACTOR NEGLECTING TO LOCATE THESE UTILITIES.

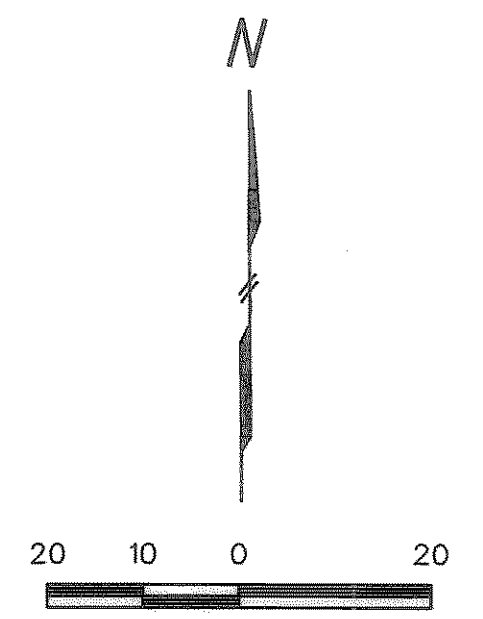


CURVE DATA STMB2
 $\Delta = 22^\circ 53' 26''$
 $R = 100.0'$
 $T = 20.25'$
 $L = 39.95'$

CONSTRUCT 6'x 6' ROCK RIPRAP PROTECTION
 STA. 0+00 - BEGIN STORM SEWER LINE B-2
 CONSTRUCT TYPE "B" HEADWALL
LINE B-2
 SCALE: 1" = 20'


PLAN
 SCALE: 1" = 20'
LATERALS - LINE B1b & B1c

AS-BUILT PLANS
 NOTE: THE INTENT OF THE OWNER AND ENGINEER WAS TO CONSTRUCT THESE IMPROVEMENTS IN ACCORDANCE WITH THESE PLANS AS APPROVED BY THE CITY OF ROCKWALL. THE UTILITIES AND GRADES WERE SET ON THE GROUND FOR CONSTRUCTION ACCORDING TO SAID PLANS AND THE CITY OF ROCKWALL INSPECTED THE CONSTRUCTION. THE OWNER OR ENGINEER DID NOT VERIFY LINES OR GRADES AFTER CONSTRUCTION.

BENCHMARK:
 FOUND GENERALLY AT THE NORTHWEST CORNER OF S. ALAMO ST. AND WEST WASHINGTON ST. AND LOCATED 4.60' EAST OF THE BACK OF THE CURB ALONG WEST SIDE OF S. ALAMO ST. CITY OF ROCKWALL SURVEY MONUMENT R012 ELEV. = 594.25

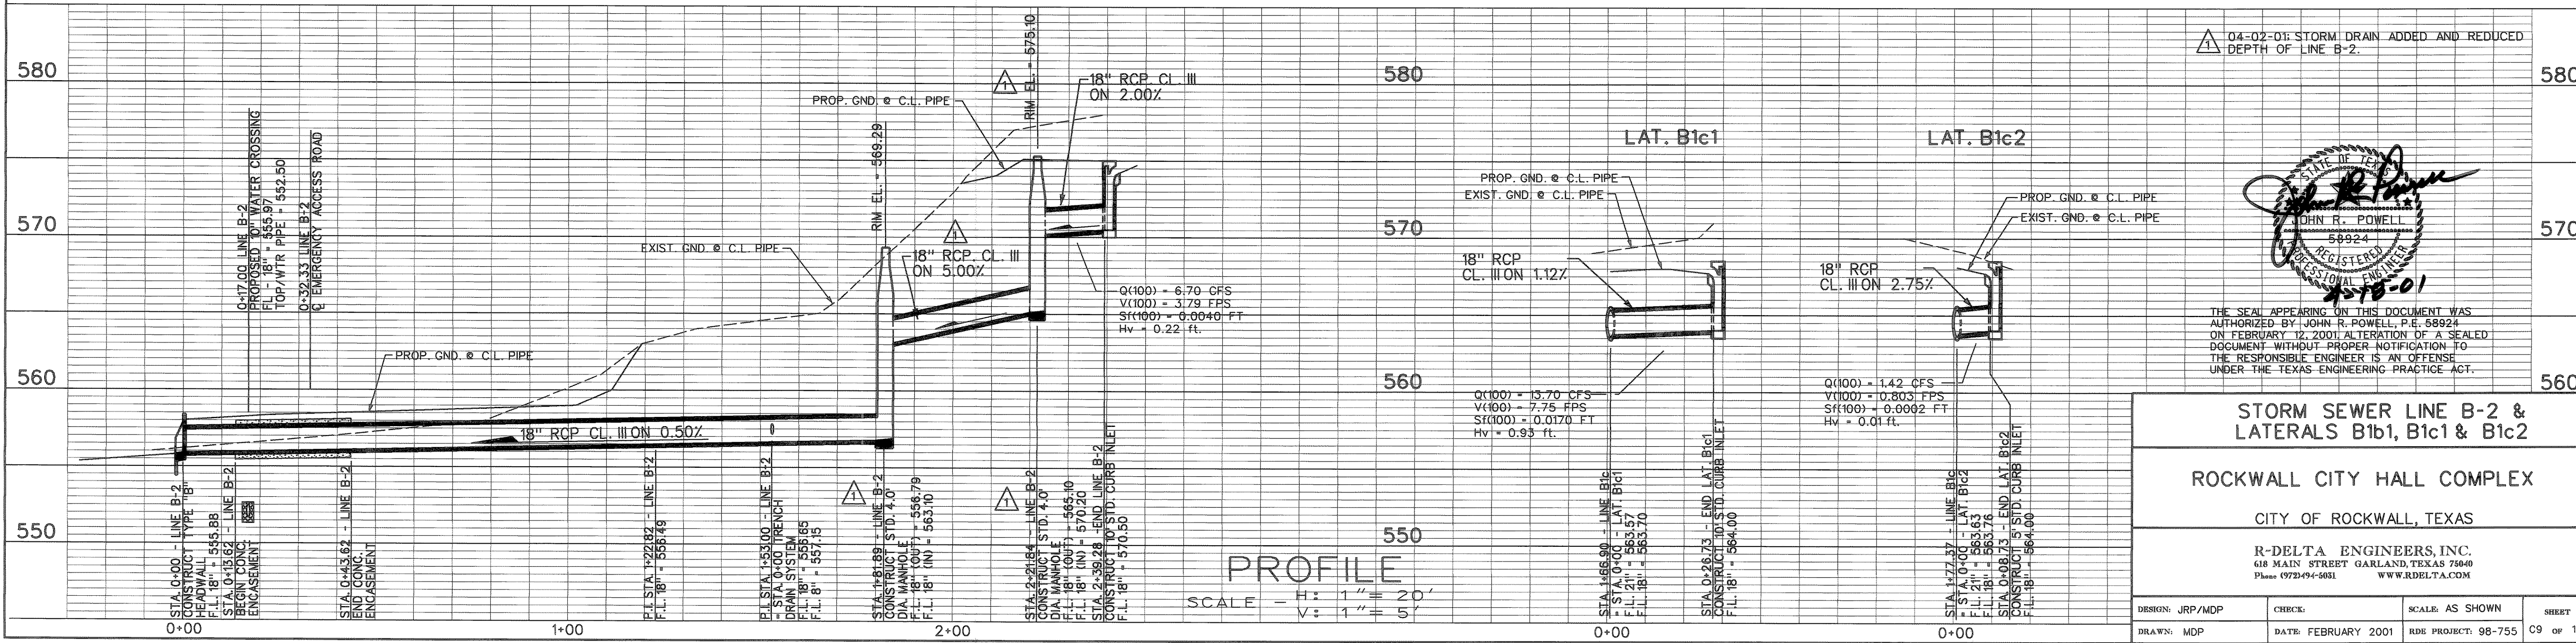

04-02-01: STORM DRAIN ADDED AND REDUCED DEPTH OF LINE B-2.

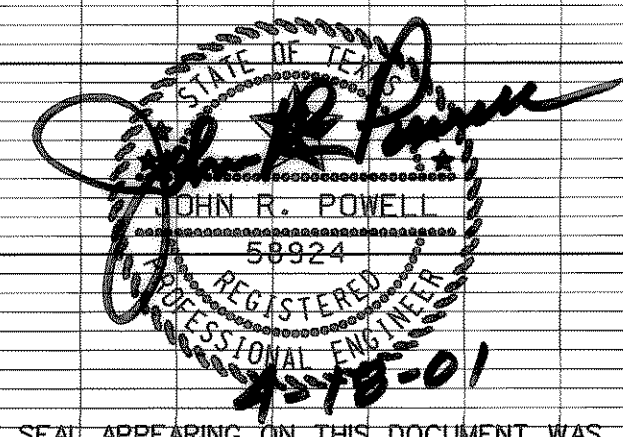

THE SEAL APPEARING ON THIS DOCUMENT WAS AUTHORIZED BY JOHN R. POWELL, P.E. 58924 ON FEBRUARY 12, 2001, ALTERATION OF A SEALED DOCUMENT WITHOUT PROPER NOTIFICATION TO THE RESPONSIBLE ENGINEER IS AN OFFENSE UNDER THE TEXAS ENGINEERING PRACTICE ACT.

STORM SEWER LINE B-2 & LATERALS B1b, B1c1 & B1c2

ROCKWALL CITY HALL COMPLEX

CITY OF ROCKWALL, TEXAS

R-DELTA ENGINEERS, INC.
 618 MAIN STREET GARLAND, TEXAS 75040
 Phone (972) 494-5031 WWW.RDELTA.COM

DESIGN: JRP/MDP	CHECK:	SCALE: AS SHOWN	SHEET
DRAWN: MDP	DATE: FEBRUARY 2001	RDE PROJECT: 98-755	C9 of 13

PROFILE
 SCALE - H: 1" = 20'
 V: 1" = 5'