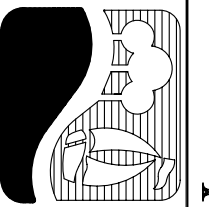


REVISION NO.	REMARKS	DATE

**AS-BUILTS**

  
**CITY OF ROCKWALL**  
 "THE NEW HORIZON"

DESIGNED:	A.J.W.	THE SEAL APPEARING ON THIS DRAWING WAS OBTAINED BY
DRAWN:	ACAD	CHARLES A. TODD TEXAS P.E.
JOB NO.		NO. 55647 ON
		DATE: 07/06
		SHEET NO.

**FIRING RANGE**  
**SANITARY SEWER PROFILE**

**ROCKWALL, TEXAS**

1"=40' HORIZ  
 1"=4' VERT

