


1" = 40' HORIZ  
1" = 4' VERT

FIRING RANGE  
SANITARY SEWER PROFILE  
ROCKWALL, TEXAS  
CITY OF ROCKWALL  
"THE NEW HORIZON"

REVISION NO.	REMARKS	DATE

DESIGNED: A.J.W.  
DRAWN: ACAD  
JOB NO.      DATE: 07/06      SHEET NO.

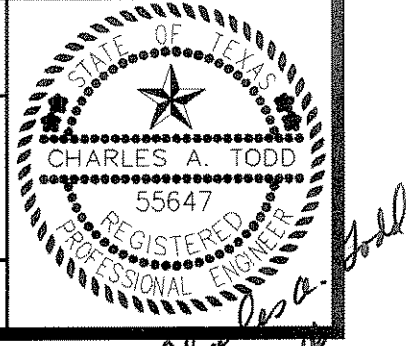

*Handwritten signature and date: 1-17-06*