




1+00

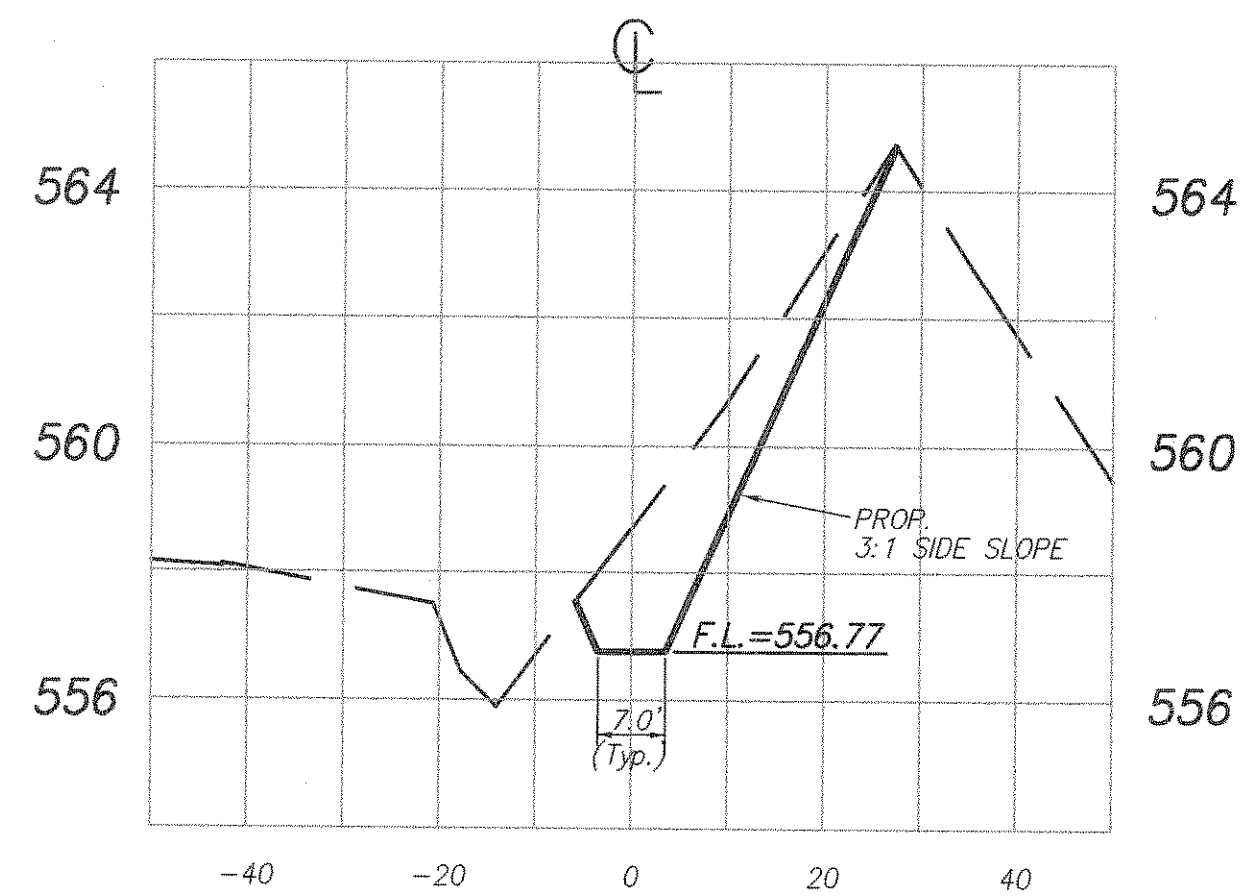


2+50

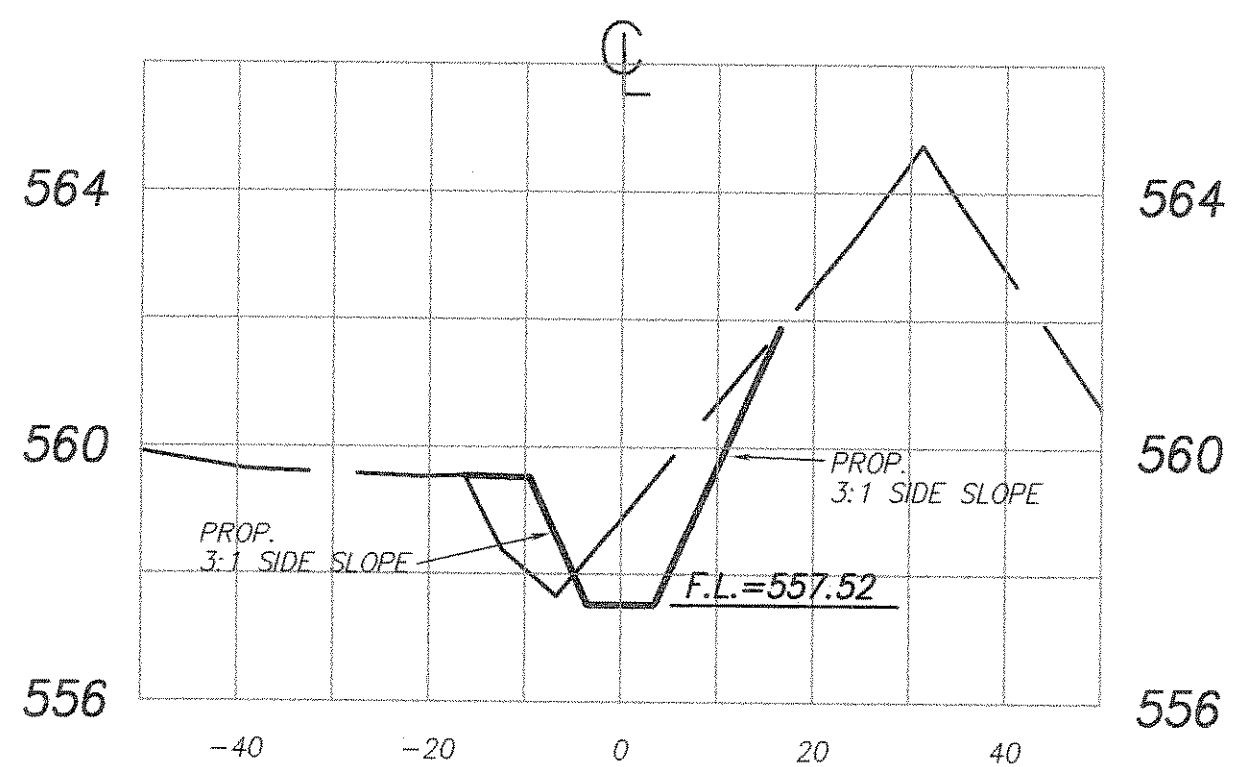


5+00

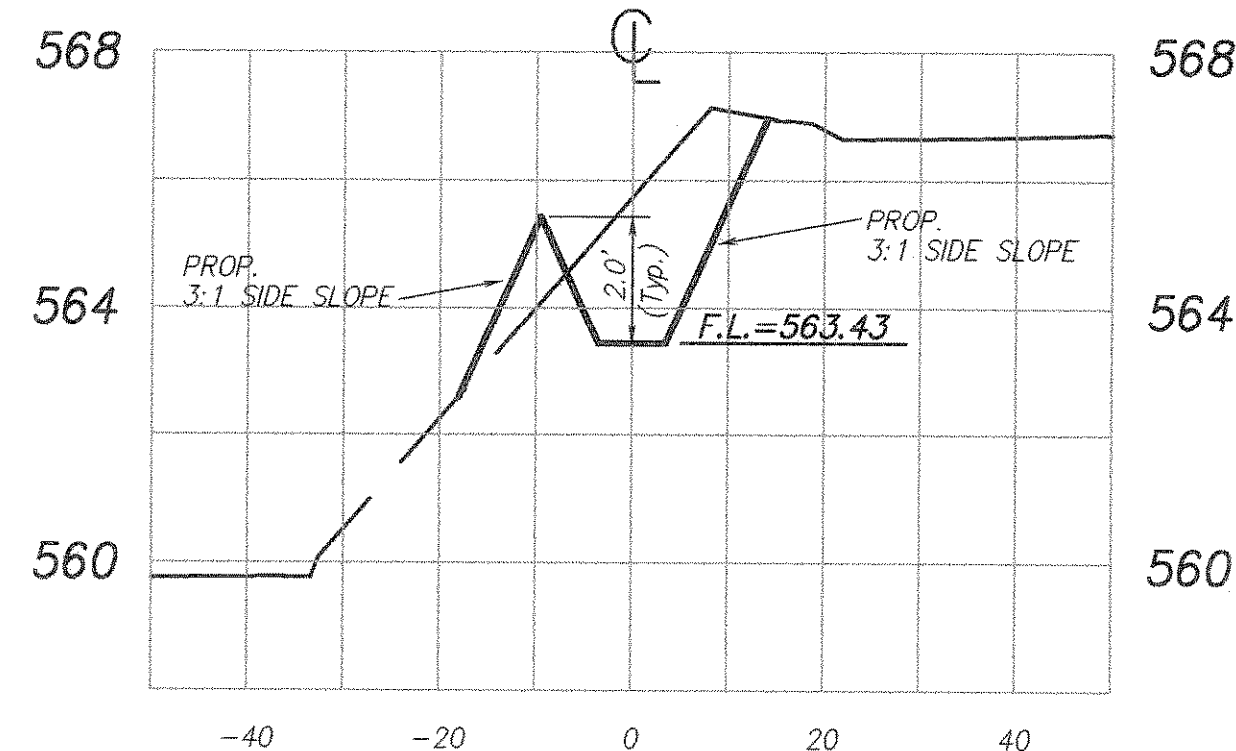


6+50

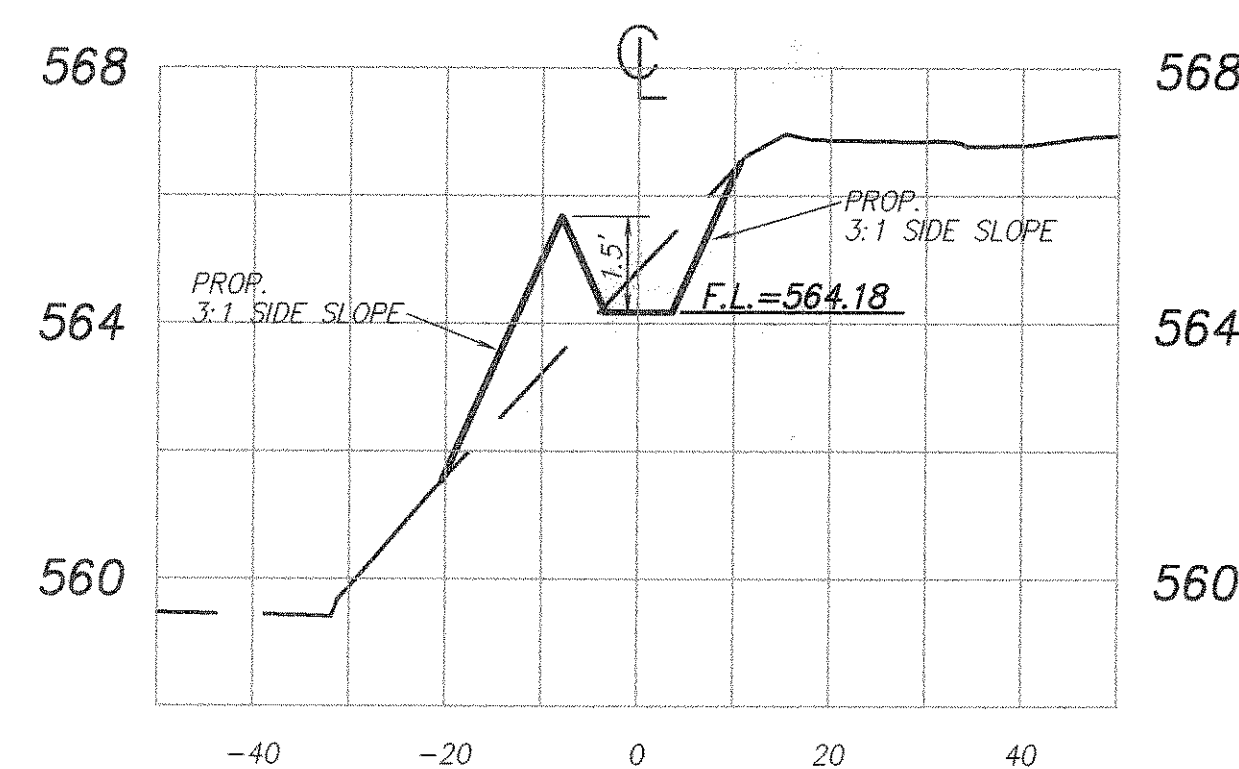


0+50

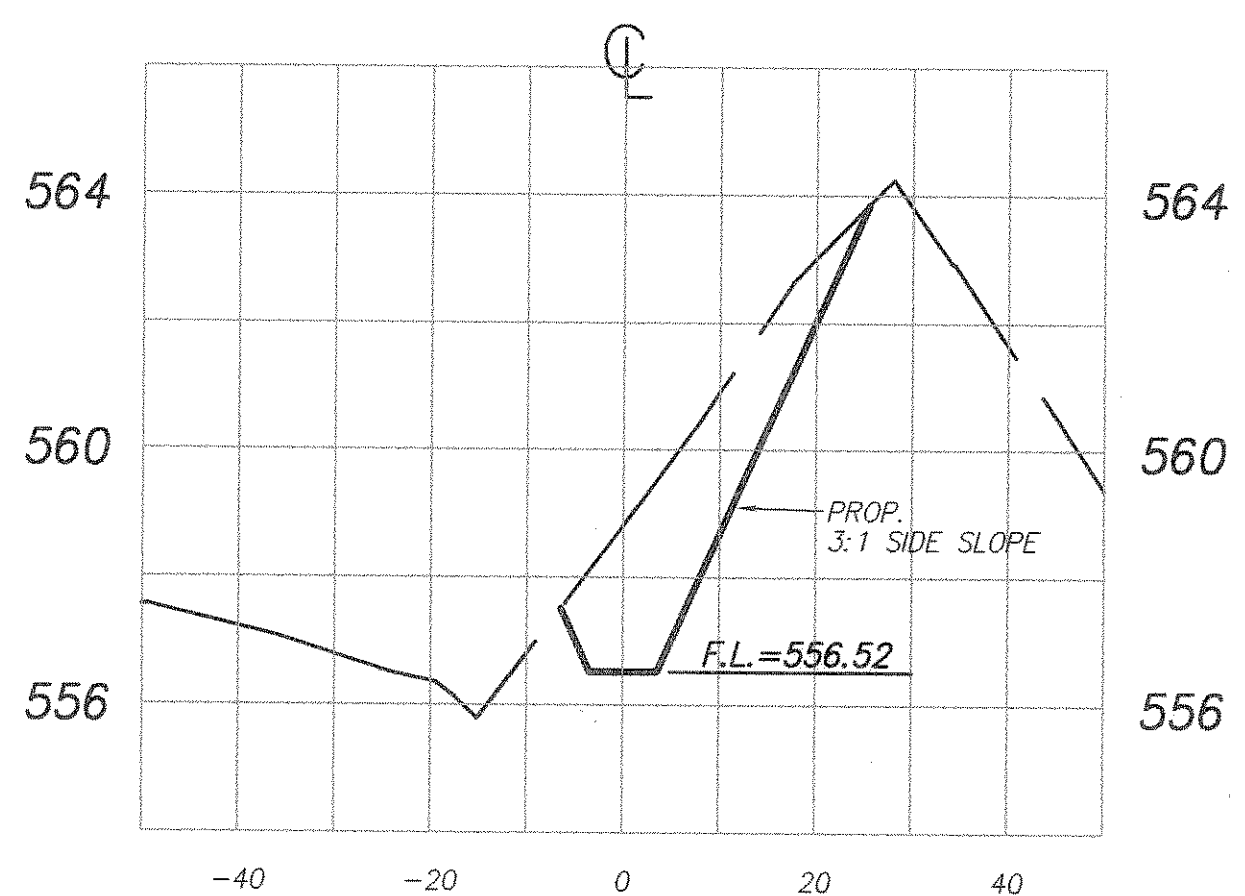


2+00

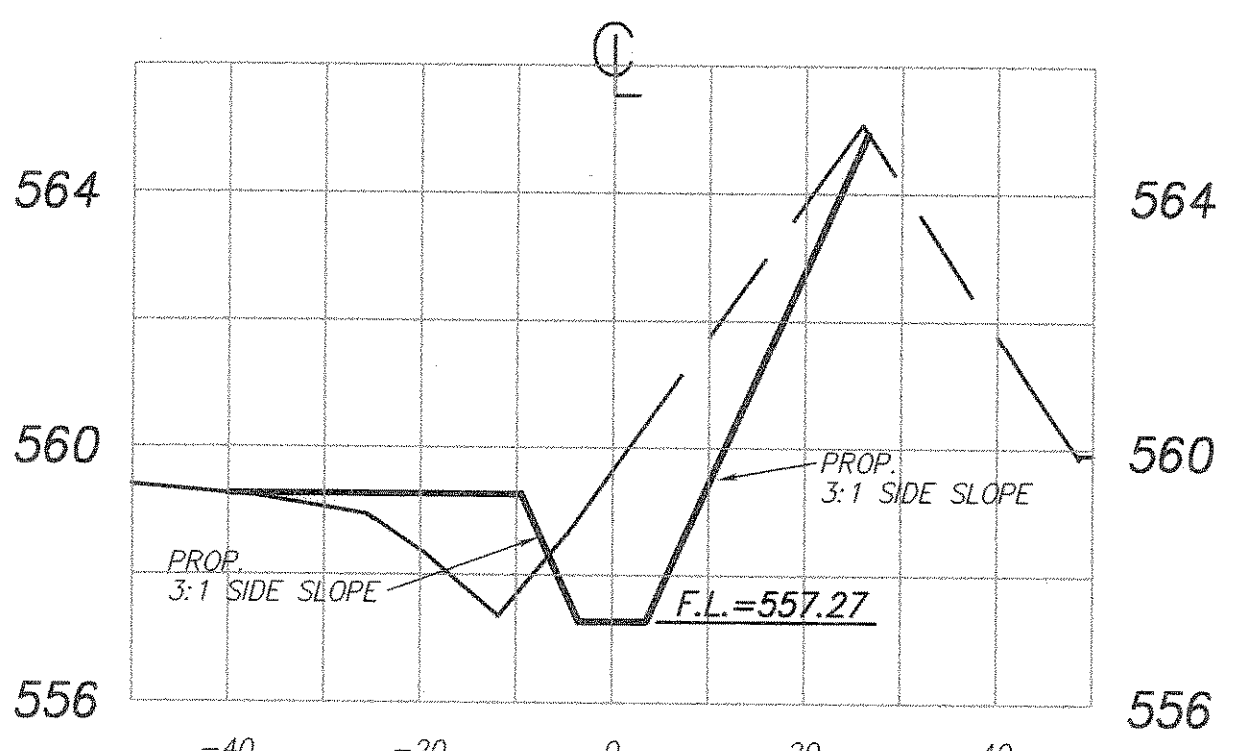


4+50

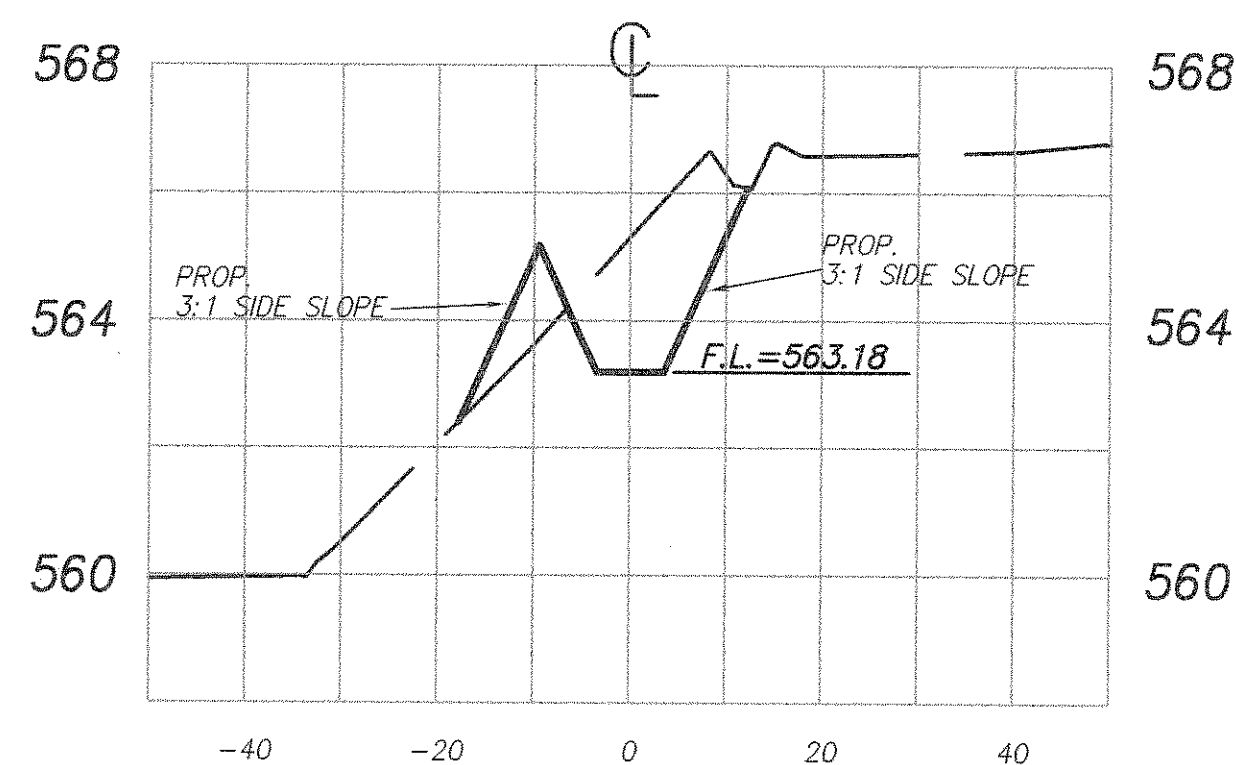


6+00

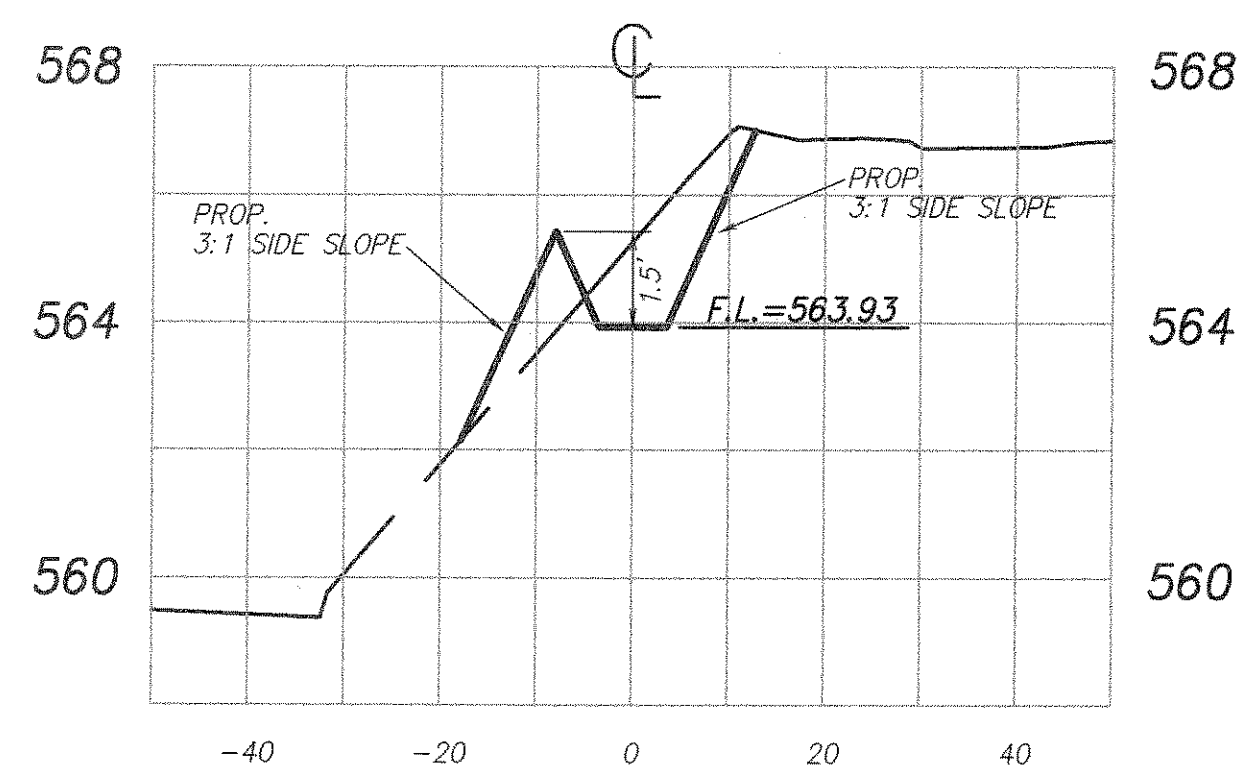


0+00

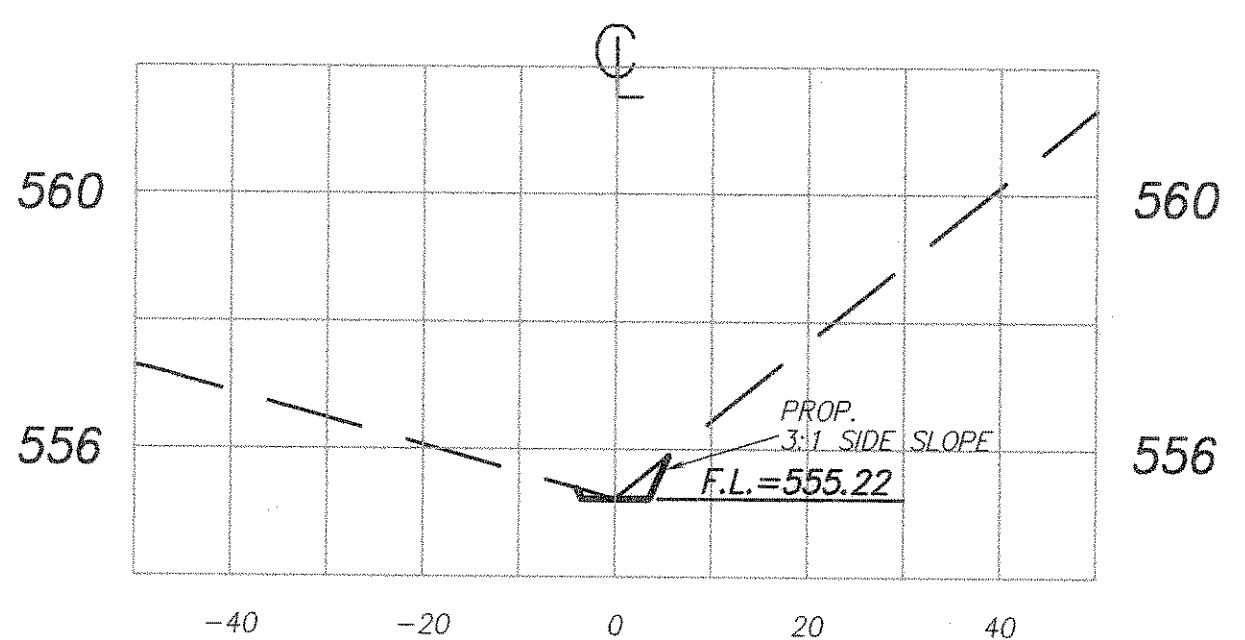


1+50

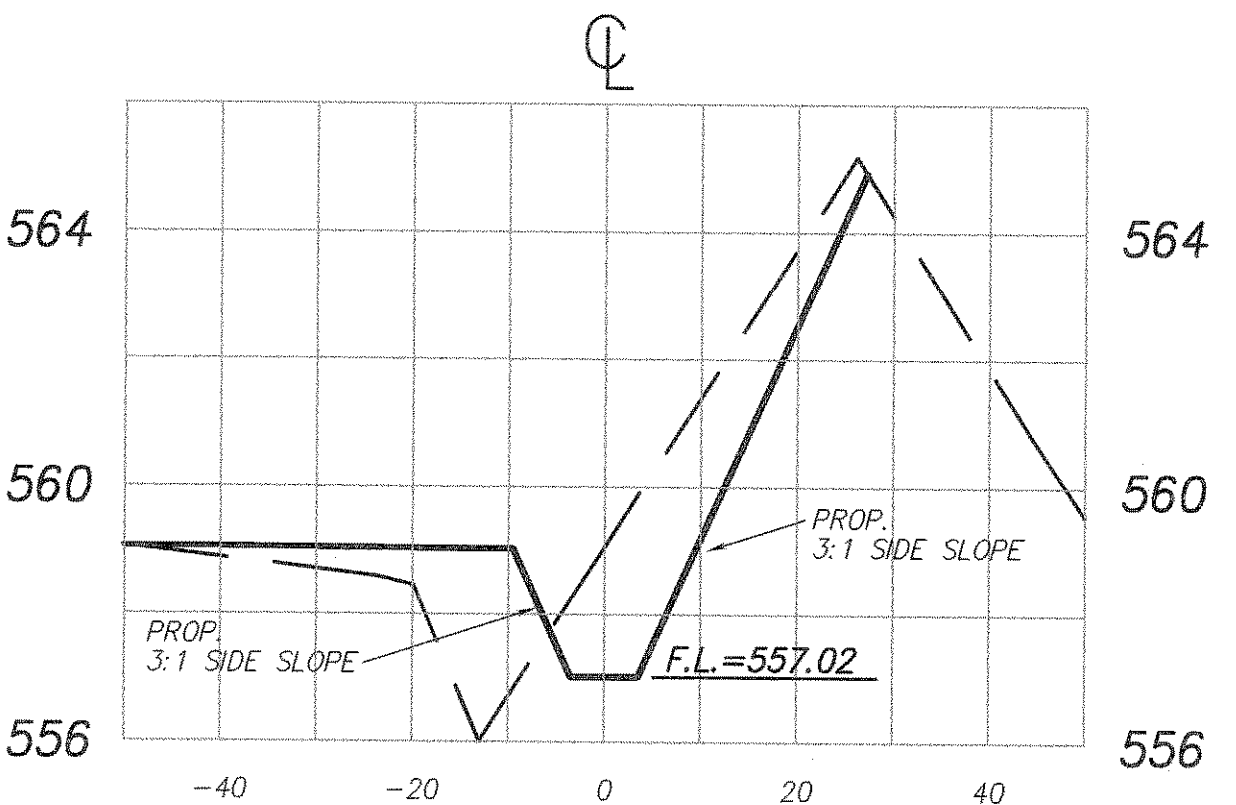

4+00

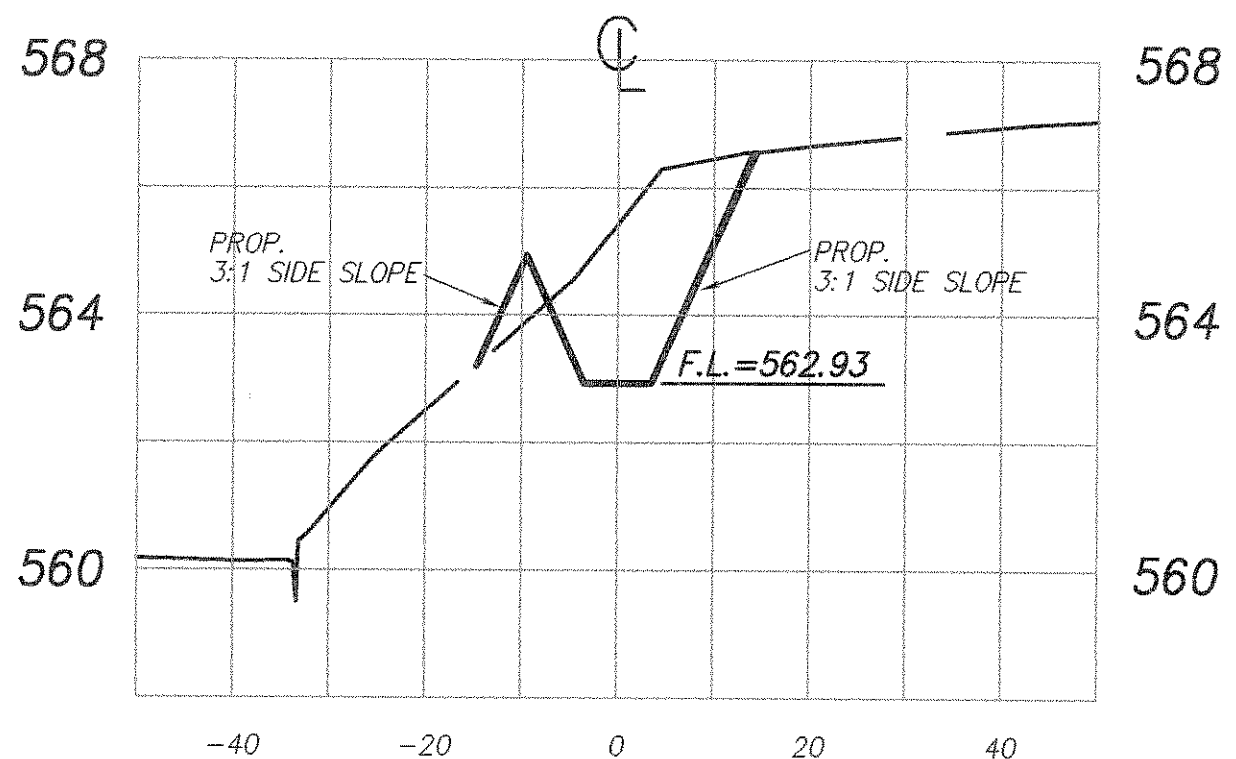

5+50

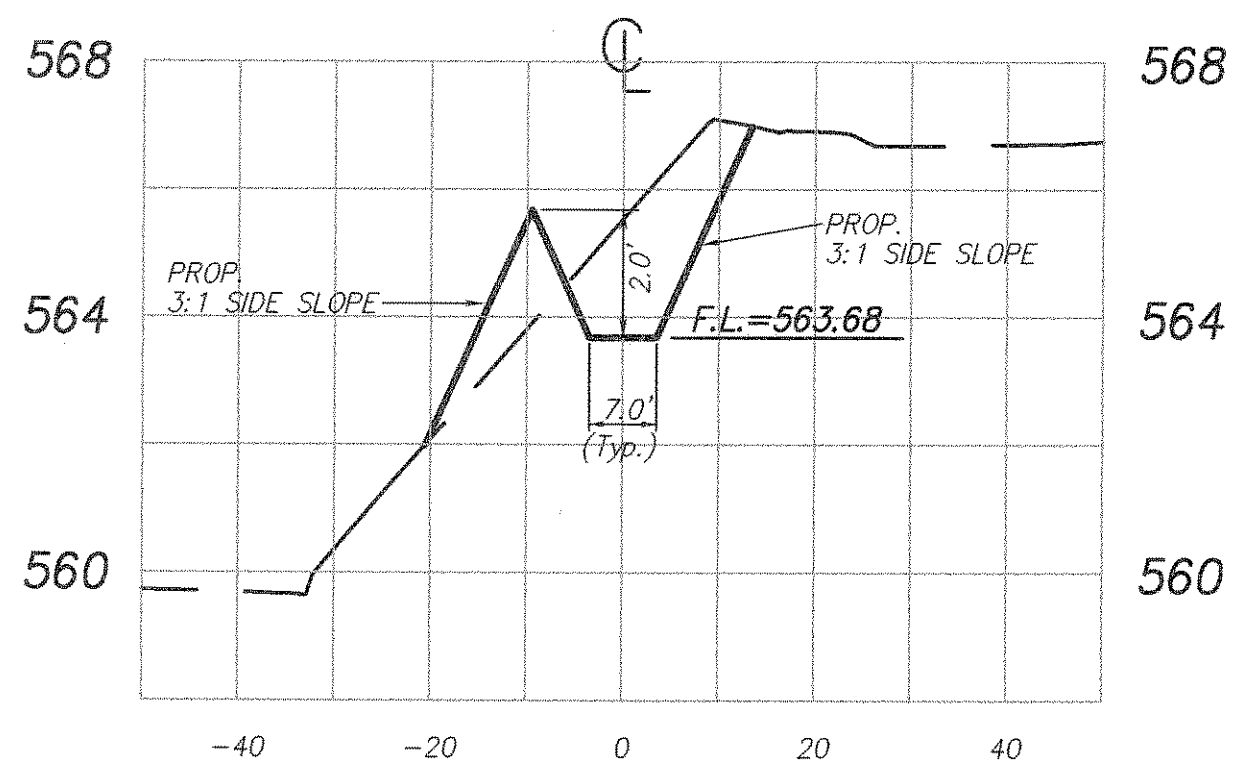

SCALE :
1" = 20' HORZ.
1" = 3' VERT.

CROSS SECTIONS
ROCKWALL SERVICE CENTER
ROCKWALL, TEXAS
CITY OF ROCKWALL
"THE NEW HORIZON"

REVISION NO.	REMARKS	DATE

DESIGNED: B.W.H.	THE SEAL APPEARING ON THIS DOCUMENT WAS AUTHORIZED BY W.L. DOUPHRATE II TEXAS P.E. NO. 60102 ON 5/5/96
DRAWN: ACAD	
JOB NO.	
DATE: 3/9/96	SHEET NO. 5 of 5

