




**SECTION  
MANHOLE DETAILS**  
SCALE: 3/4"=1'-0"

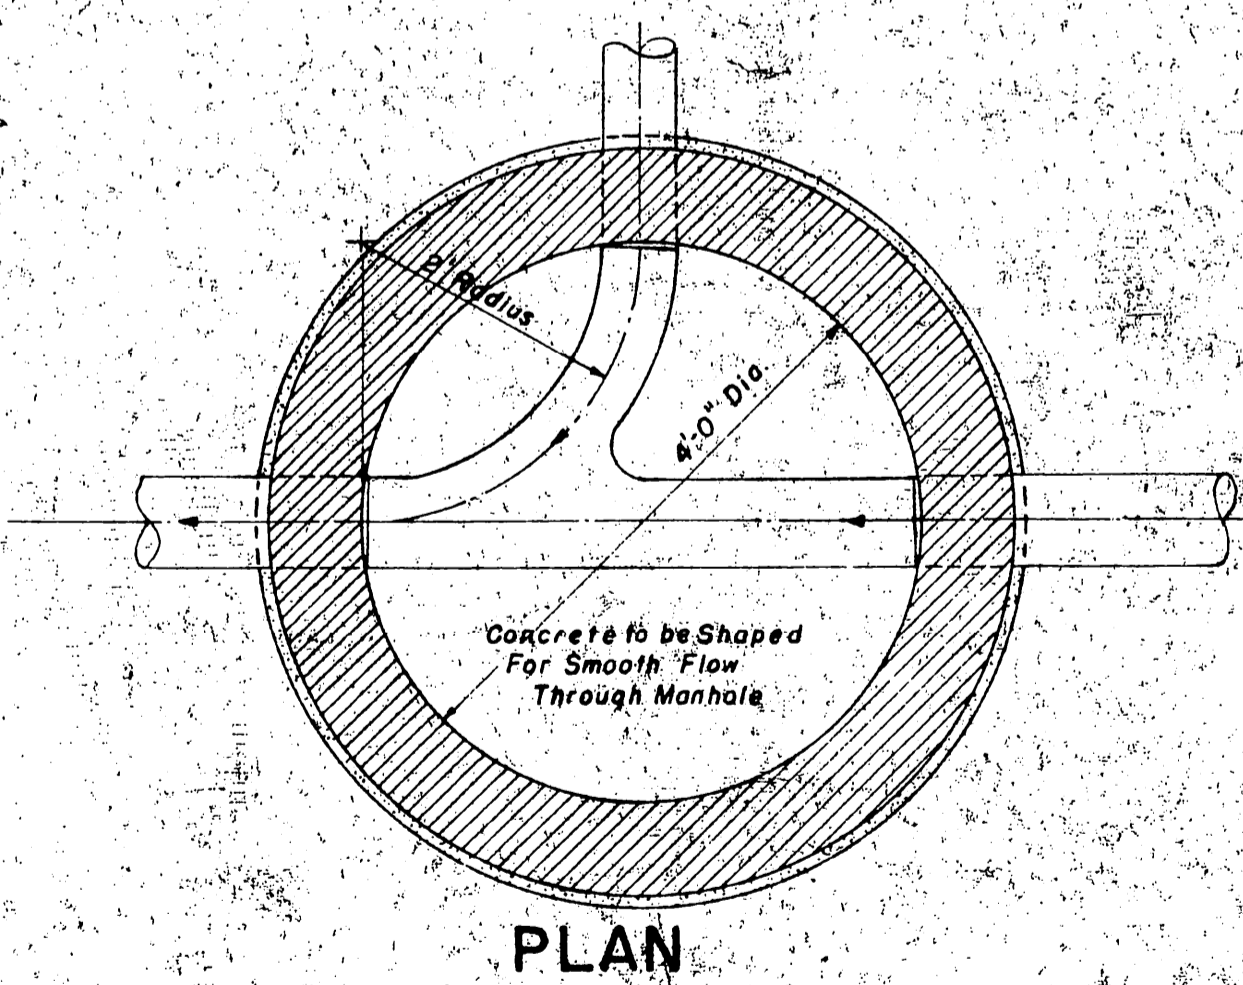


**PLAN**

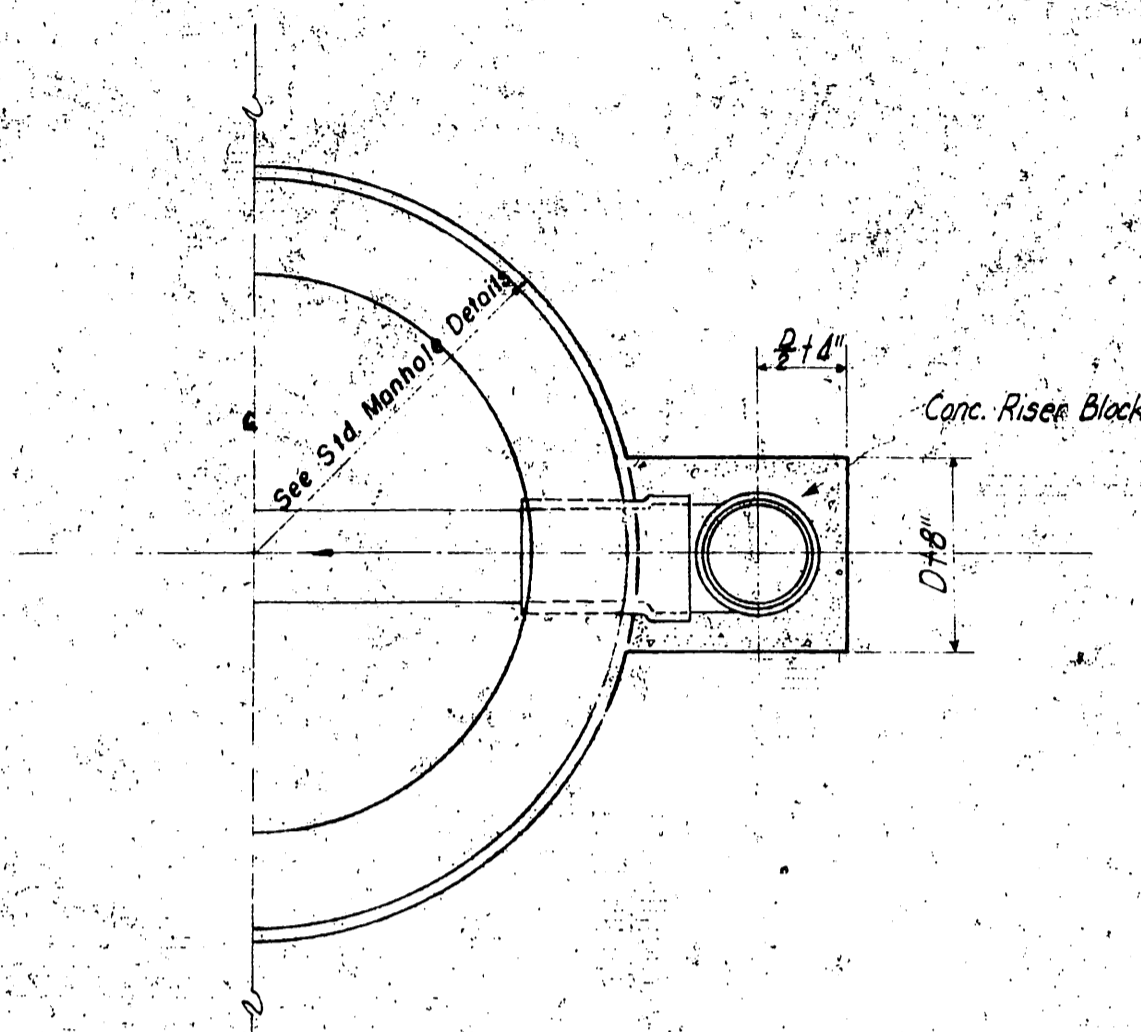


**PLAN OF MANHOLE  
DROP**  
DO NOT SCALE

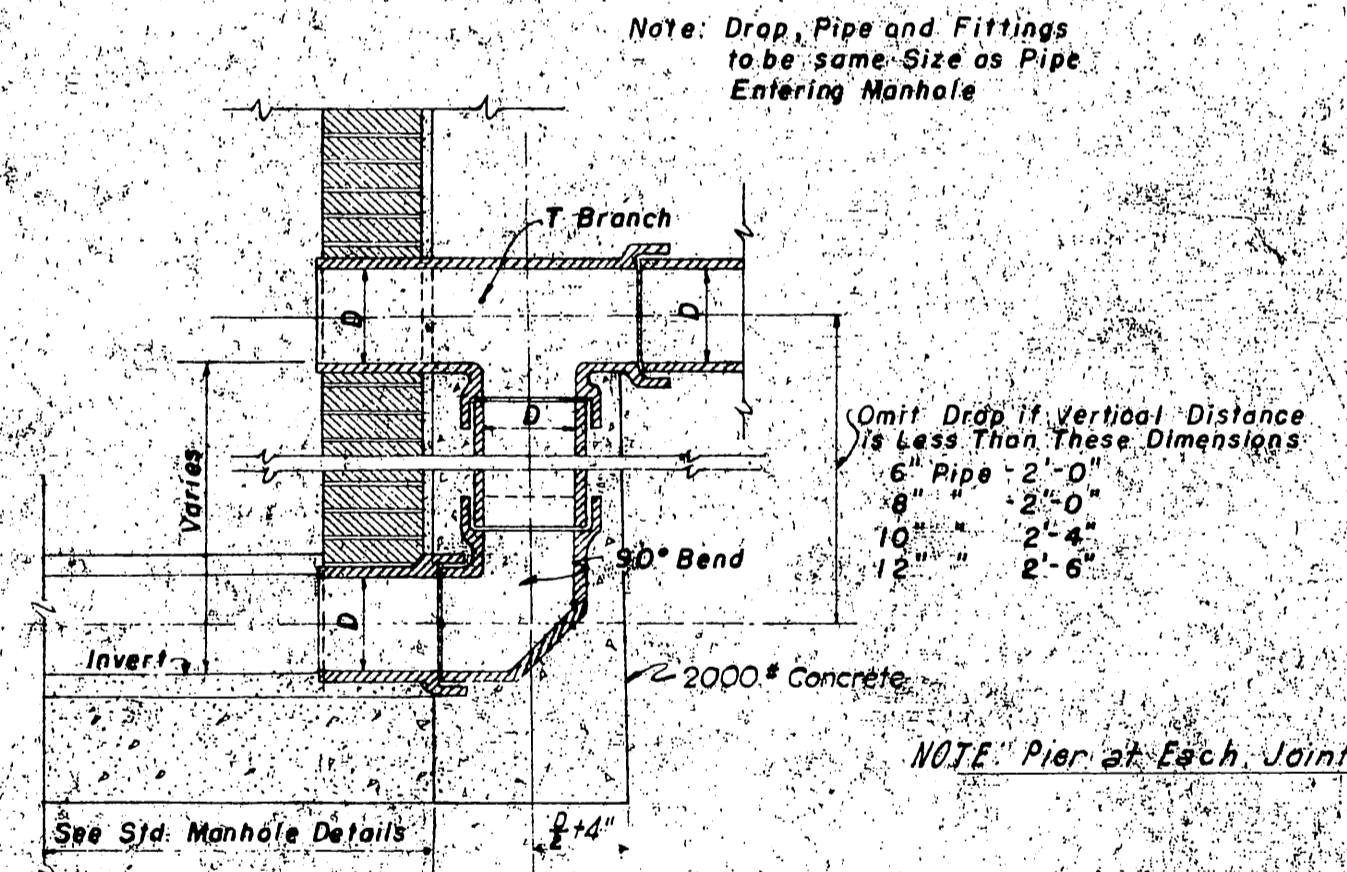


**DETAIL OF DROP FOR  
DROP MANHOLE**  
DO NOT SCALE

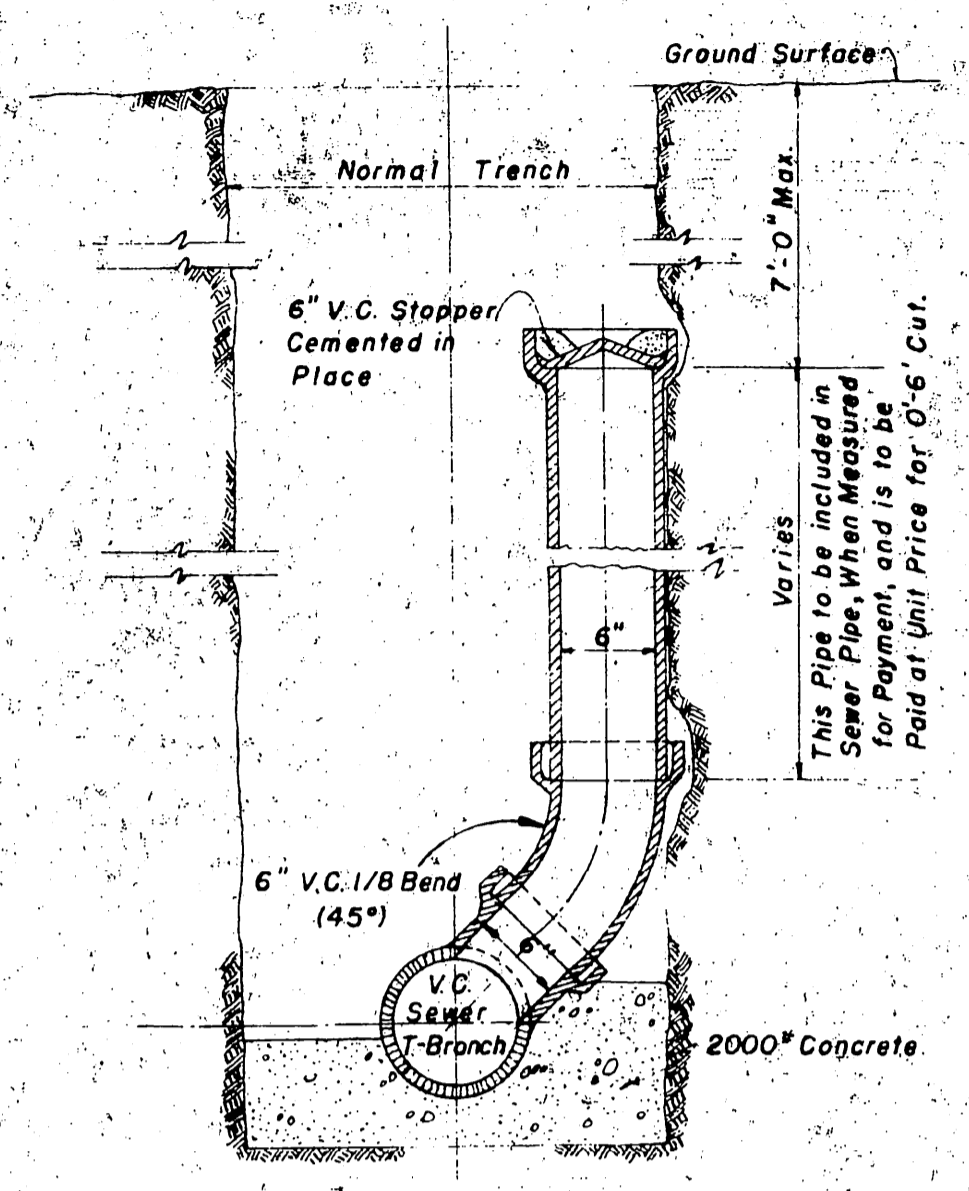


**DEEP CUT  
CONNECTION**  
DO NOT SCALE

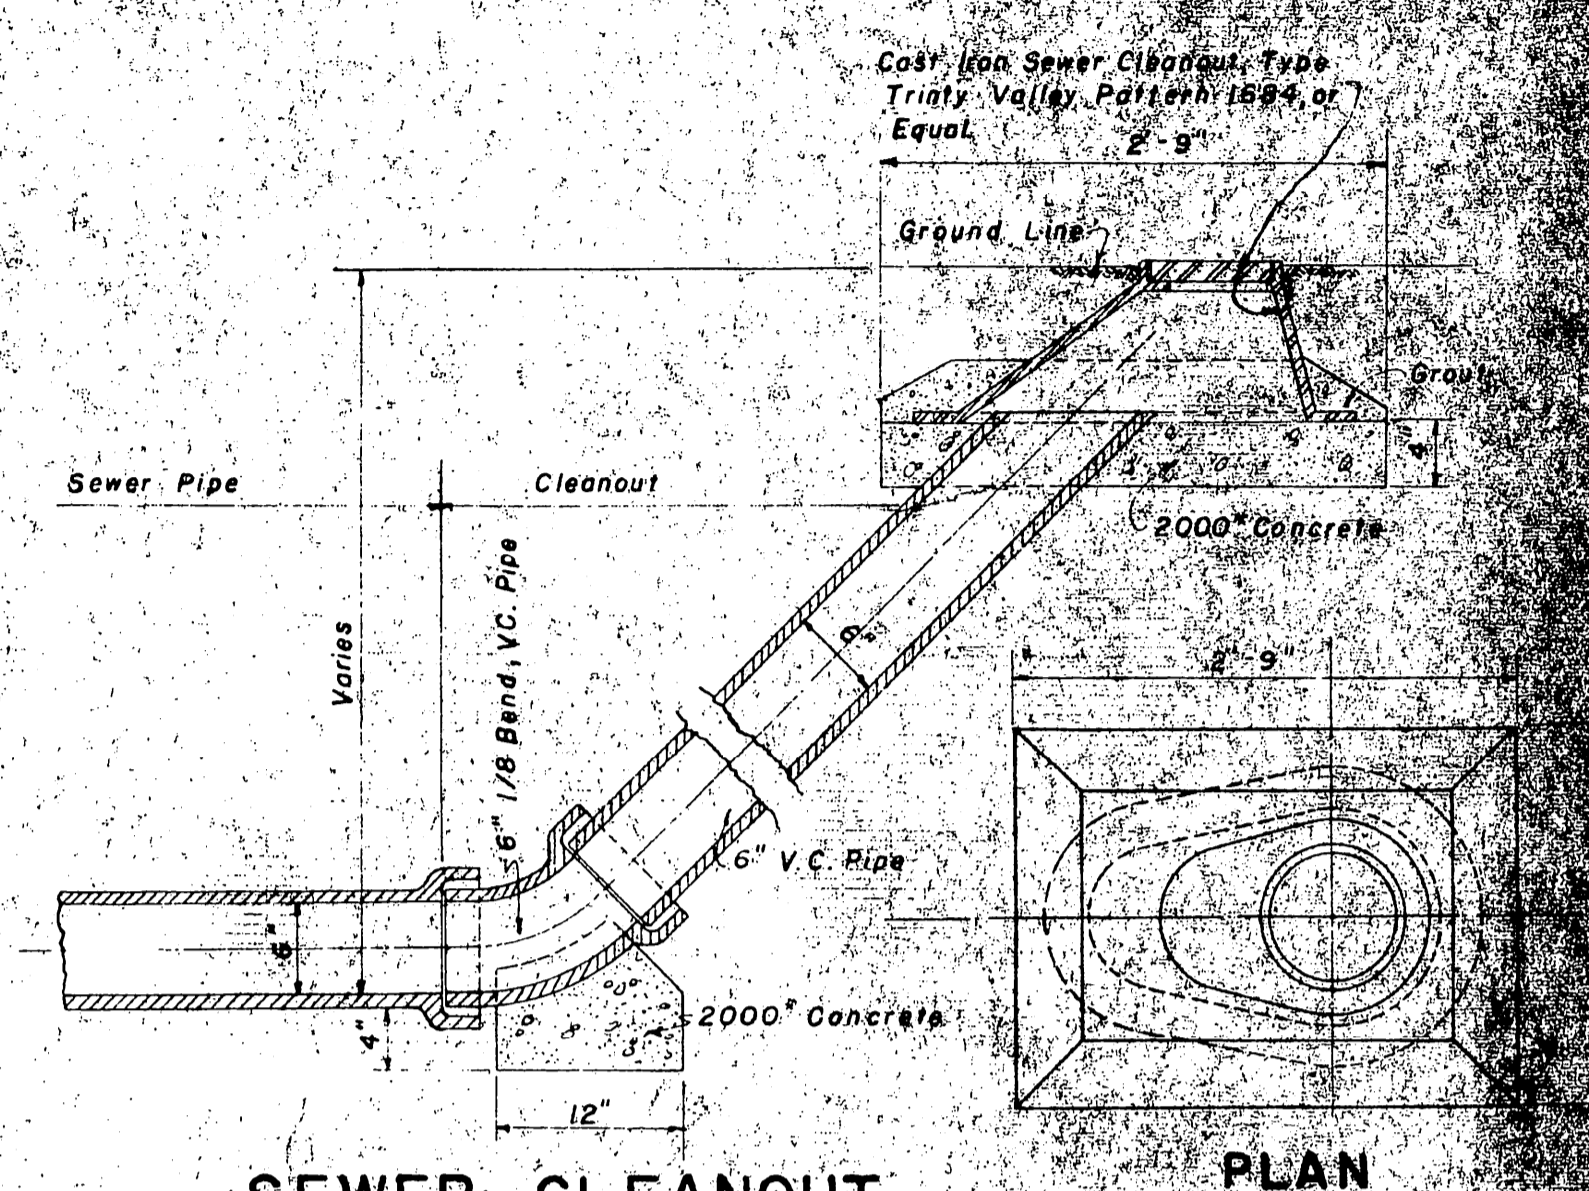

**SEWER CLEANOUT**  
SCALE: 1"=1'-0"

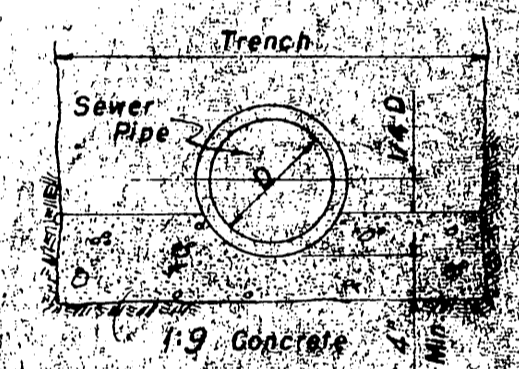

**SEWER GRADE**  
DO NOT SCALE

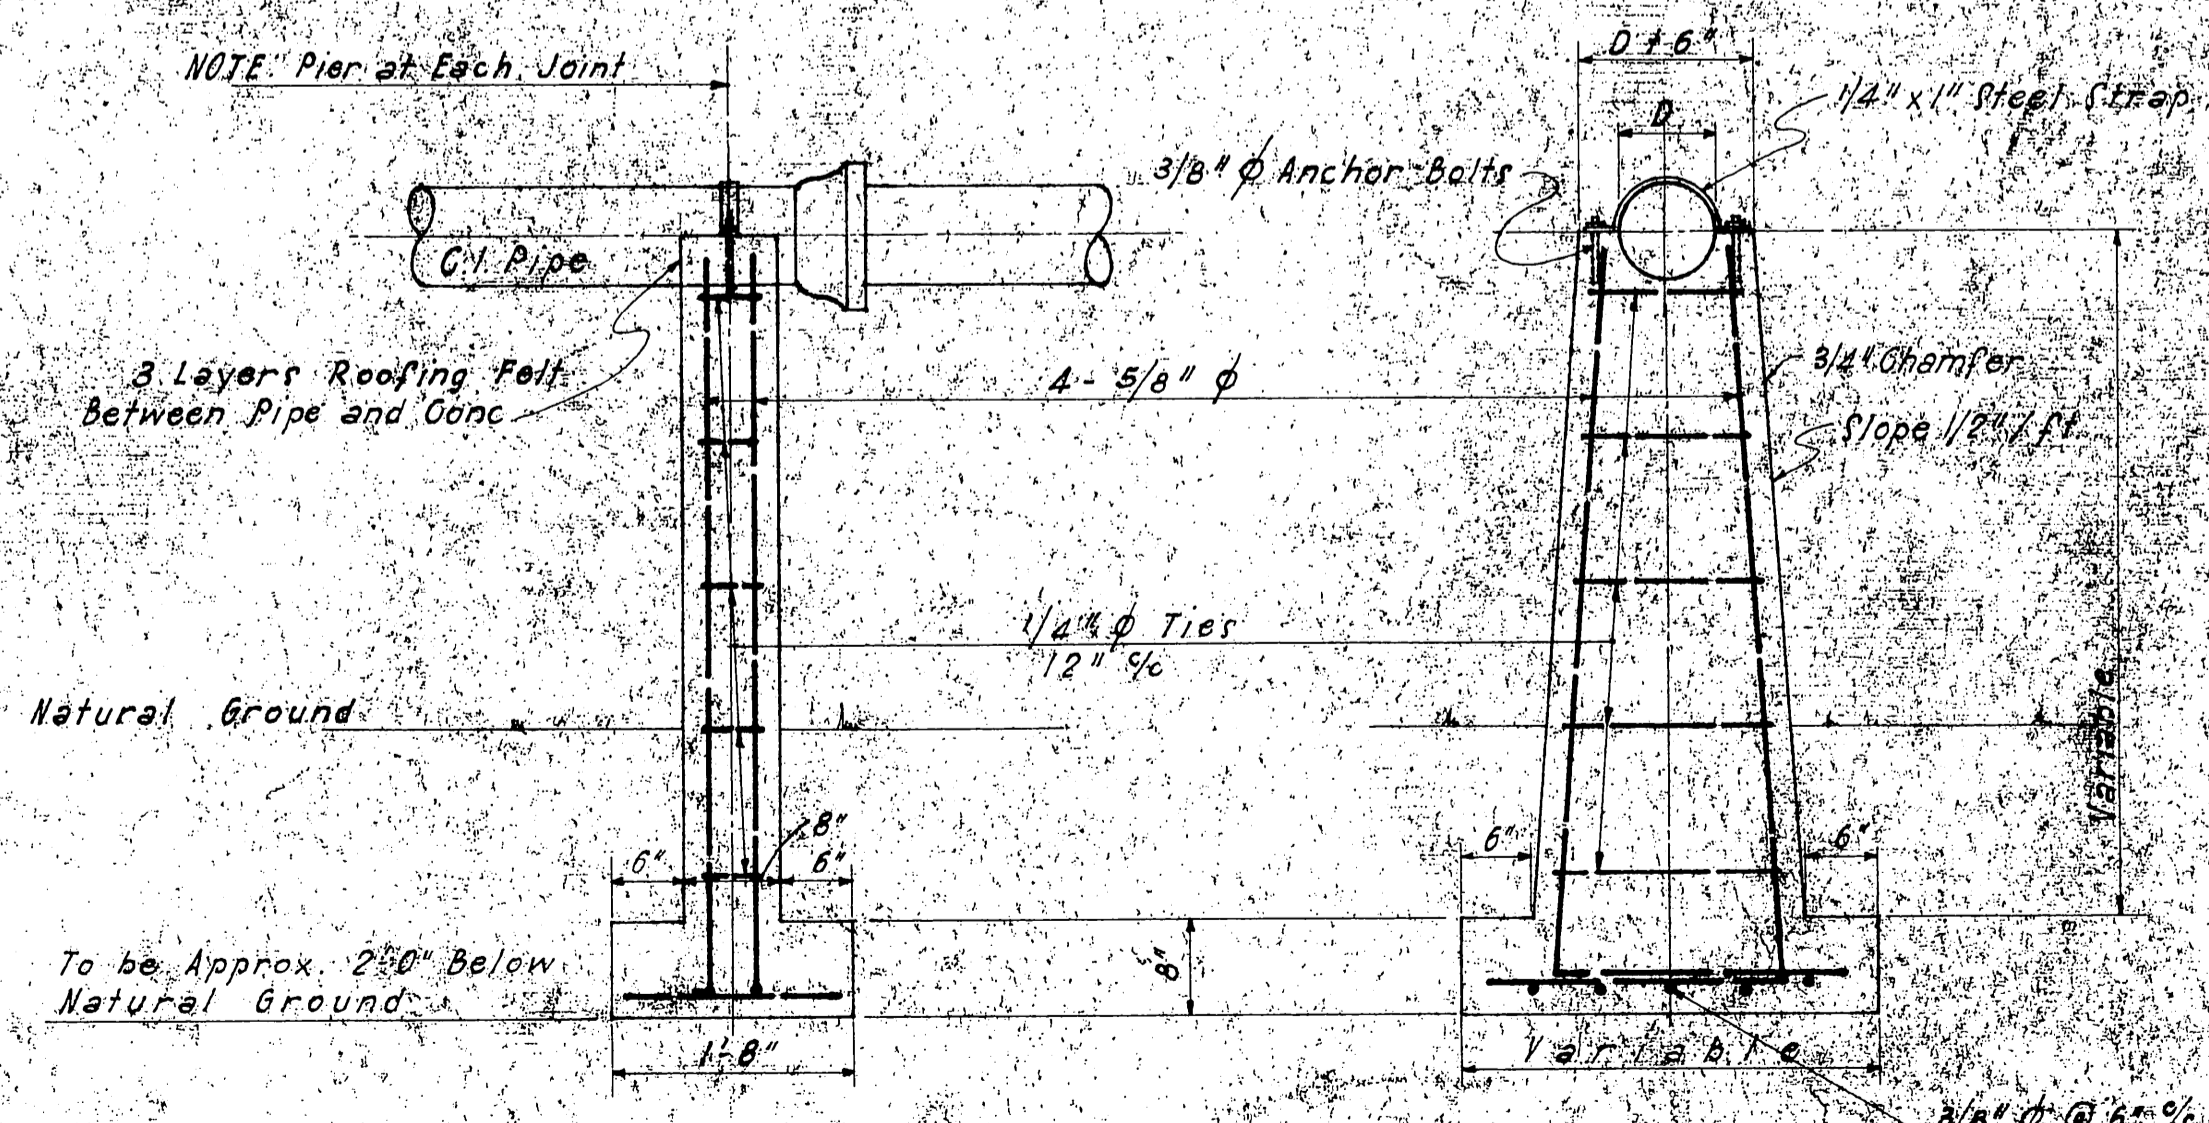

**PIER DETAILS**  
SCALE: 3/4"=1'-0"

**AS BUILT FOR  
ROCKY MOUNTAIN  
IMPROVED  
SEWERAGE SYSTEM  
DETAILS**

FREEZE WORDS