
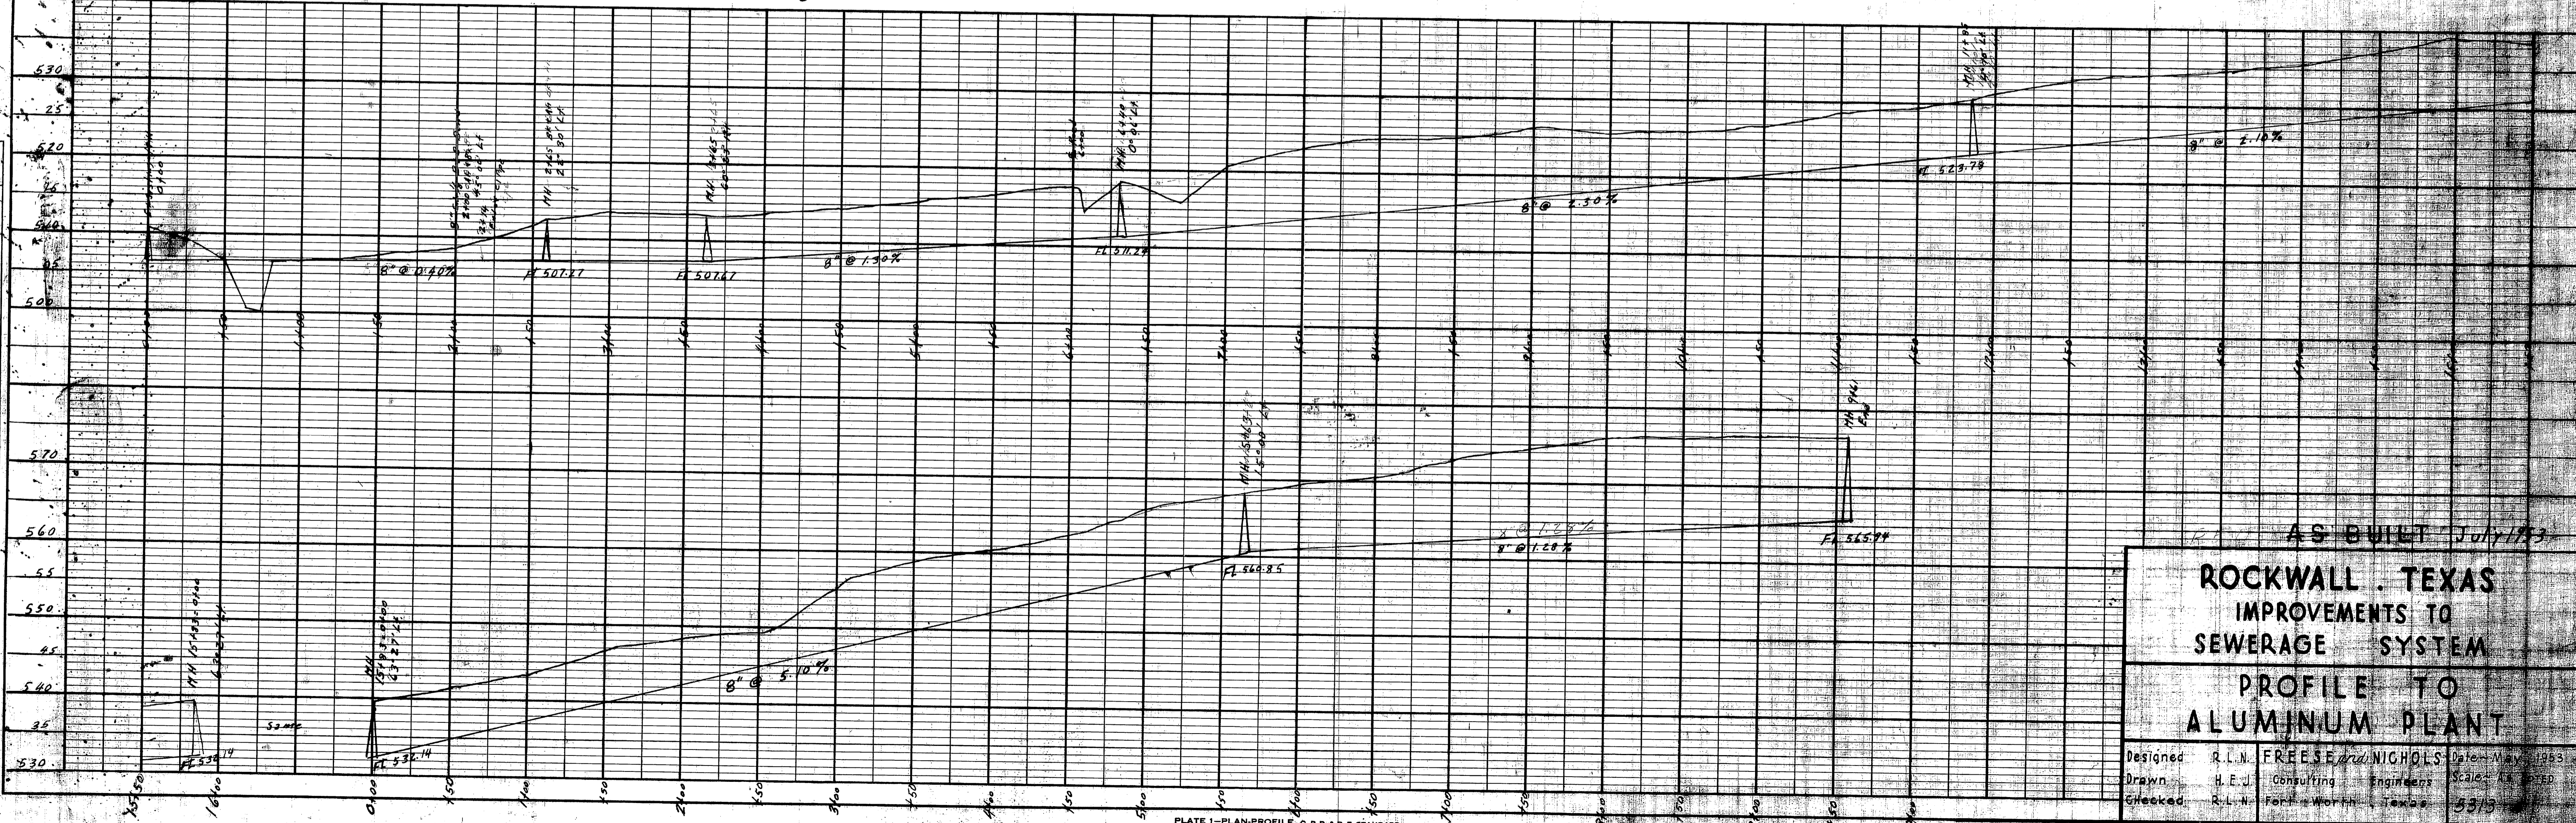


| DATE              | BY     |
|-------------------|--------|
| 8-23-51           | H.A.R. |
| 8-23-51           | H.E.J. |
| 8-23-51           | H.E.J. |
| 8-23-51           | H.E.J. |
| PLAN              | NO.    |
| SURVEYED          |        |
| PLOTTED           |        |
| REVISIONS CHECKED |        |
| BY                |        |
| DATE              |        |

| DATE                       | BY     |
|----------------------------|--------|
| 8-23-51                    | H.A.R. |
| 8-23-51                    | H.E.J. |
| 8-23-51                    | H.E.J. |
| PROFILE                    | NO.    |
| SURVEYED                   |        |
| GRASSES CHECKED            |        |
| S.M. NOTED                 |        |
| STRUCTURE INDICATING CIVIL |        |
| BY                         |        |
| DATE                       |        |

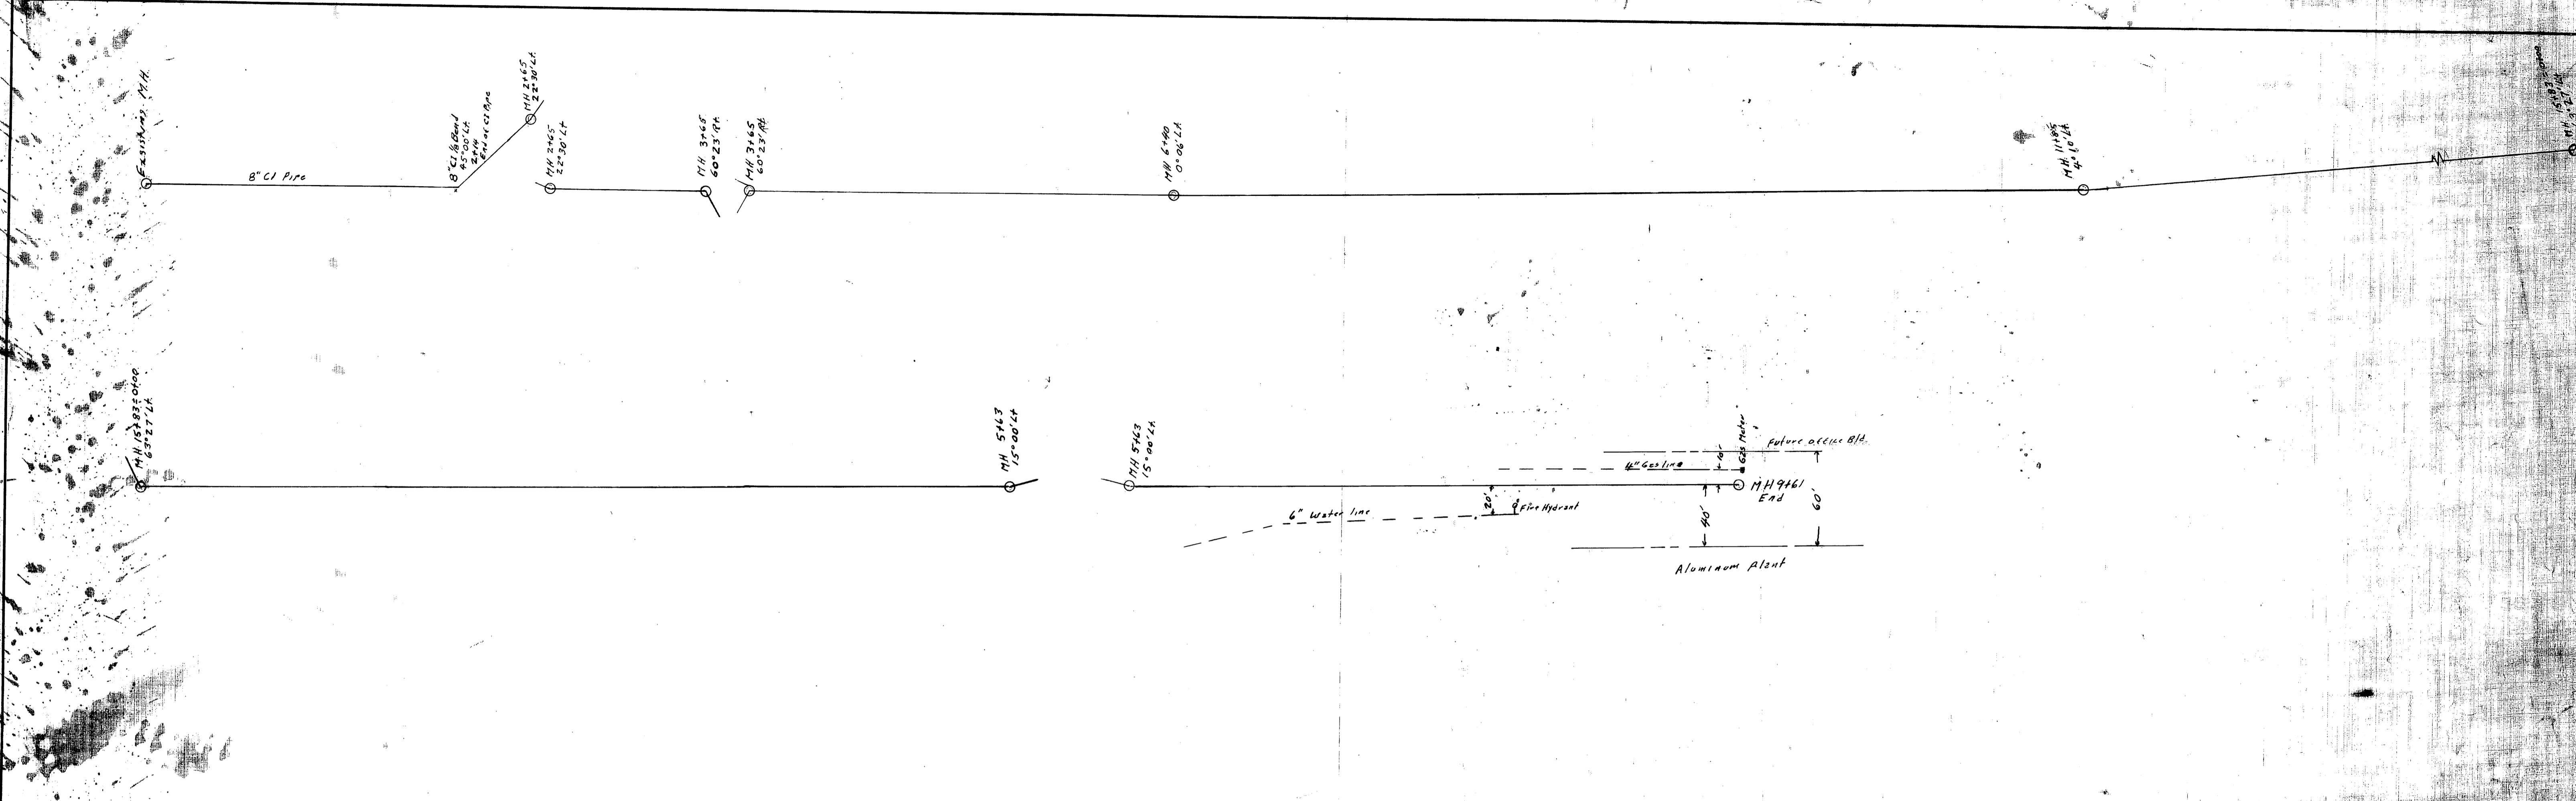

**AS BUILT July 1953**  
**ROCKWALL, TEXAS**  
**IMPROVEMENTS TO**  
**SEWERAGE SYSTEM**  
**PROFILE TO**  
**ALUMINUM PLANT**

|          |                             |       |           |
|----------|-----------------------------|-------|-----------|
| Designed | R.L.N. FREESE and NICHOLS   | Date  | July 1953 |
| Drawn    | H.E.J. Consulting Engineers | Scale | As Shown  |
| Checked  | R.L.N. Forth Worth, Texas   |       |           |