


7-3-84	DESIGNED	J.S.S.	JOB NO.	NTD 83099B	FRESE AND NICHOLS CONSULTING ENGINEERS FORT WORTH-AUSTIN, TEXAS	NORTH TEXAS MUNICIPAL WATER DISTRICT WATER TRANSMISSION SYSTEM	ROCKWALL STATION TO CASH PIPELINE PLAN AND PROFILE	SHEET 4 OF 11
7-3-84	DRAWN	J.C.C.	DATE	1984				
	TRACED	J.E.C.	SCALE	AS SHOWN				
	CHECKED	J.A.R.						

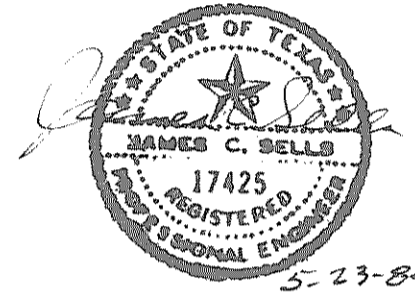

DATE 9/30/85 JCF