

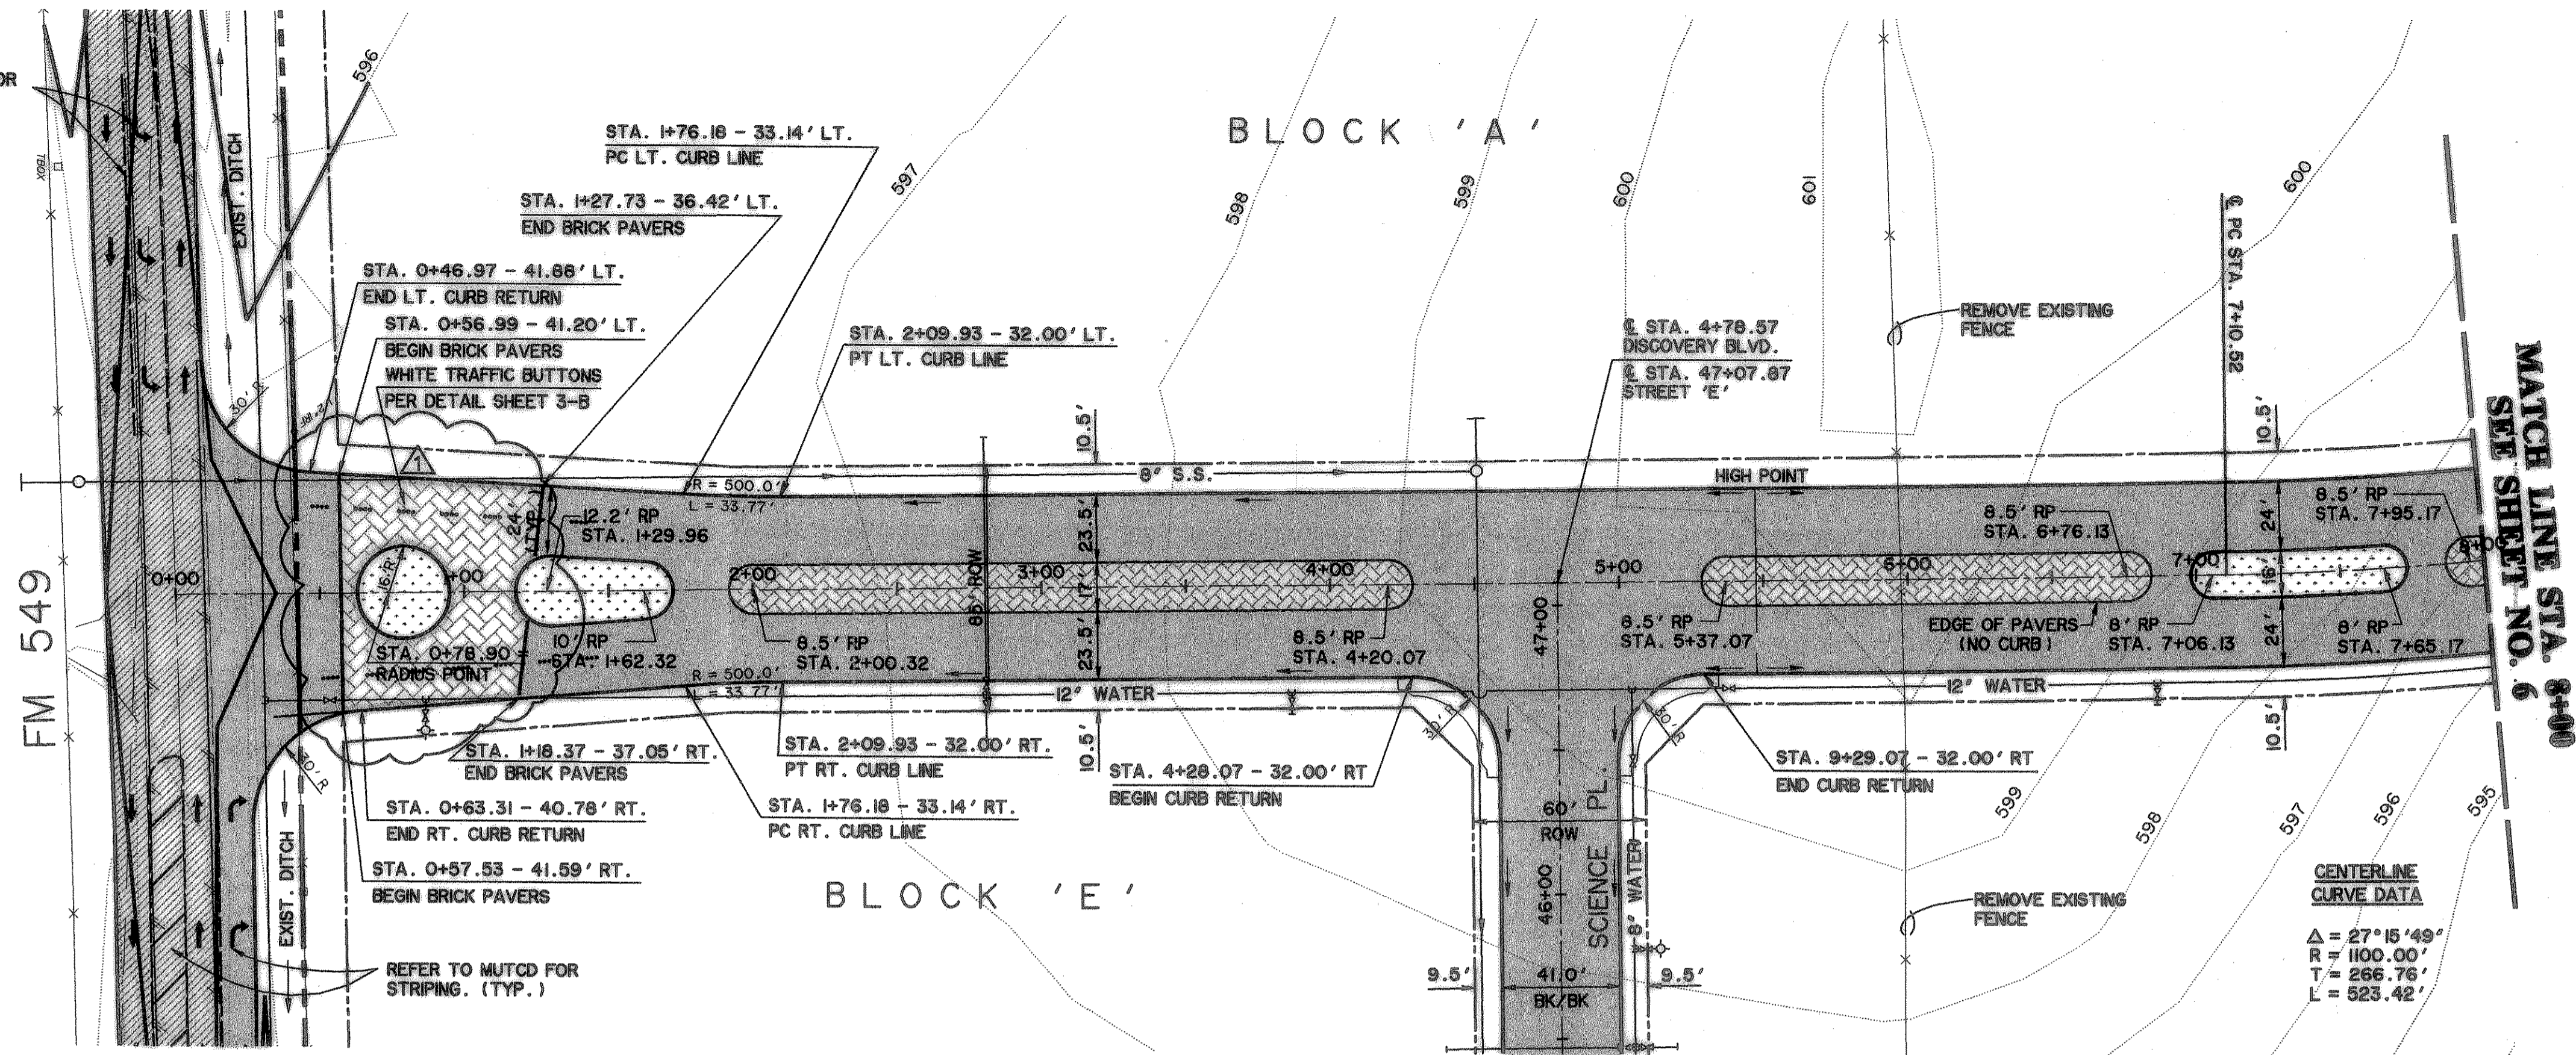



REFER TO MUTCD FOR STRIPING (TYP.)

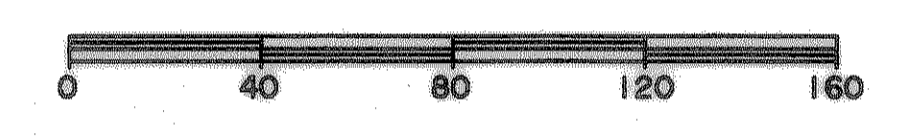

BENCHMARKS:
 CITY MON. NO. 2
 LOCATED ON THE NORTHWEST CORNER OF THE BRIDGE @ I-30 AND F.M. 549
 ELEVATION 609.56
 "C" CUT IN THE CENTER OF A 4 FOOT HEADWALL LOCATED AT THE NORTHEAST CORNER OF F.M. 549 AND STATE HIGHWAY 276
 ELEVATION 592.75

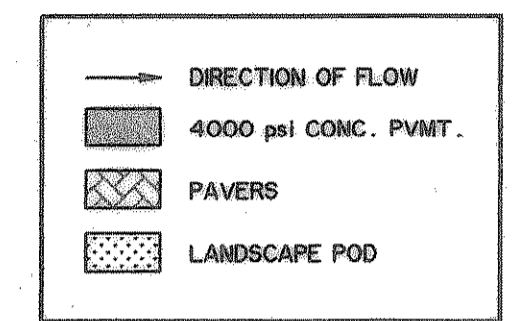


DISCOVERY BOULEVARD

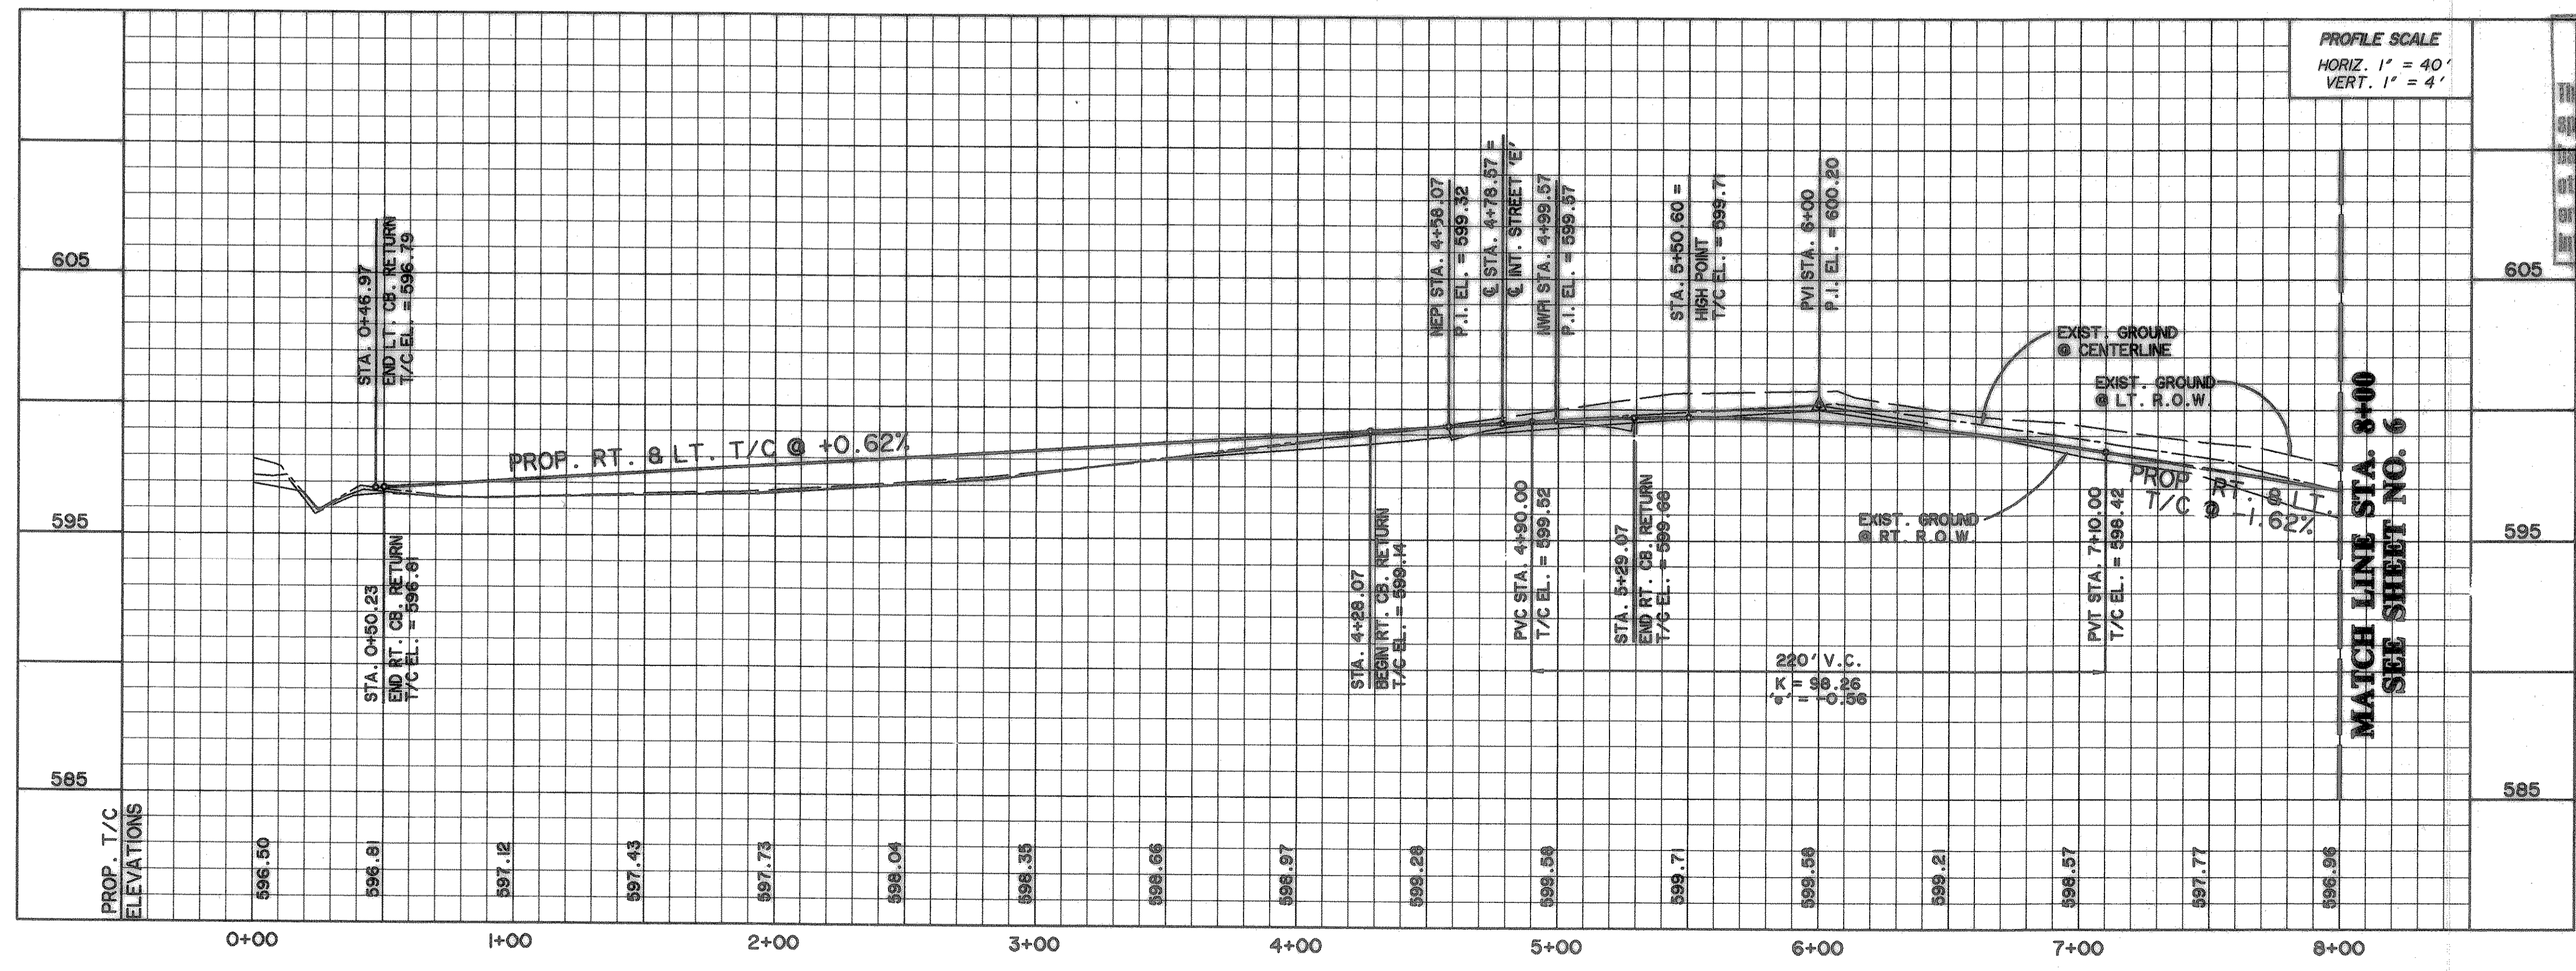

RECORD DRAWINGS


These as-built or record drawings (or corrected specifications) have been prepared, in part, on the basis of information compiled and furnished by others. The Engineer will not be responsible for any errors or omissions which have been incorporated in this document as a result.

PREPARED BY:
WIER & ASSOCIATES, INC.
 ENGINEERS SURVEYORS LAND PLANNERS
 4300 BELLEVUE PLACE SUITE 530 ARLINGTON, TEXAS 76010 (817) 467-7700
 4108 WHEAT CREEK BLVD. SUITE 200 FORT WORTH, TEXAS 76105 (817) 355-4457

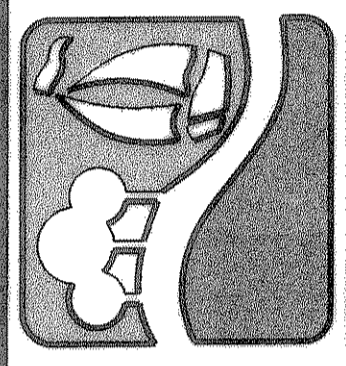

ROCKWALL TECHNOLOGY PARK

DISCOVERY BLVD PAVING PLAN & PROFILE
 STA. 0+00 TO STA. 8+00

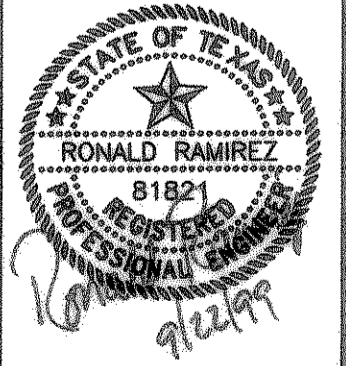

COPYRIGHT © WIER & ASSOCIATES, INC.
 LAST SHEET EDITED
 DATE: 09-22-99
 DRAWN: 9904
SHEET NO. 5

ADD BRICK PAVERS AT MAIN ENTRANCE.
 RELOCATE LANDSCAPE POD AT ENTRANCE. 09/13/99