



MATCH LINE - SEE SHEET NO. 41-B

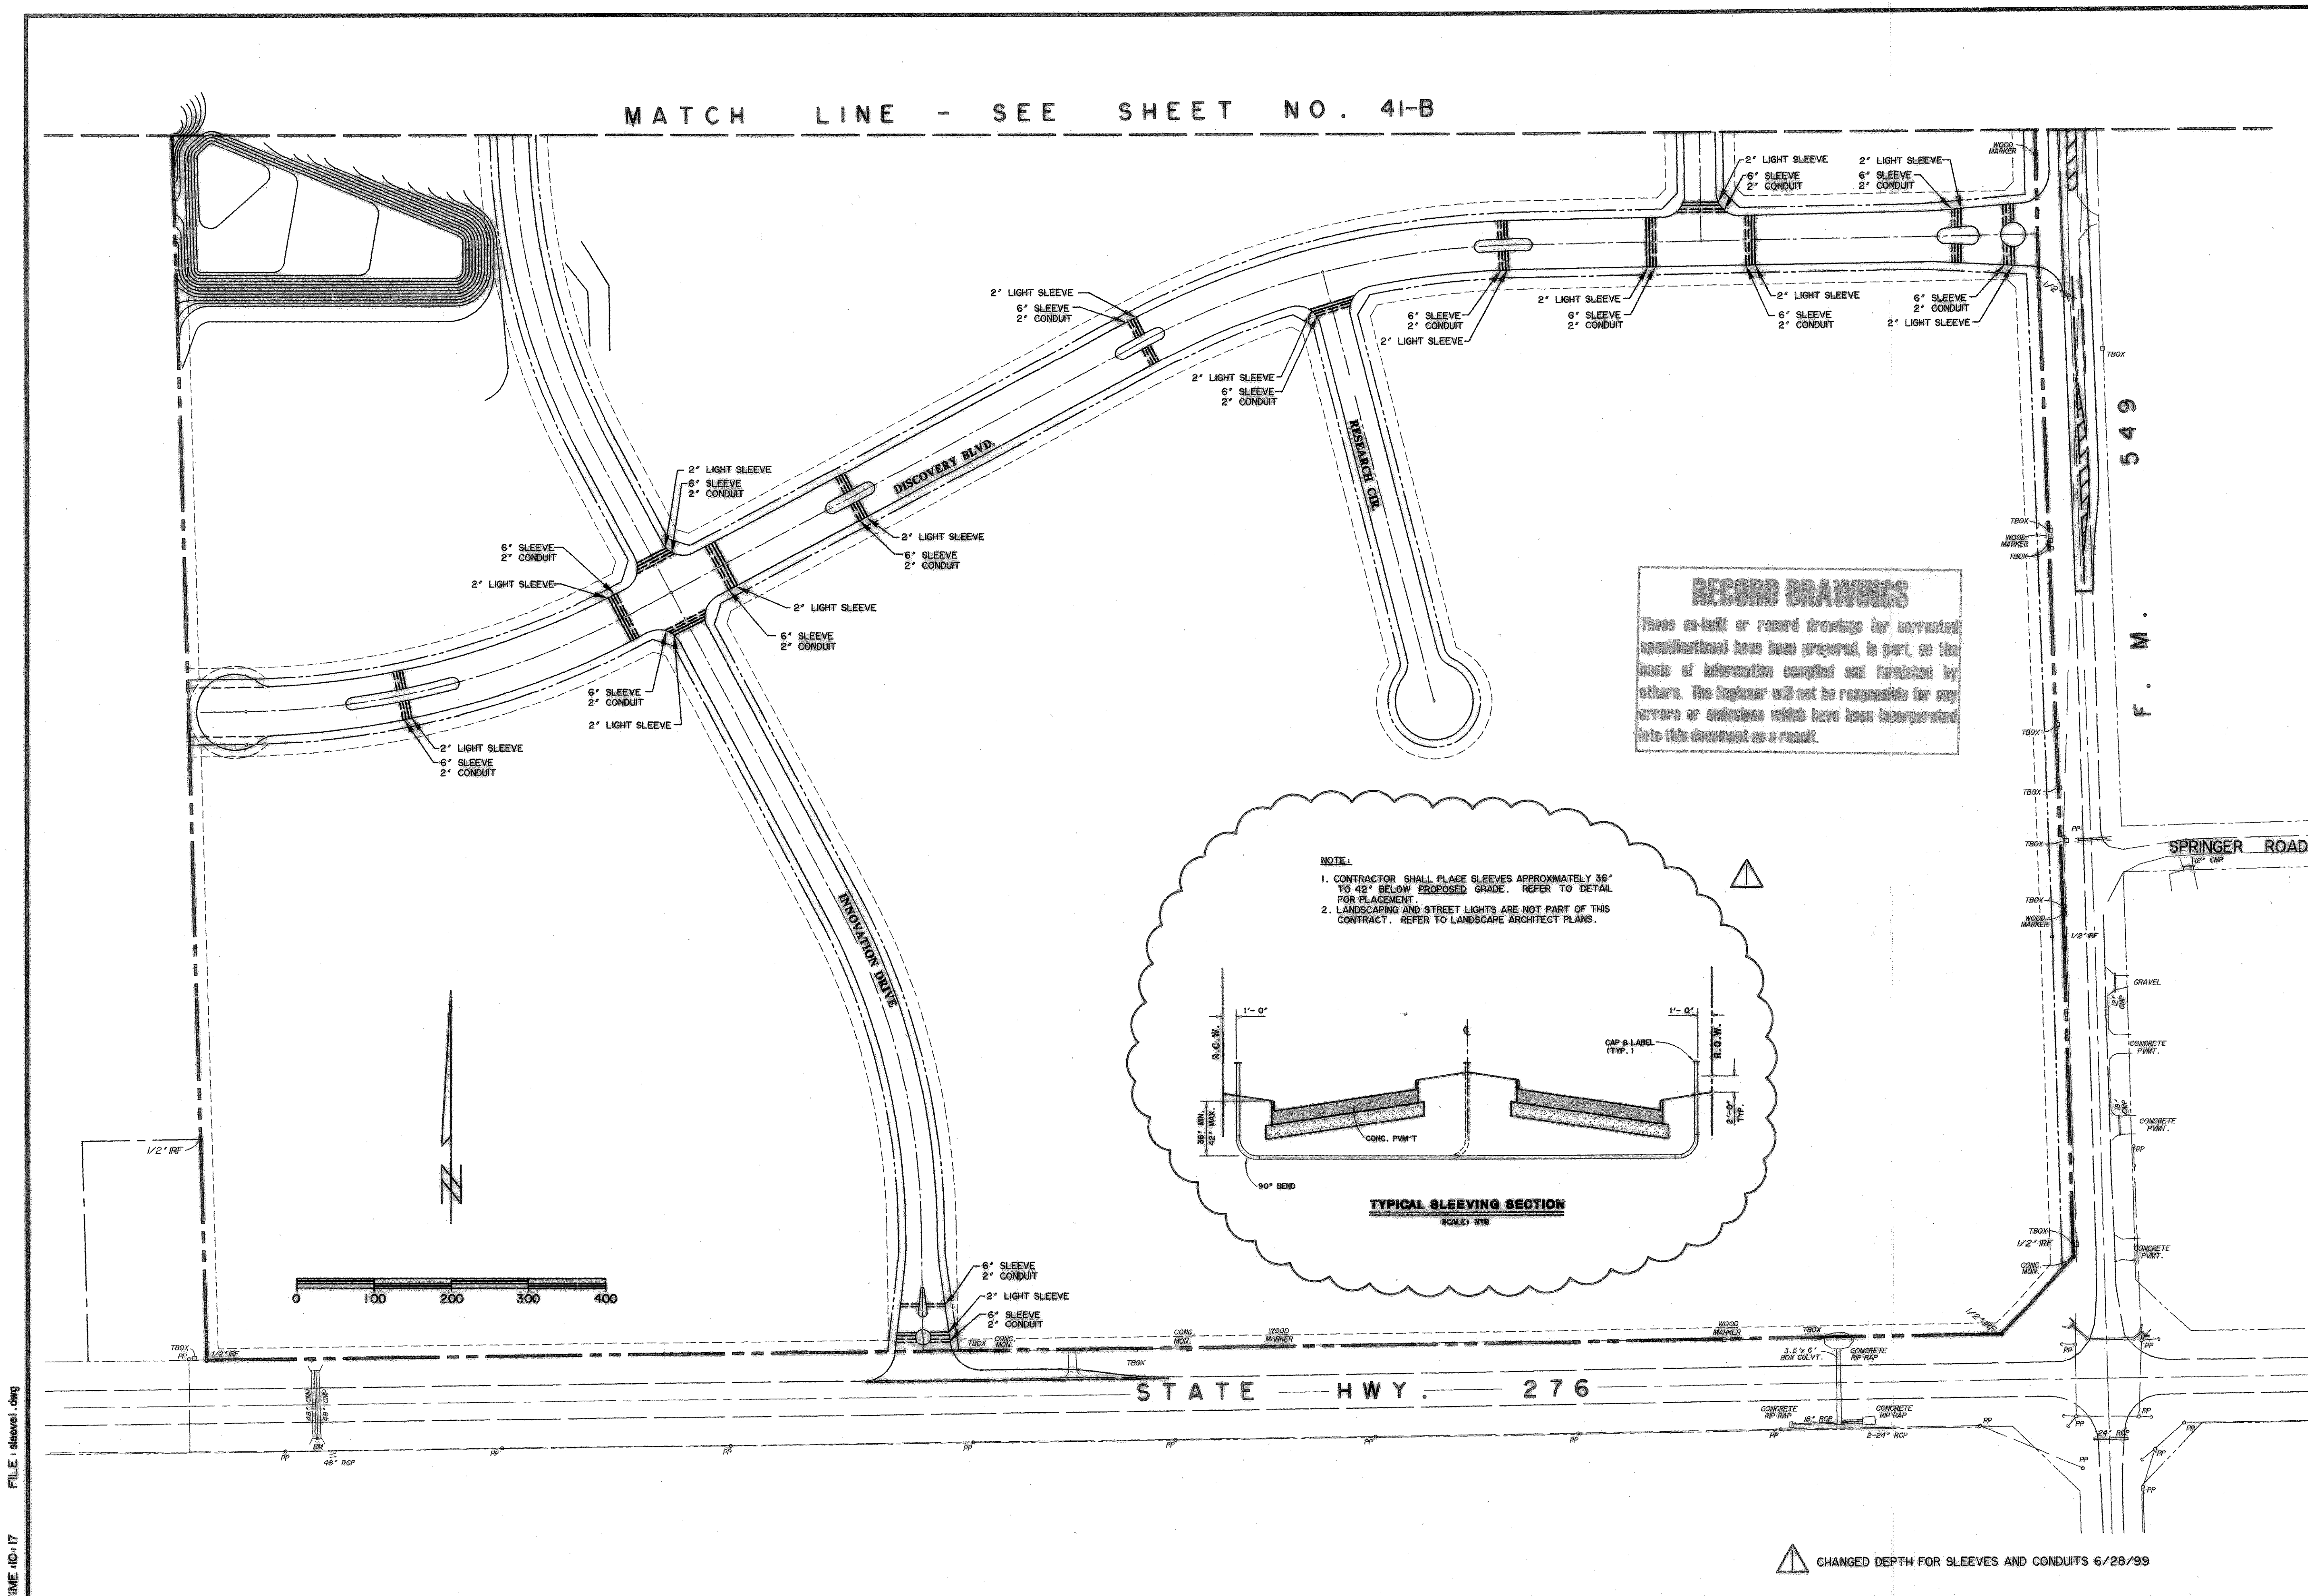


RECORD DRAWINGS
 These as-built or record drawings (or corrected specifications) have been prepared, in part, on the basis of information compiled and furnished by others. The Engineer will not be responsible for any errors or omissions which have been incorporated into this document as a result.

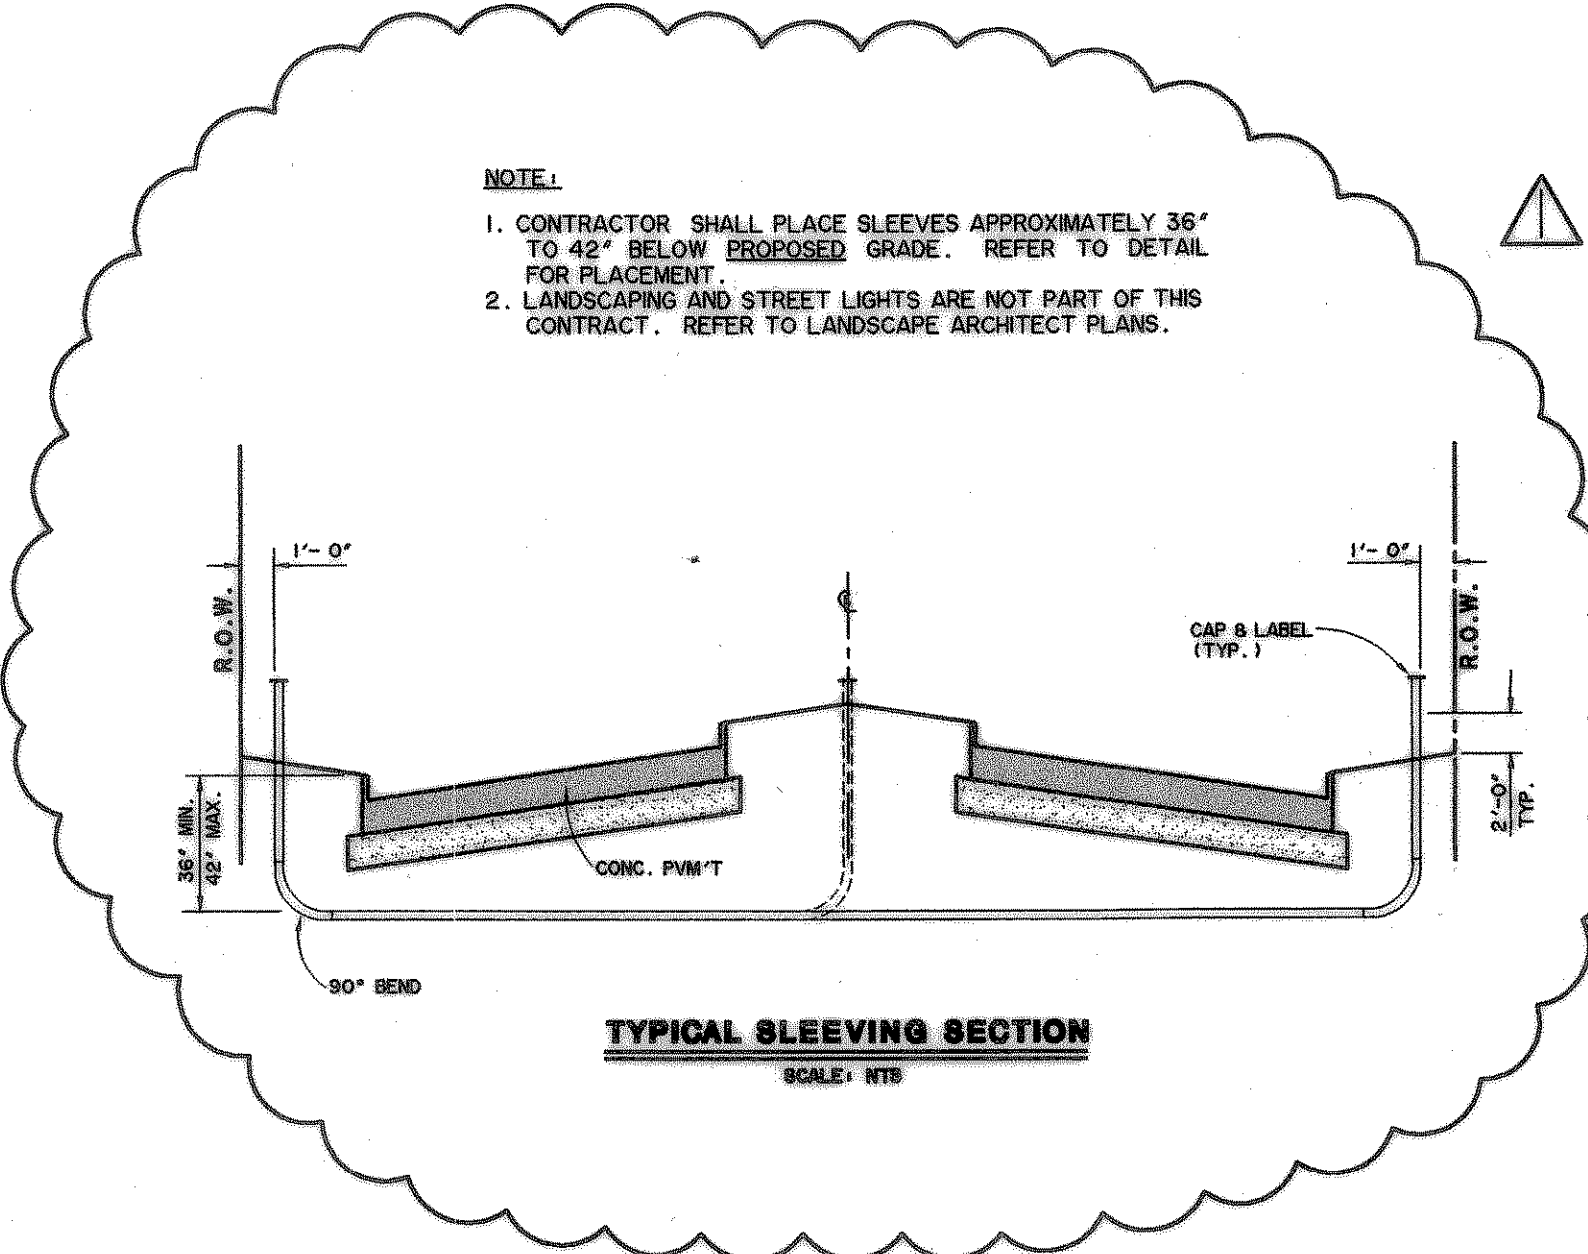


TIME: 10:17 FILE: sleeves.dwg

PREPARED BY:
WIER & ASSOCIATES, INC.
 ENGINEERS SURVEYORS LAND PLANNERS
 4300 BELTWAY PLACE SUITE 130 ARLINGTON, TEXAS 76010 METRO (817) 467-7700
 4108 AMAR CENTER BLVD. SUITE 200 FORT WORTH, TEXAS 76105 METRO (817) 356-4437

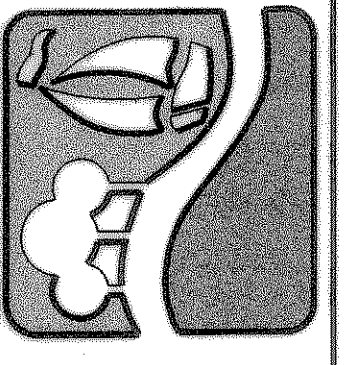

ROCKWALL TECHNOLOGY PARK

SLEEVE PLAN

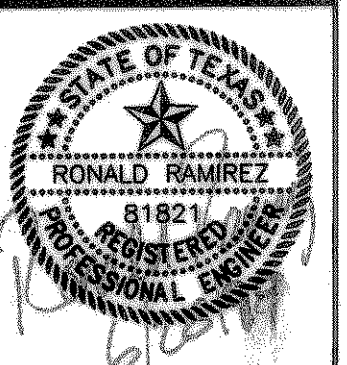

COPYRIGHT © WIER & ASSOCIATES, INC.
 LAST SHEET EDIT DATE 06-28-99
 WA# 99041

SHEET NO. 41-A

▲ CHANGED DEPTH FOR SLEEVES AND CONDUITS 6/28/99