


TIME 8:51 FILE: COORDBASE.dwg

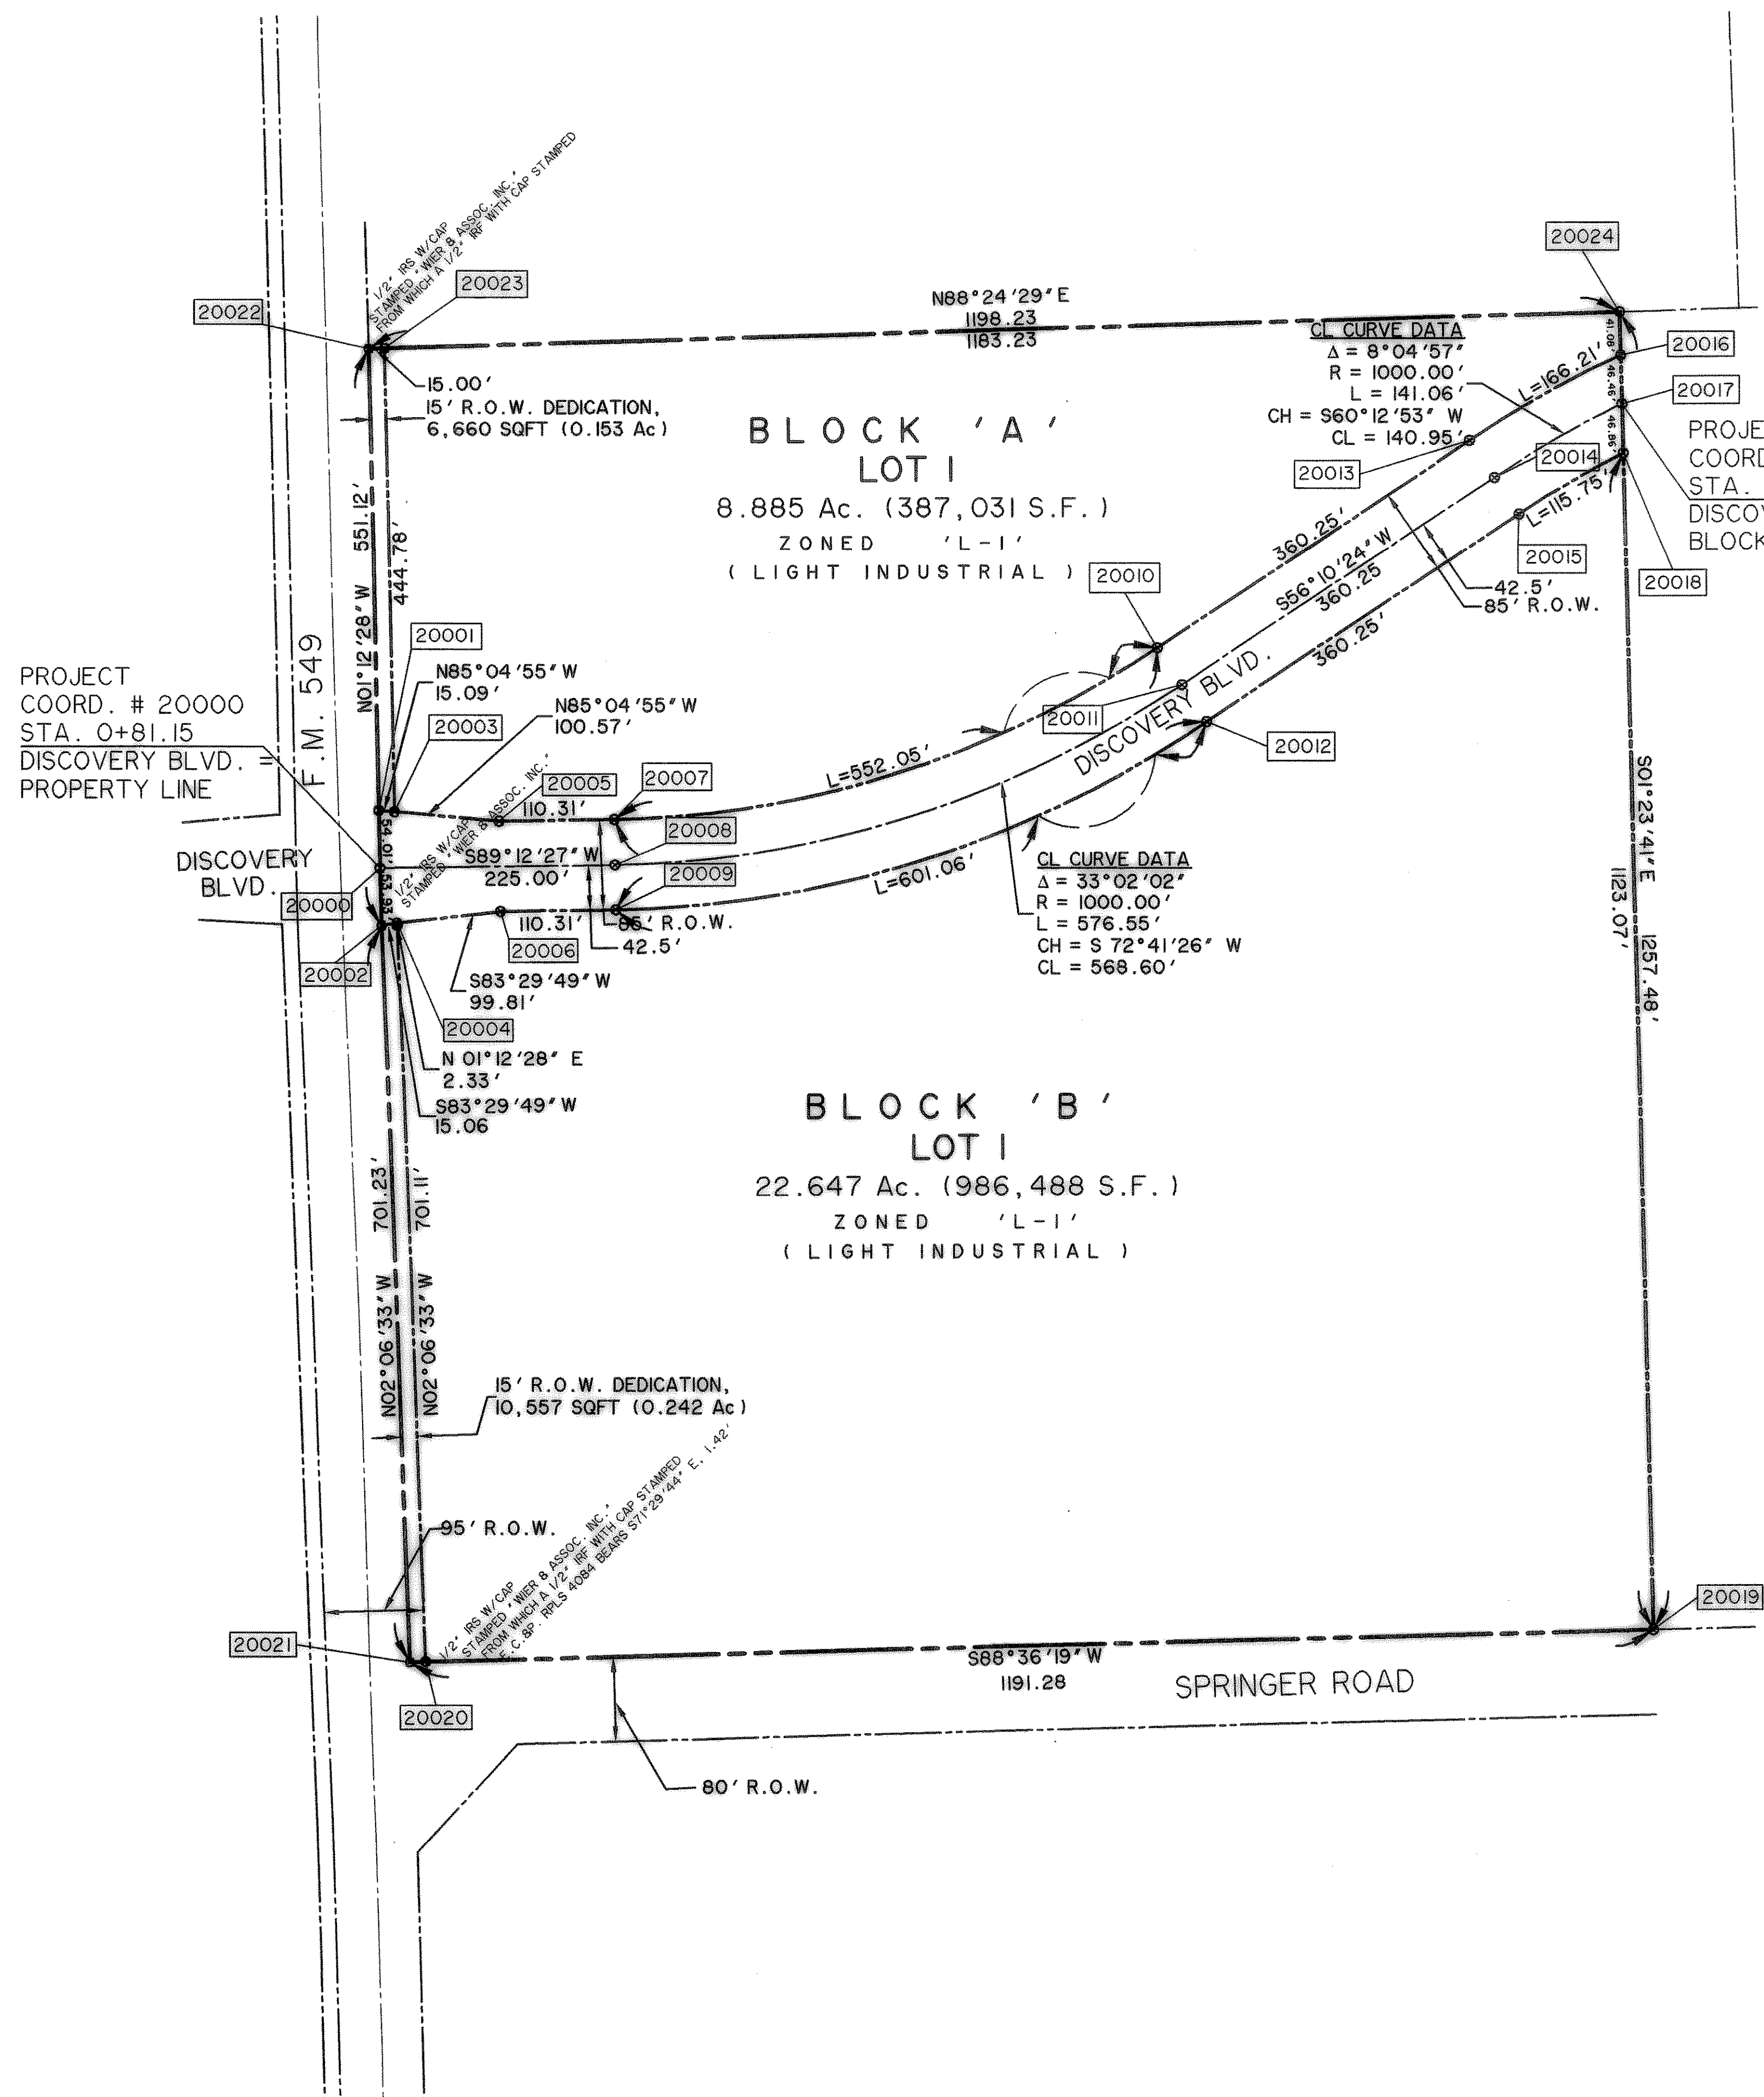


COORDINATE SCHEDULE		
DCP #	NORTHING	EASTING
20000	7020582.49	2607316.04
20001	7020636.49	2607314.90
20002	7020528.57	2607317.18
20003	7020635.20	2607329.93
20004	7020530.28	2607332.15
20005	7020626.58	2607430.14
20006	7020541.58	2607431.31
20007	7020628.10	2607540.43
20008	7020585.61	2607541.02
20009	7020543.11	2607541.61
20010	7020790.09	2608060.21
20011	7020754.78	2608083.87
20012	7020719.48	2608107.53
20013	7020990.63	2608359.48
20014	7020955.33	2608383.14
20015	7020920.02	2608406.80
20016	7021071.78	2608504.33
20017	7021025.34	2608505.46
20018	7020978.49	2608506.60
20019	7019855.75	2608533.94
20020	7019827.31	2607358.00
20021	7019826.76	2607343.01
20022	7021079.57	2607305.56
20023	7021079.88	2607320.56
20024	7021112.86	2608503.33

BENCHMARKS:
 CITY MON. NO. 2
 LOCATED ON THE NORTHWEST CORNER OF THE BRIDGE AT I-30 AND F.M. 549
 ELEVATION 609.56
 "C" CUT IN THE CENTER OF A 4 FOOT HEADWALL LOCATED AT THE NORTHEAST CORNER OF F.M. 549 AND STATE HIGHWAY 276
 ELEVATION 592.75

- NOTES:**
- FOR ADDITIONAL TIES AND GENERAL INFORMATION, SEE FINAL PLAT FOR ROCKWALL TECHNOLOGY PARK - PHASE II.
 - SEE PAVING PLAN/PROFILES FOR ADDITIONAL GEOMETRY.

RECORD DRAWING
08/04/06

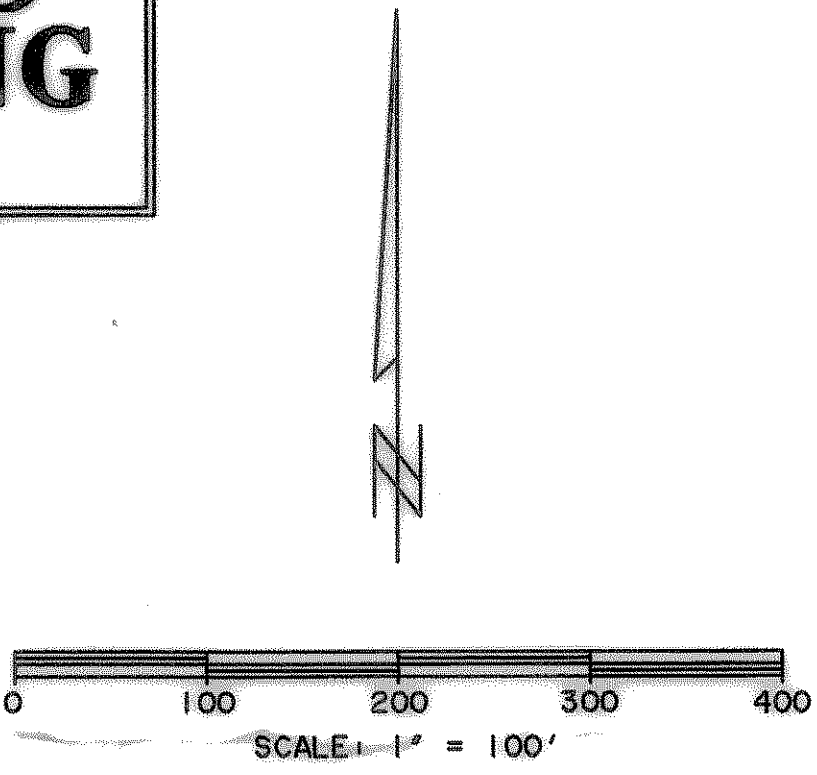

PREPARED BY:
WIA WIER & ASSOCIATES, INC.
 ENGINEERS SURVEYORS LAND PLANNERS
 4300 BELTWAY PLACE SUITE 130 ARLINGTON, TEXAS 76018 METRO (817)467-7700
 1380 U.S. HIGHWAY 207 N. SUITE 101 WANSFIELD, TEXAS 76063 METRO (817)477-8700
 6849 ELM STREET FRISCO, TEXAS 75034 METRO (214)387-8800
 www.wierassociates.com



ROCKWALL TECHNOLOGY PARK PHASE II

COORDINATE CONTROL MAP

STATE OF TEXAS
 RONALD RAMIREZ
 81821
 REGISTERED PROFESSIONAL ENGINEER
 Ronald Ramirez
 817464
 COPYRIGHT ©
 WIER & ASSOCIATES, INC.
 LAST SHEET EDIT
 DATE 08-18-2006
 WA# 95041
SHEET NO. PO03