



TIME: 8:57 FILE: STORM2-CHANGE-ORDER.dwg

REPAIR EXISTING ASPHALT ROADWAY PER TXDOT STANDARDS. CONTACT TXDOT INSPECTOR 48 HOURS PRIOR TO CONSTRUCTION. CONTRACTOR MUST SUBMIT A TRAFFIC CONTROL PLAN FOR APPROVAL 2 WEEKS PRIOR TO CONSTRUCTION.

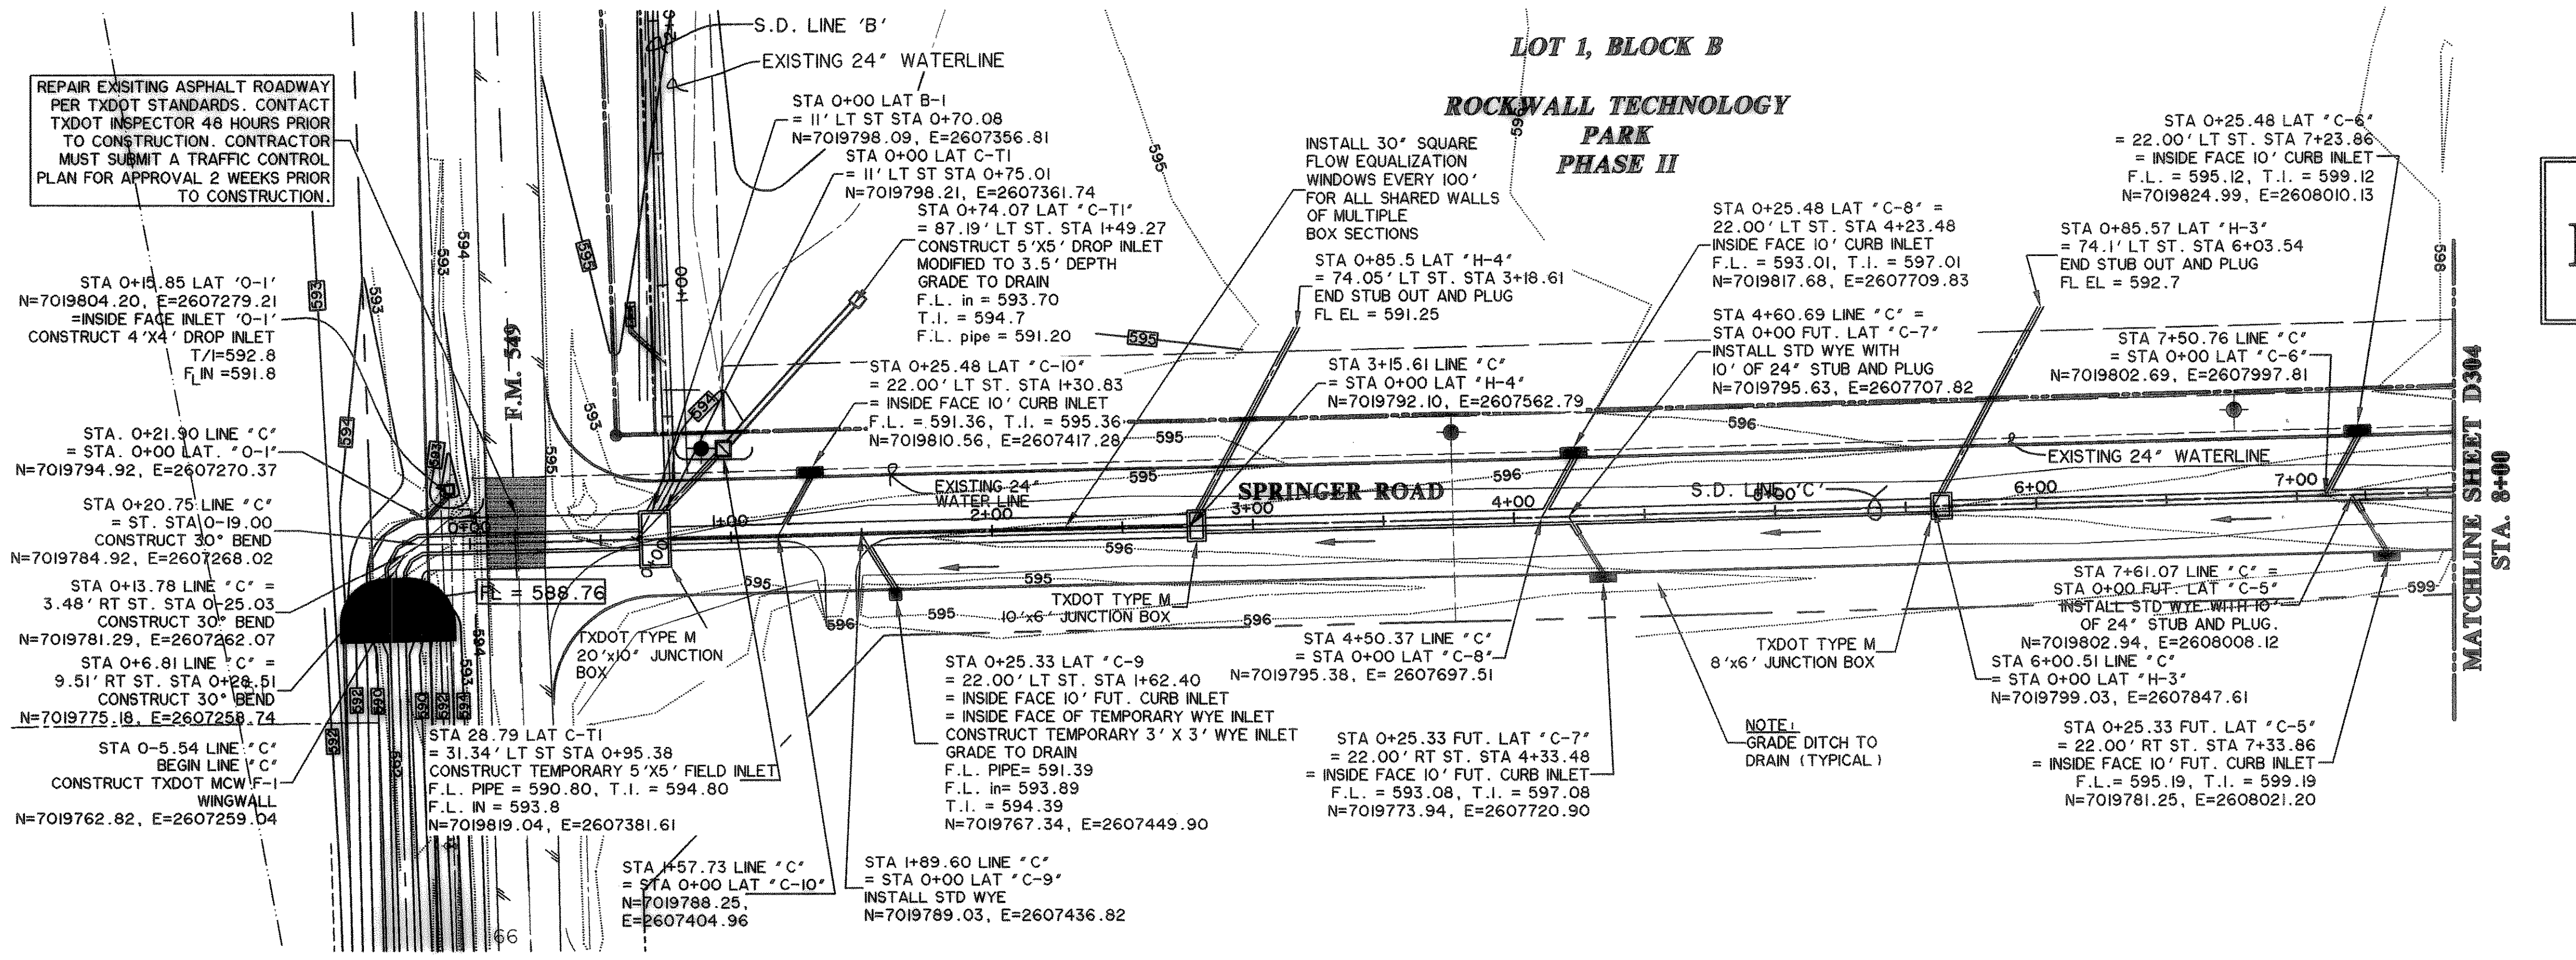

RECORD DRAWING
08/04/06

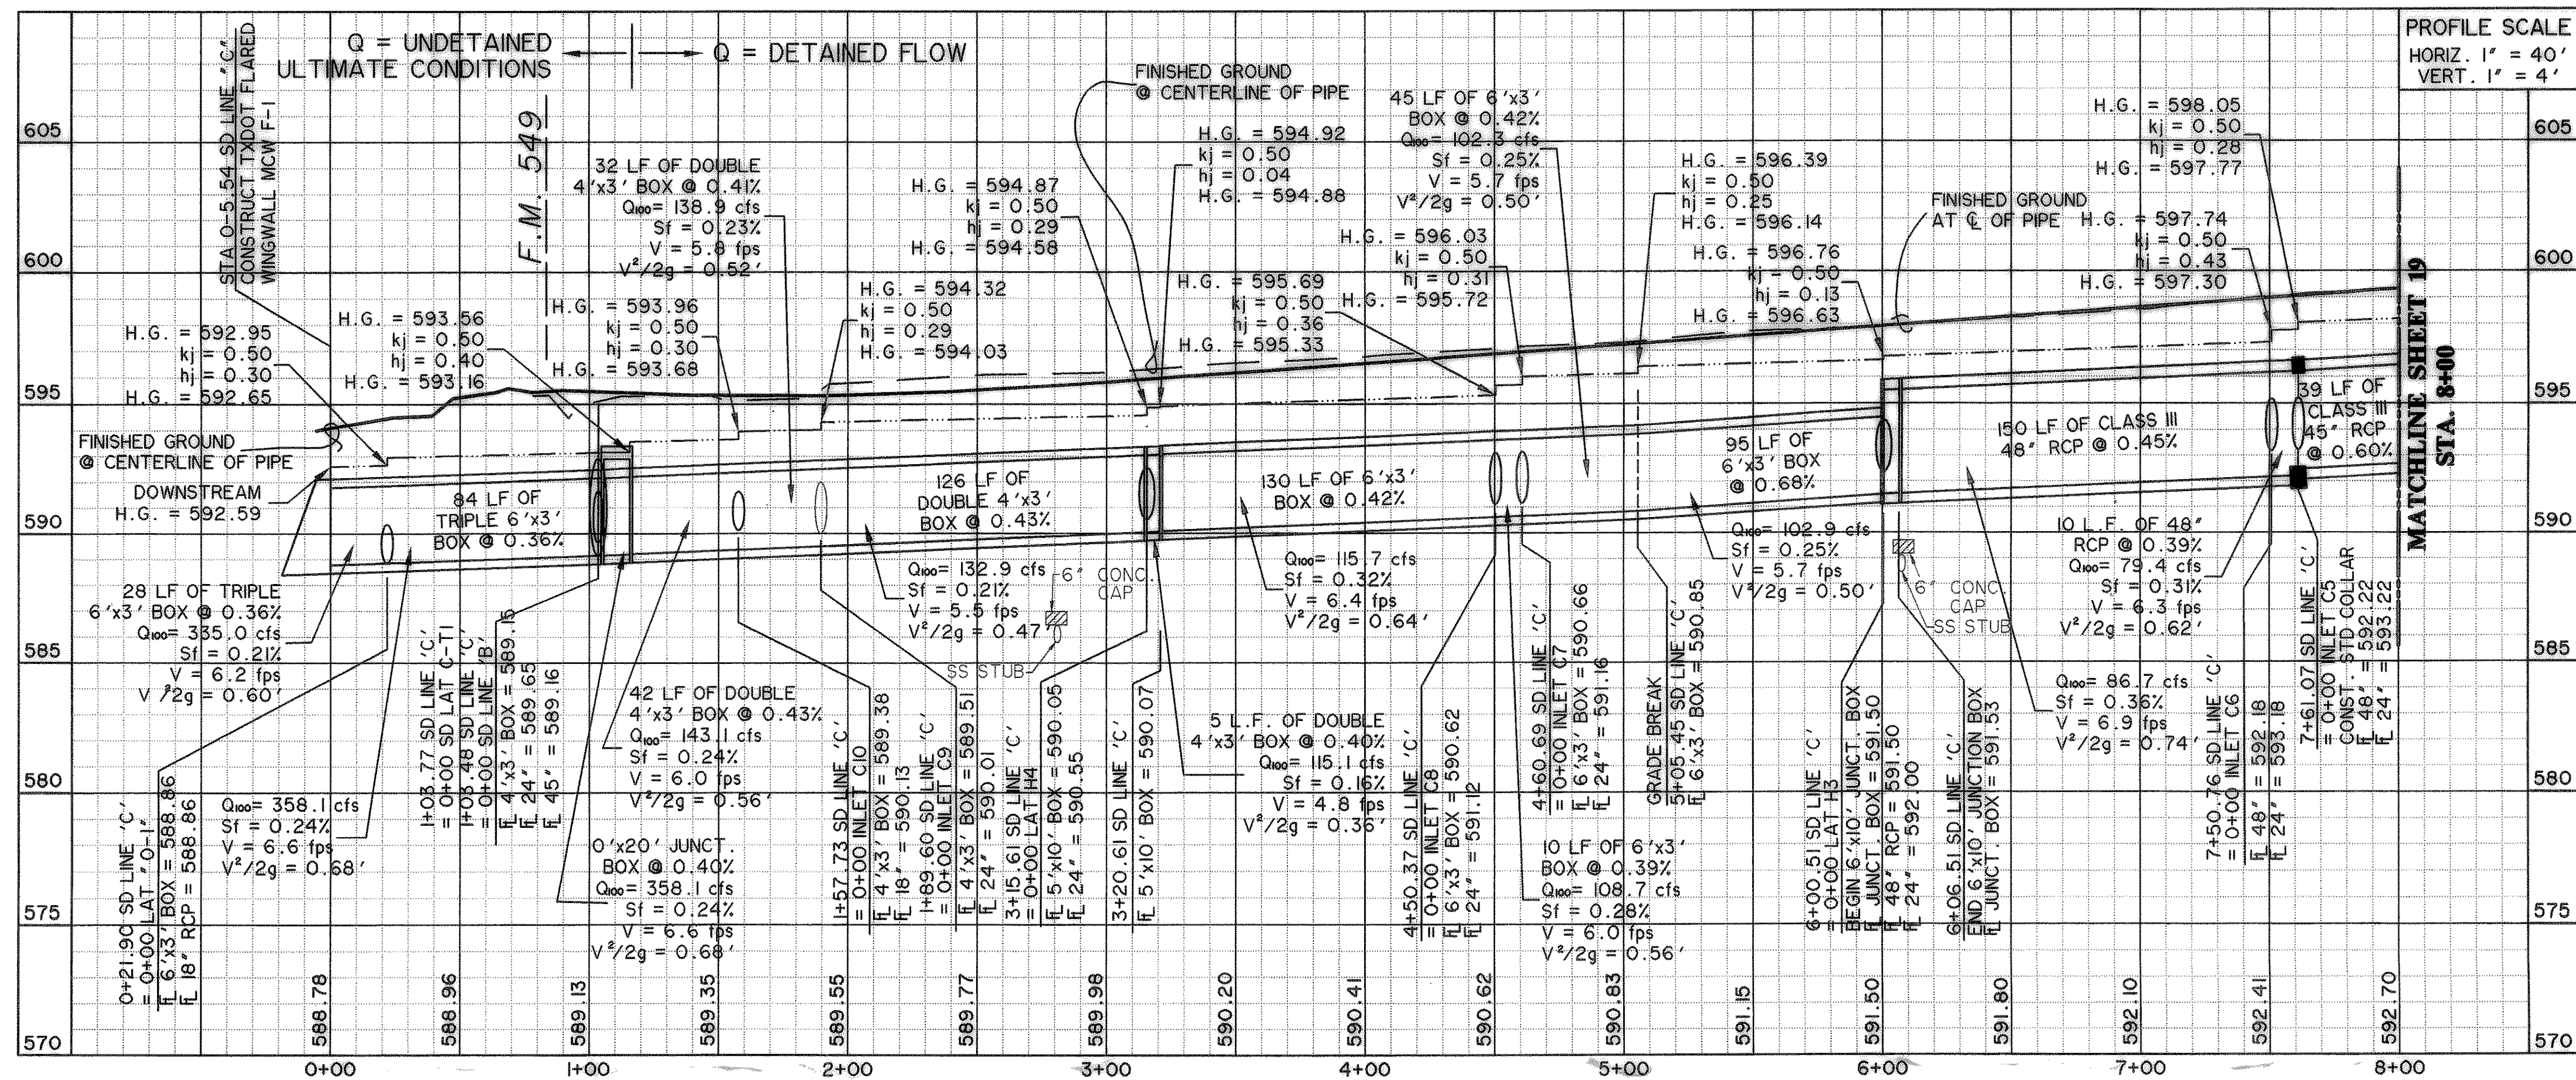

PREPARED BY:
VIA WIER & ASSOCIATES, INC.
ENGINEERS SURVEYORS LAND PLANNERS
4300 BELWAY PLACE SUITE 130 ARLINGTON, TEXAS 76018 METRO (817)467-7700
1380 U.S. HIGHWAY 287 N. SUITE 101 MANSFIELD, TEXAS 76063 METRO (817)477-8700
6848 ELM STREET FRODO, TEXAS 75034 METRO (214)387-8000
www.viawier.com



ROCKWALL TECHNOLOGY PARK PHASE II

STORM DRAIN PLAN AND PROFILE LINE 'C' STA. 0+00 TO 8+00

STATE OF TEXAS
RONALD RAMIREZ
REGISTERED PROFESSIONAL ENGINEER
81821
Ronald Ramirez

COPYRIGHT © V. WIER & ASSOCIATES, INC.
LAST SHEET EDIT DATE 08-16-2006
WA# 98041
SHEET NO. D303