

2 10


W. D. AUSTIN'S ADDITION

9

27

26

REL Halford

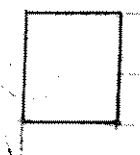

Existing to remain in service

1" 3/4

6"

Joe Spafford, Jr.
2651276

6" x 2" Tapped Plug



Fence - Assumed P.L.


38.8'

2.8'

13.9'

25

C.A. Brownwell
2651397

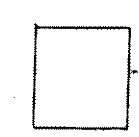

Reconnect all services to houses fronting on new main with copper tubing to meter

Paragon

Pearl Howe
2651403

24

Coates
2651404




GOLIAD STREET


Abandon Existing 1 1/4" 2"

6" C.I. Main Laid Feb. 1946


O.C. Long
2651399

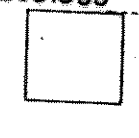

23
A.V. Harrell
2651398

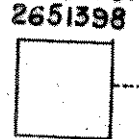


22
Kimbrell
2651396

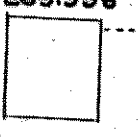


Match Line

Smith
2651401

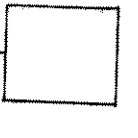

124 B

H.H. Barringer
2651402

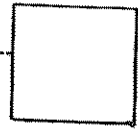


124 A

Bryant
2651400



Geo. Cade
2651395

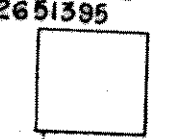

BARNES ADDITION

5

6

7

8

9

Barnhardt
2651180

Ed Shoemaker
3 962 150



HEATH ST.

(FANNIN) ATHERTON STREET

FARMERS & MERCHANTS NATIONAL BANK ADDITION