



SCALE 1" = 8'-0"

8" x 4" Tee in Discharge Line Plug & Block - 4" (See Plan Above).

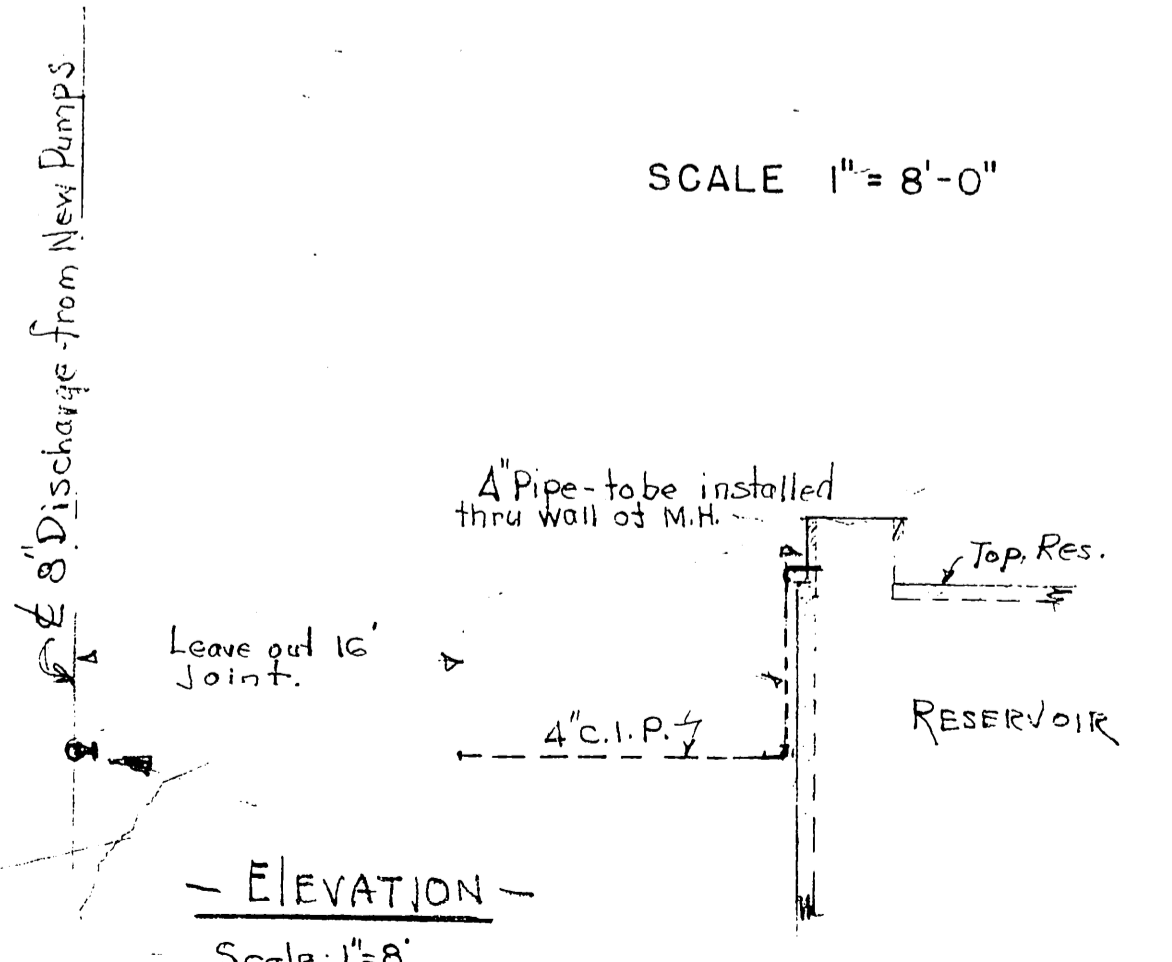

GOLIAD ST.

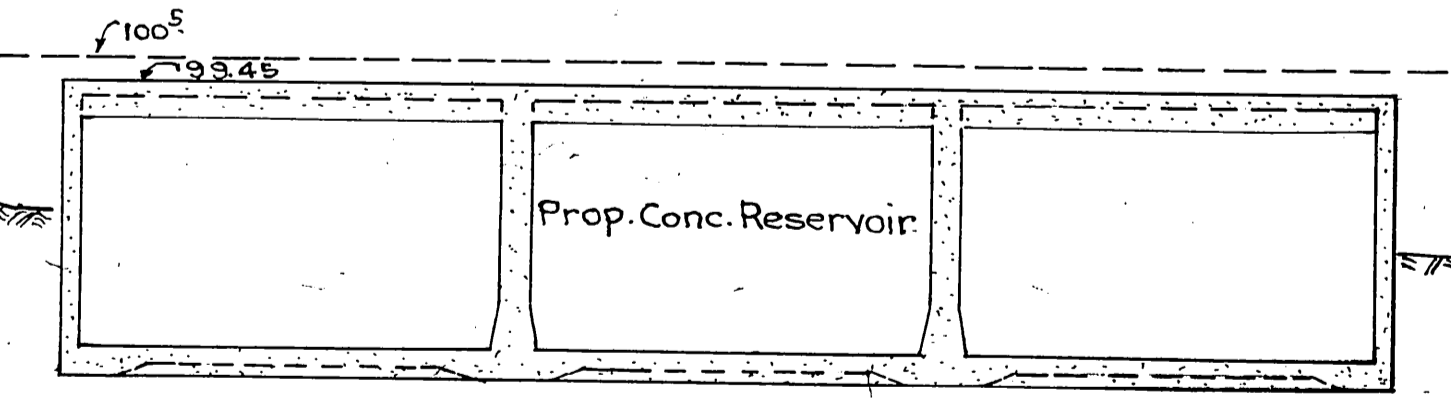

NOTE:
For Location As Built See Plat Sheet 14

ROCKWALL, TEXAS	
WATERWORKS IMPROVEMENTS	
LAYOUT	
DESIGNED BY W.G. FREESE & NICHOLS DRAWN BY M.R. Consulting Engineers CHECKED BY Wm.G. Fort Worth, Texas	4504-1 AUGUST 1945