



1  
 NOT TO SCALE  
**REINFORCING DETAIL AT WATER METERS IN SIDEWALK**

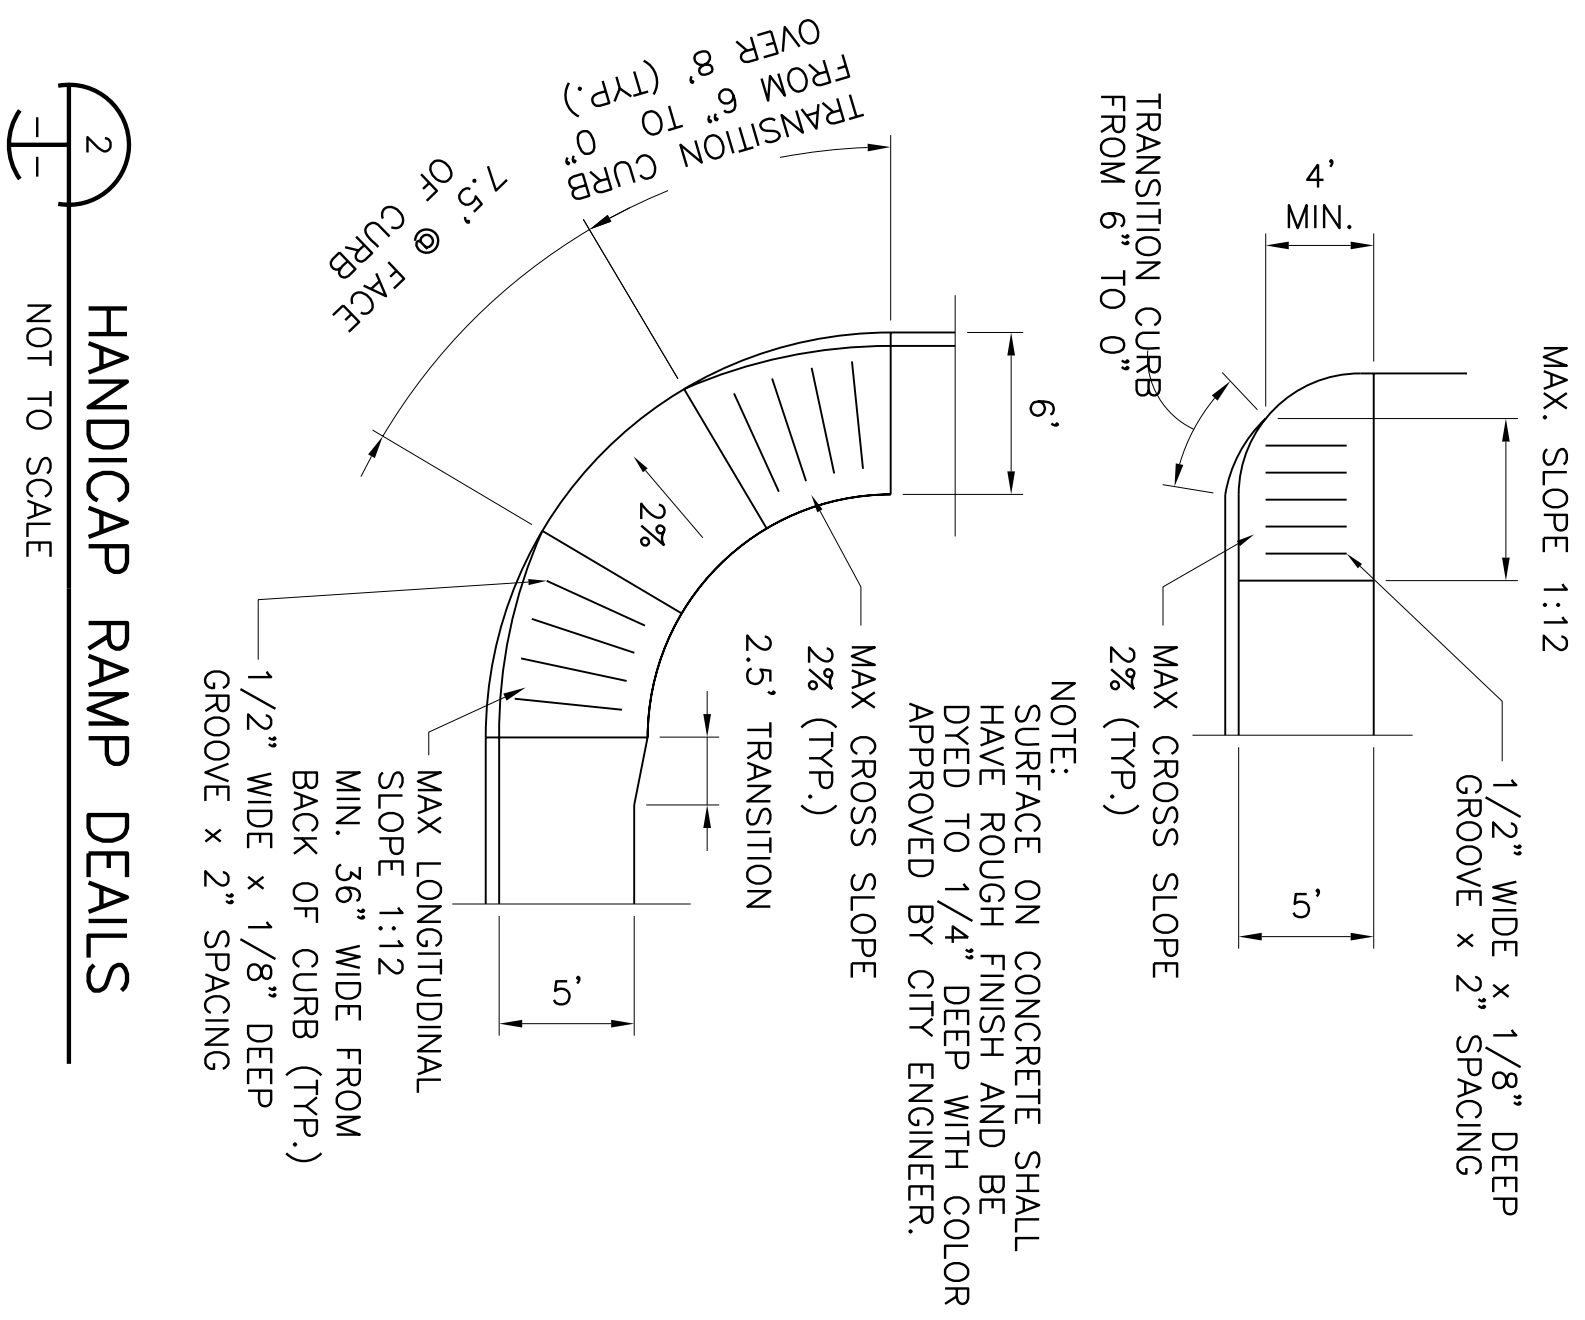


2  
 NOT TO SCALE  
**HANDICAP RAMP DEALS**

- NOTES:
1. ALL HONEYCOMB IN BACK OF CURB TO BE TROWEL - PLASTERED BEFORE POURING SIDEWALK.
  2. LUG MAY BE FORMED BY SHAPING SUBGRADE TO APPROXIMATE DIMENSIONS SHOWN.
  3. FOR SIDEWALKS AGAINST EXISTING CURB, KEYWAY SHALL BE REPLACED WITH 6" LONG #3 BARS DRILLED 4" INTO EXISTING BACK CURB AND EPOXY GROUTED ON 24" CENTERS.
  4. PAYMENT FOR KEYWAY SUBSIDIARY TO SIDEWALK LUG PAY ITEM.
  5. PAYMENT FOR EXCAVATION, BORROW, AND COMPACTION IS SUBSIDIARY TO CONCRETE PAY ITEM.
  6. LIME STABILIZATION OR SELECT BORROW MATERIAL FOR SUBGRADE IS REQUIRED WHEN SOIL P.I. IS GREATER THAN 18. LIMITS OF SUBGRADE STABILIZATION ARE MINIMUM REQUIRED.
  7. BACKFILL FOR SIDEWALK SUBGRADE SHALL BE LIME STABILIZED SOIL OR SELECT BORROW MATERIAL HAVING A P.I. NOT LESS THAN 10 NOR GREATER THAN 18.
  8. SIDEWALK BACKFILL AND SUBGRADE SHALL BE COMPACTED IN LIFTS NOT TO EXCEED 6 INCHES TO 95% OF ASTM D698 DENSITY WITH A MOISTURE WITHIN -2% TO +4% OF OPTIMUM MOISTURE.
  9. 1/2" EXPANSION JOINTS SHALL BE PROVIDED AT STREET EXPANSION JOINTS AND AT A MAXIMUM 40 FOOT SPACING IN LINE WITH STREET SAW JOINTS. A TOOL MARKED GROOVE SHALL BE PROVIDED IN LIME WITH INTERMEDIATE STREET SAW JOINTS.

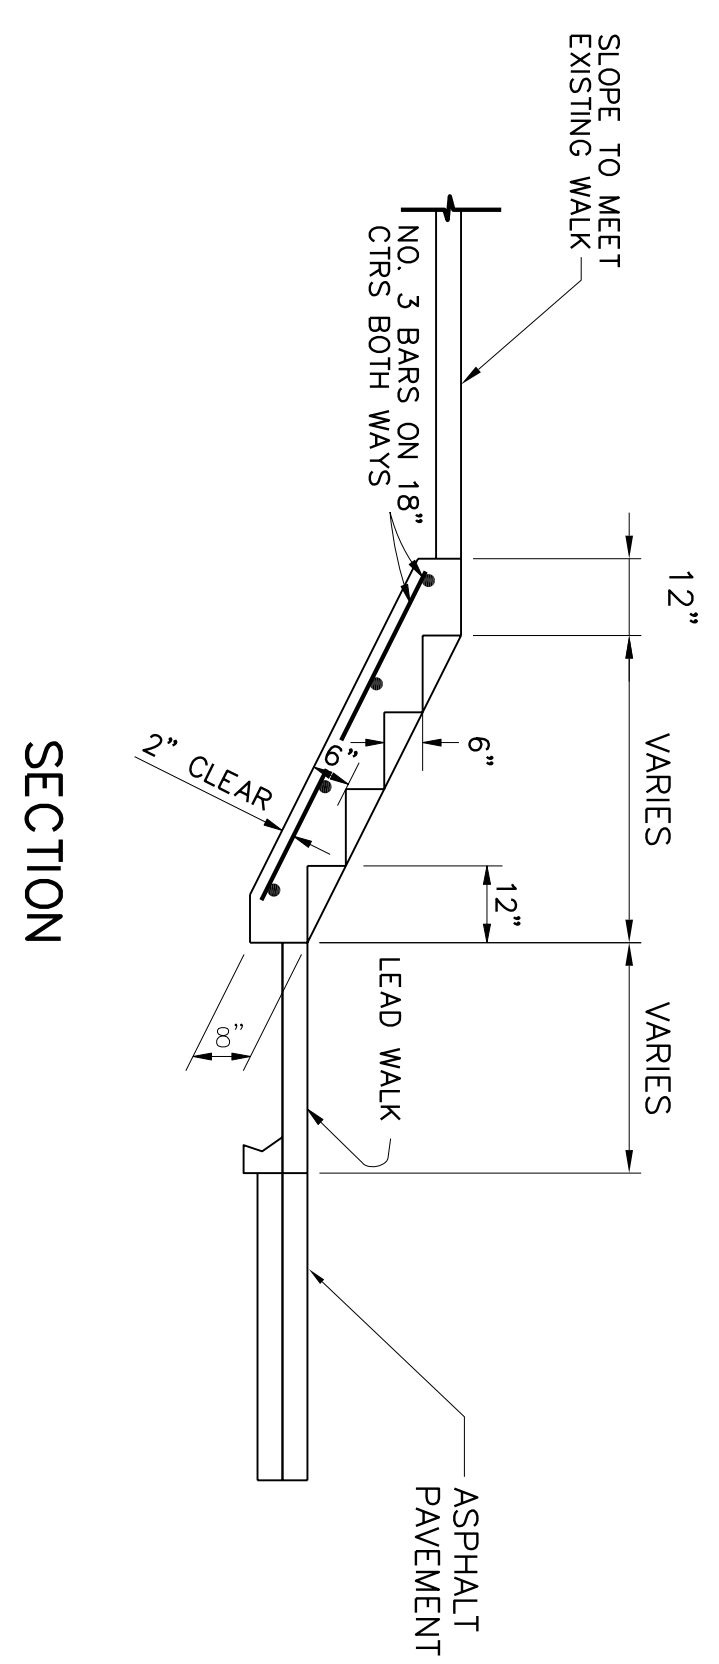

**SECTION**

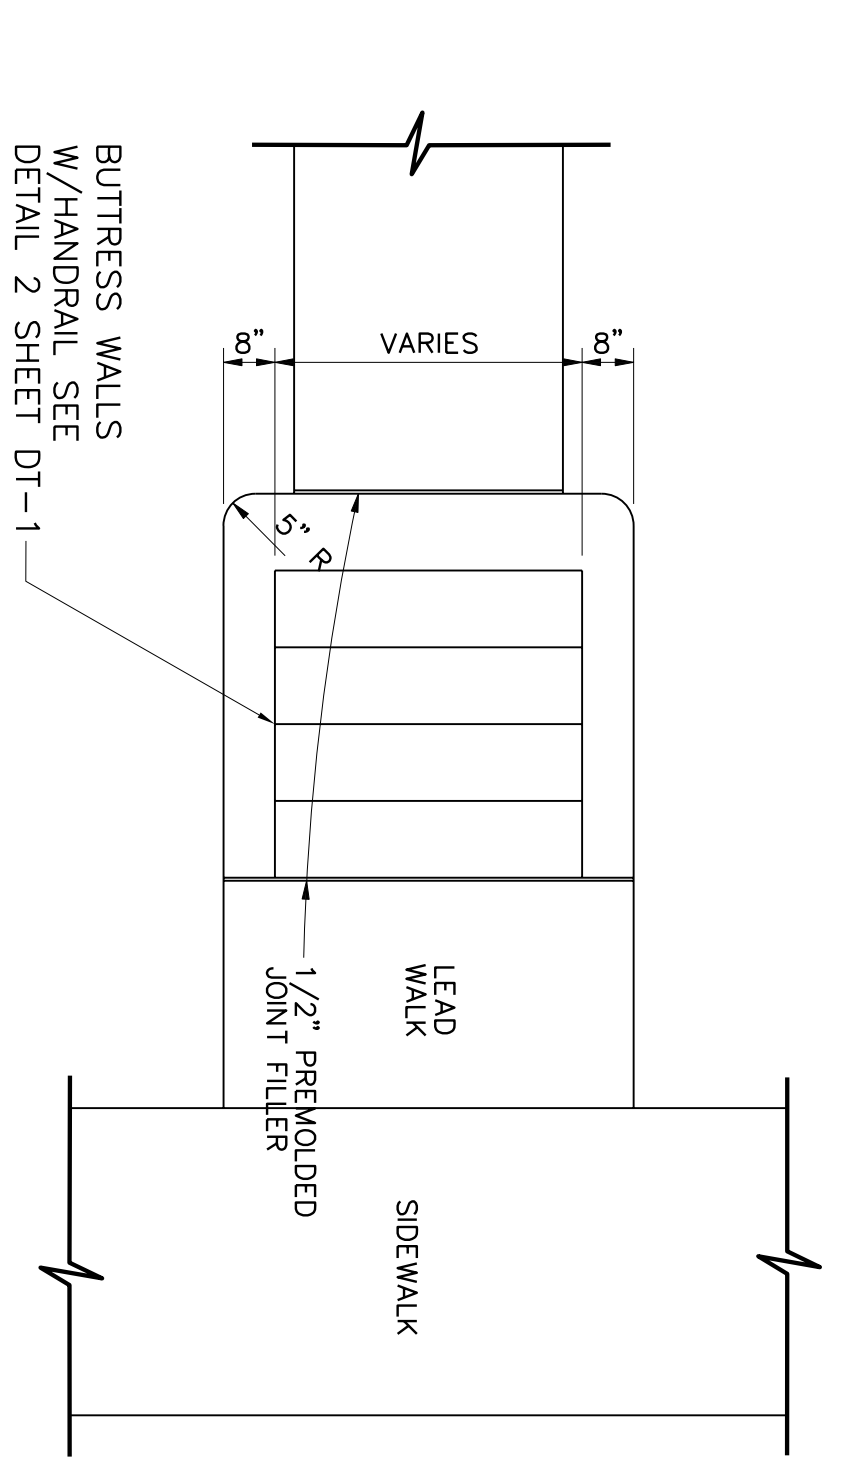


3  
 NOT TO SCALE  
**LEADWALK STEPS**

This Record Drawing is a combination of the sealed engineering contract drawings for this project, modified by information furnished by the contractor, reflecting changes in the project. It is the responsibility of the contractor to verify the accuracy of the sealed drawings are on file at the offices of  
**FRESE AND NICHOLS, INC.**  
 4055 INTERNATIONAL PLAZA, SUITE 200  
 FORT WORTH, TEXAS 76109-4895  
 RECORD DRAWINGS PREPARED ON:  
 7/13/2007

THE SEAL THAT ORIGINALLY APPEARED ON THIS DOCUMENT WAS AUTHORIZED BY TED B. SUGGS, P.E. TEXAS NO. 82275 ON 7/13/2007. ALTERATION OF A SEALED DOCUMENT WITHOUT PROPER NOTIFICATION OF THE RESPONSIBLE ENGINEER IS AN OFFENSE UNDER THE TEXAS ENGINEERING PRACTICE ACT.

**Freese and Nichols**  
 1701 N. Market Street, Suite 500, LB 51  
 Dallas, Texas 75202-2001  
 Phone - (214) 920-2500  
 Fax - (214) 920-2565

CITY OF ROCKWALL, TEXAS  
**ROSS STREET REHABILITATION AND DRAINAGE IMPROVEMENTS**  
 CIVIL  
**PAVING DETAILS**

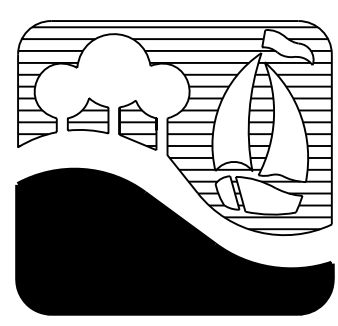

NO.	ISSUE	BY	DATE	F&N JOB NO.
0				ROK05274
				DATE 3/01/2006
				DESIGNED RAW
				DRAWN NO/EAM
				REVISED NO
				CHECKED RAW
FILE NAME				
CV-ROK-DT-DTLS02.dwg				

VERIFY SCALE 1  
 Bar is one inch on original drawing. If not one inch on this sheet, adjust scale.

SHEET DT-3  
 SFO.