


ACAD: Rel 16.2s (LMS Tech) User: AAL
 ROK05274\DALSR2\N:\F\DRAWINGS\CV-ROK-PP-STDN02.DWG_LAYOUT: Layout1
 FEB 13, 2006 9:37:19 A.M. LISTS: 1 PLSLTS: 1 TWIST: 0, 359.2
 4 REFERENCE FILES: ..\BASE\CV-DRA-PR-STDN01..N:\F\BASE\CV-ROK-PL-BASE..N:\F\BASE\CV-ROK-PL-TOPO and N:\STANDARD\34BORDER

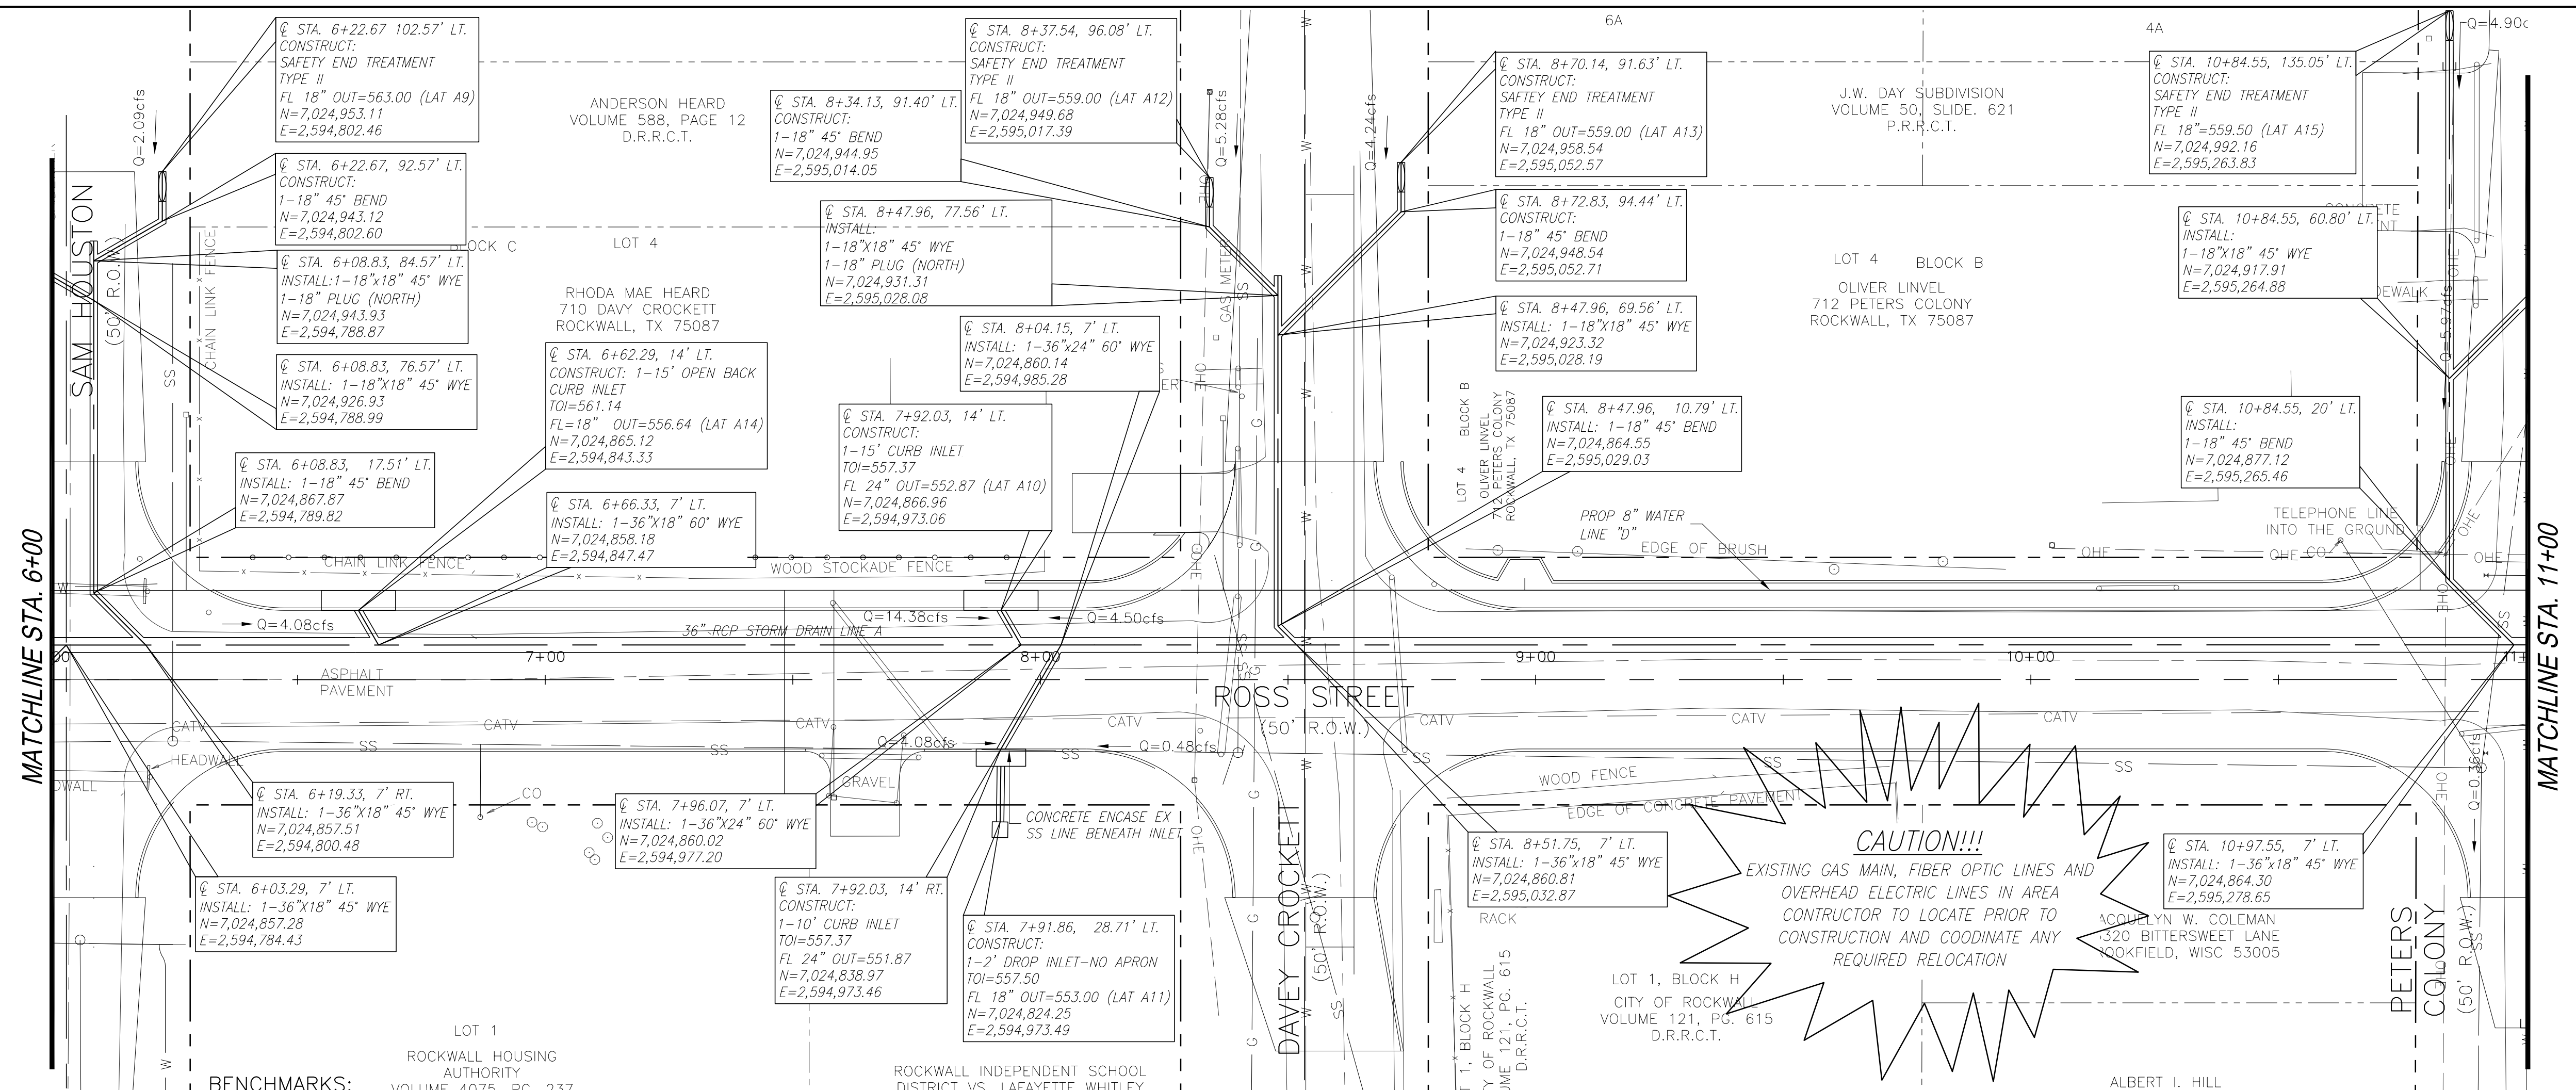

BENCHMARKS:

BM #1 CHISELED BOX CUT ON NORTHEAST CORNER OF 3'x6' CONCRETE SLAB FOR MAILBOXES LOCATED AT THE SOUTHWEST CORNER OF THE INTERSECTION OF ROSS AND THROCKMORTON, 30' SOUTH OF ROSS. ELEV=577.28

BM #2 RAILROAD SPIKE IN WEST SIDE OF POWER POLE, APPROX. 1 FOOT ABOVE NATURAL GROUND, LOCATED AT THE NORTH EAST CORNER OF THE INTERSECTION OF ROSS AND PETERS COLONY, APPROX. 25' EAST OF PETERS COLONY AND 25' NORTH OF ROSS STREET. ELEV=558.27

BM #3 CHISELED BOX CUT IN CENTER OF 12' CURB INLET LOCATED ON THE NORTH SIDE OF BOURN, APPROX. 200' EAST OF PETERS COLONY AND 25' NORTH OF THE CENTERLINE OF BOURN. ELEV=547.30

BM #4 CHISELED BOX CUT ON SOUTHEAST CORNER OF A 4'x4' DROP INLET LOCATED ON THE WEST SIDE OF THROCKMORTON, APPROX. 50' NORTH OF BOURN. 575.30



NOTE:

1. CONTRACTOR SHALL REFER TO TXDOT STANDARD CI (4) (OB)-02(FW) FOR OPEN BACK INLET DETAIL.


2. CONTRACTOR SHALL REFER TO TXDOT STANDARD SET P-CD FOR SAFETY END TREATMENT DETAIL.

This Record Drawing is a combination of the sealed engineering contract drawings for this project, modified by information furnished by the contractor reflecting changes in the Project made during construction. The original sealed drawings are on file at the offices of FREESE AND NICHOLS, INC. 4055 INTERNATIONAL PLAZA, SUITE 200 FORT WORTH, TEXAS 76109-4895 (817) 735-7300 RECORD DRAWINGS PREPARED ON: 7/13/2007

SCALE:
 HORIZ: 1"=20'
 VERT: 1"=4'

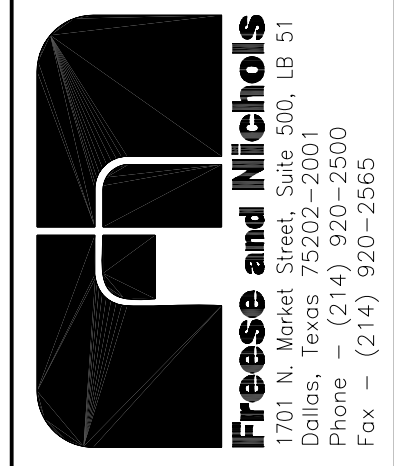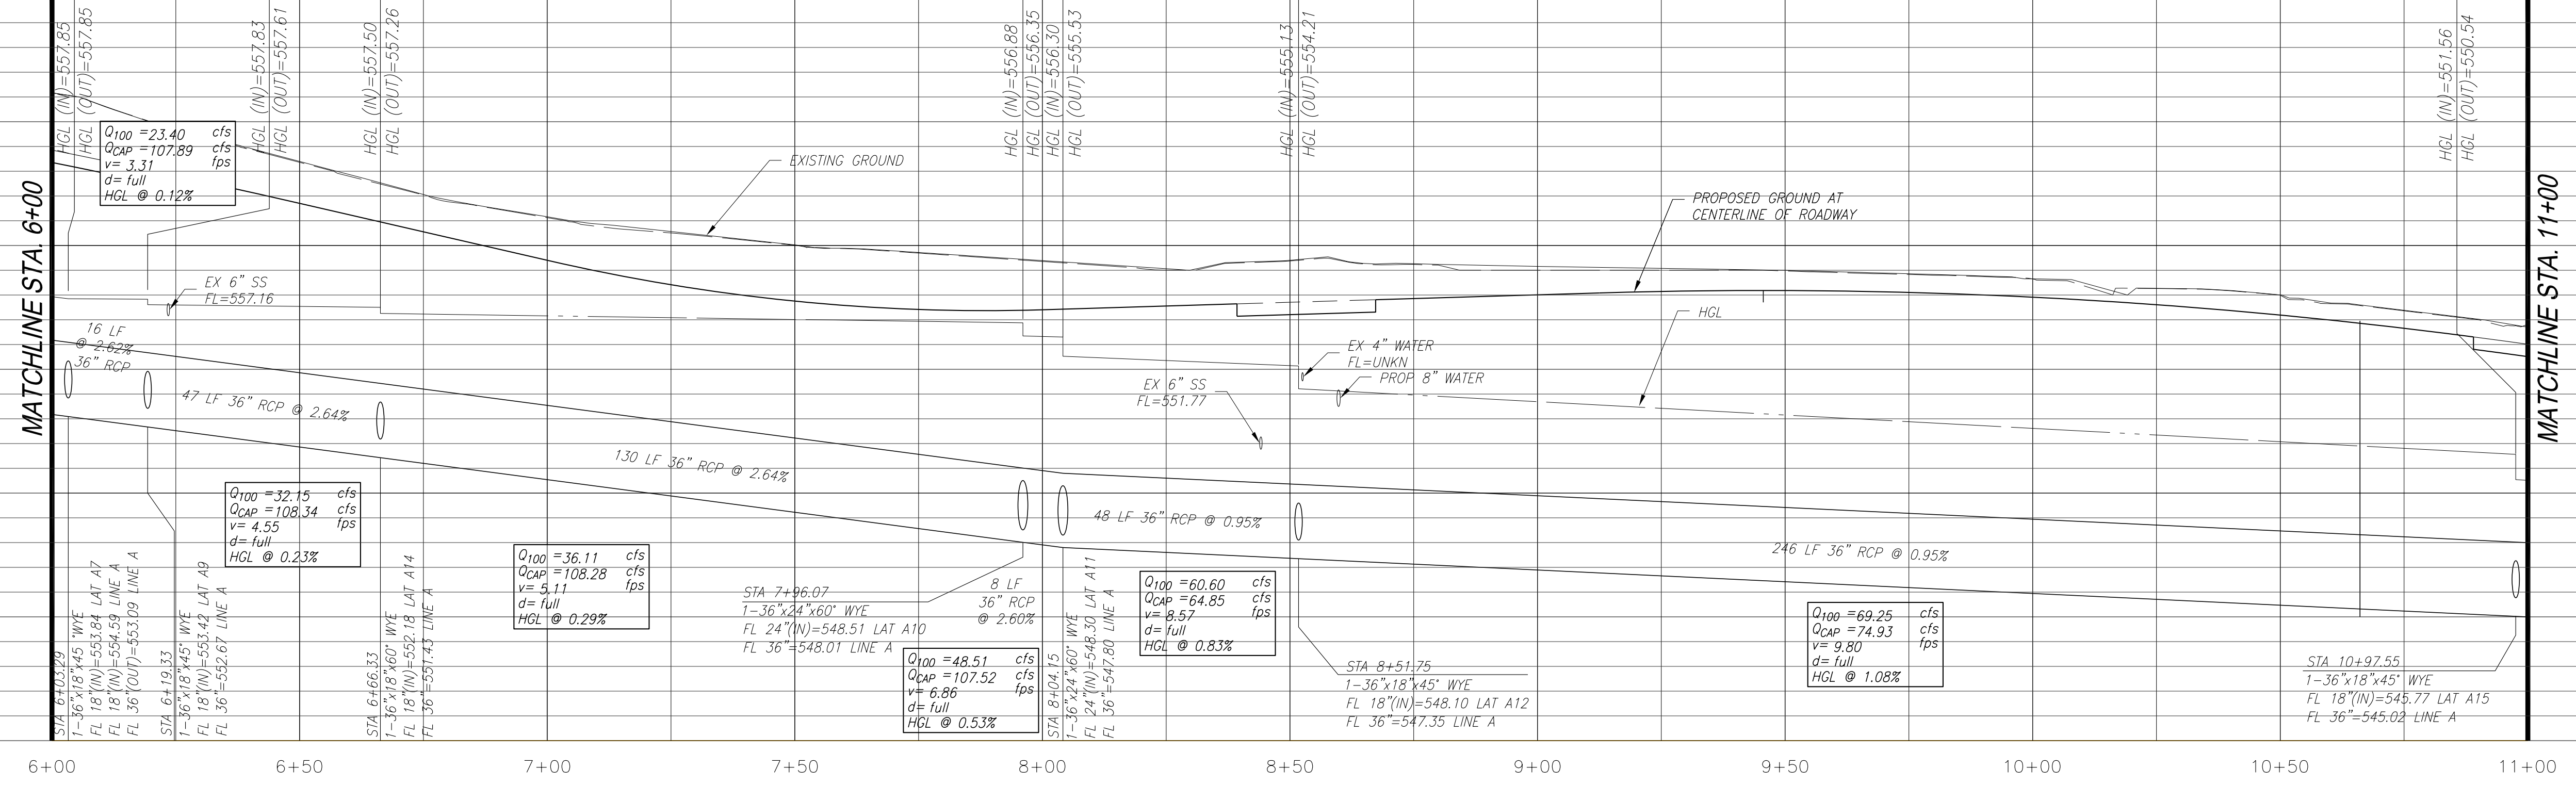

CITY OF ROCKWALL, TEXAS
 ROSS STREET REHABILITATION AND DRAINAGE IMPROVEMENTS
 ROSS STREET STORM DRAIN STA. 5+00 TO STA. 9+00

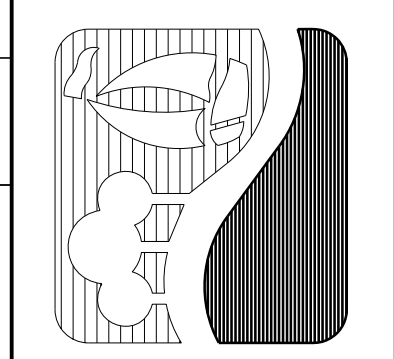

NO.	ISSUE	BY	DATE	FRAN JOB NO.	DESIGNED	DRAWN	REVISION	CHECKED	FILE NAME
0	VERIFY SCALE			ROK05274					CV-ROK-PP-STDN02.dwg
1	Bar is one inch on original drawing, if not one inch on this sheet, adjust scale.			DATE 5/01/2006	RAW	NO/EAM	NO		