


CAUTION!
EXISTING OVERHEAD AND UNDERGROUND UTILITIES IN AREA CONTACT UTILITY 48 HOURS PRIOR TO CONSTRUCTION AT 1-800-344-8377 FOR LOCATION

This Record Drawing is a combination of the original drawing and any amendments made by the contractor reflecting changes in the project made during construction. The original sealed drawings are on file at the offices of FREESE AND NICHOLS, INC. 1701 N. MARKET STREET, SUITE 500, DALLAS, TEXAS 75202-2001 (817) 735-7300 (817) 735-7300 RECORD DRAWINGS PREPARED ON: 1/13/2007

- NOTE:**
1. CONTRACTOR TO FIELD VERIFY ALL CONNECTIONS TO EXISTING WATER LINES.
 2. CONTRACTOR SHALL PROVIDE A WATER SERVICE AND METER BOX FOR ALL LOTS ON THROCKMORTON ROSS ST. AND LAMAR FOR THE PROJECT LIMITS. CONTRACTOR SHALL FIELD VERIFY EXISTING SERVICE LOCATIONS FOR CORNER LOTS, THOSE WHICH GET SERVICE FROM BOURN OR BOYDSTON ARE NOT INCLUDED AS PART OF THIS PROJECT.
 3. CONTRACTOR SHALL PROVIDE FUTURE SEWER SERVICE CONNECTIONS AND SET A CLEANOUT AT THE ROW LINE FOR ALL VACANT LOTS ON THROCKMORTON AND ROSS ST.
 4. ALL WATER LINE CONNECTIONS SHALL BE RESTRAINED.
 5. CONTRACTOR SHALL DETECT PROPOSED WATER AT 75% MAX MANUFACTURERS DEFLECTION RECOMMENDATIONS TO AVOID PROPOSED INLETS.
- BENCHMARKS:**
- BM #1 CHISELED BOX CUT ON NORTHEAST CORNER OF 3'-6" CONCRETE SLAB FOR MAILBOXES LOCATED AT THE SOUTHWEST CORNER OF THE INTERSECTION OF ROSS AND THROCKMORTON, 30' SOUTH OF ROSS, ELEV=572.28
 - BM #2 RAILROAD SPIKE IN WEST SIDE OF POWER POLE, APPROX. 1 FOOT ABOVE NATURAL GROUND, LOCATED AT THE NORTH EAST CORNER OF THE INTERSECTION OF ROSS AND PETERS COLONY, APPROX. 25' EAST OF PETERS COLONY AND 25' NORTH OF ROSS STREET, ELEV=558.27
 - BM #3 CHISELED BOX CUT IN CENTER OF 12" CURB INLET LOCATED ON THE NORTH SIDE OF BOURN, APPROX. 200' EAST OF PETERS COLONY AND 25' NORTH OF THE CENTERLINE OF BOURN, ELEV=547.30
 - BM #4 CHISELED BOX CUT ON SOUTHEAST CORNER OF A 4'x4' DROP INLET LOCATED ON THE WEST SIDE OF THROCKMORTON, APPROX. 50' NORTH OF BOURN, ELEV=575.30

555	560	565	570	575	580	585	590
-----	-----	-----	-----	-----	-----	-----	-----

NO.	ISSUE	BY	DATE	F&N JOB NO.
				ROK05274
			3/01/2006	
				DESIGNED
				DRAWN
				REVISED
				CHECKED
				FILE NAME
				CV-ROK-PP-WTRL06.dwg

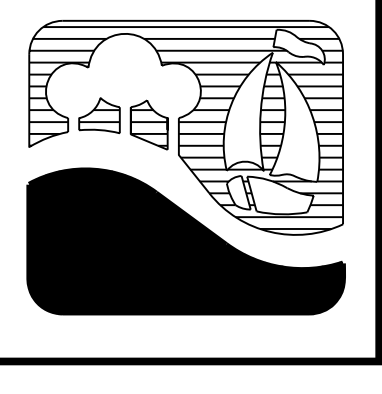

CITY OF ROCKWALL, TEXAS
ROSS STREET REHABILITATION AND DRAINAGE IMPROVEMENTS
 CIVIL
PROPOSED WATERLINE "B"
 PLAN & PROFILE STA 1+00 TO END

Freese and Nichols
 1701 N. Market Street, Suite 500, LB 51
 Dallas, Texas 75202-2001
 Phone - (214) 920-2500
 Fax - (214) 920-2565

THE SEAL THAT ORIGINALLY APPEARED ON THIS DOCUMENT WAS AUTHORIZED BY IED, B. SUGG, P.E. TEXAS NO. 92775 ON 11/13/2007. ALTERATION OF A SEALED DOCUMENT WITHOUT PROPER NOTIFICATION OF THE RESPONSIBLE ENGINEER IS AN OFFENSE UNDER THE TEXAS ENGINEERING PRACTICE ACT.

VERIFY SCALE Bar is one inch on original drawing. If not one inch on this sheet, adjust scale.

SHEET WT-1A
 SEQ.