
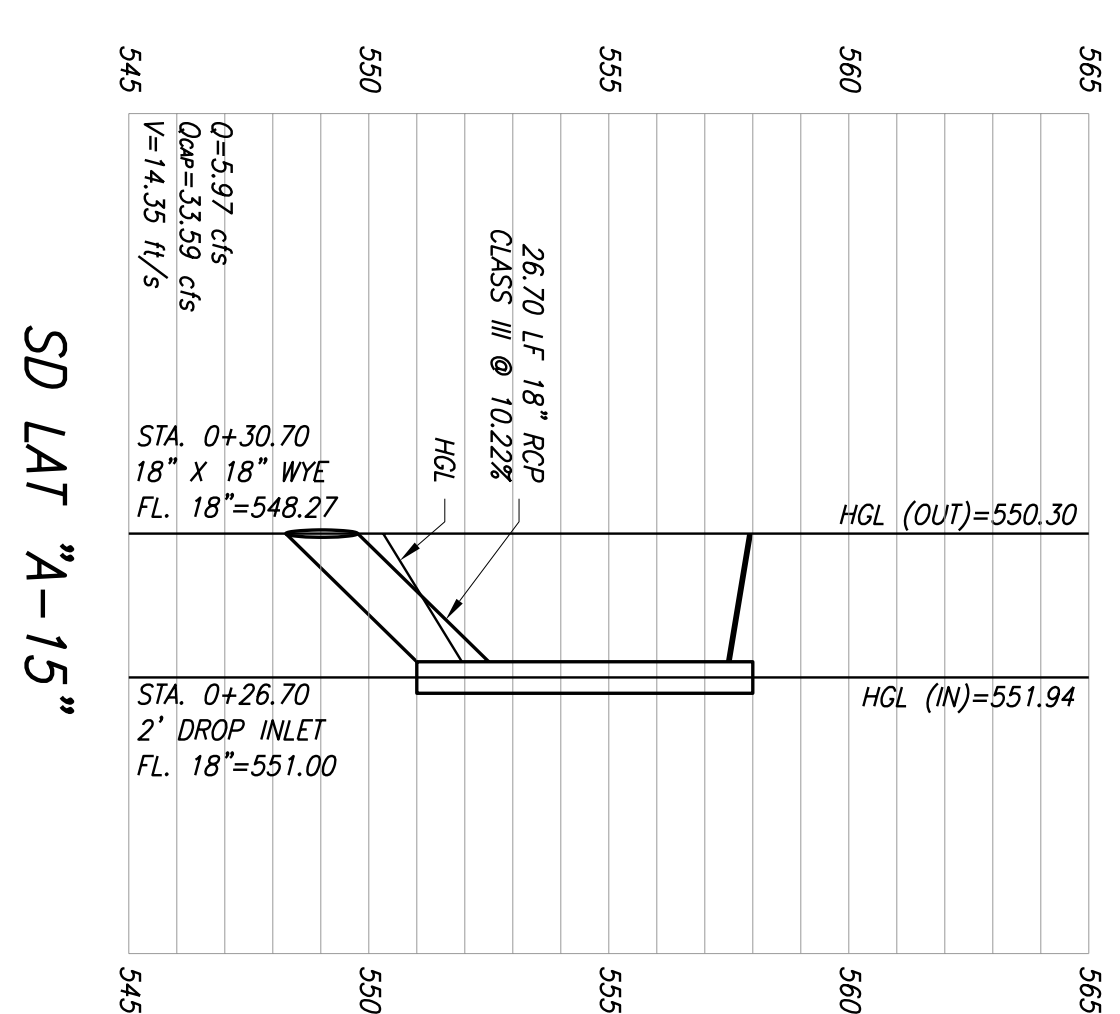
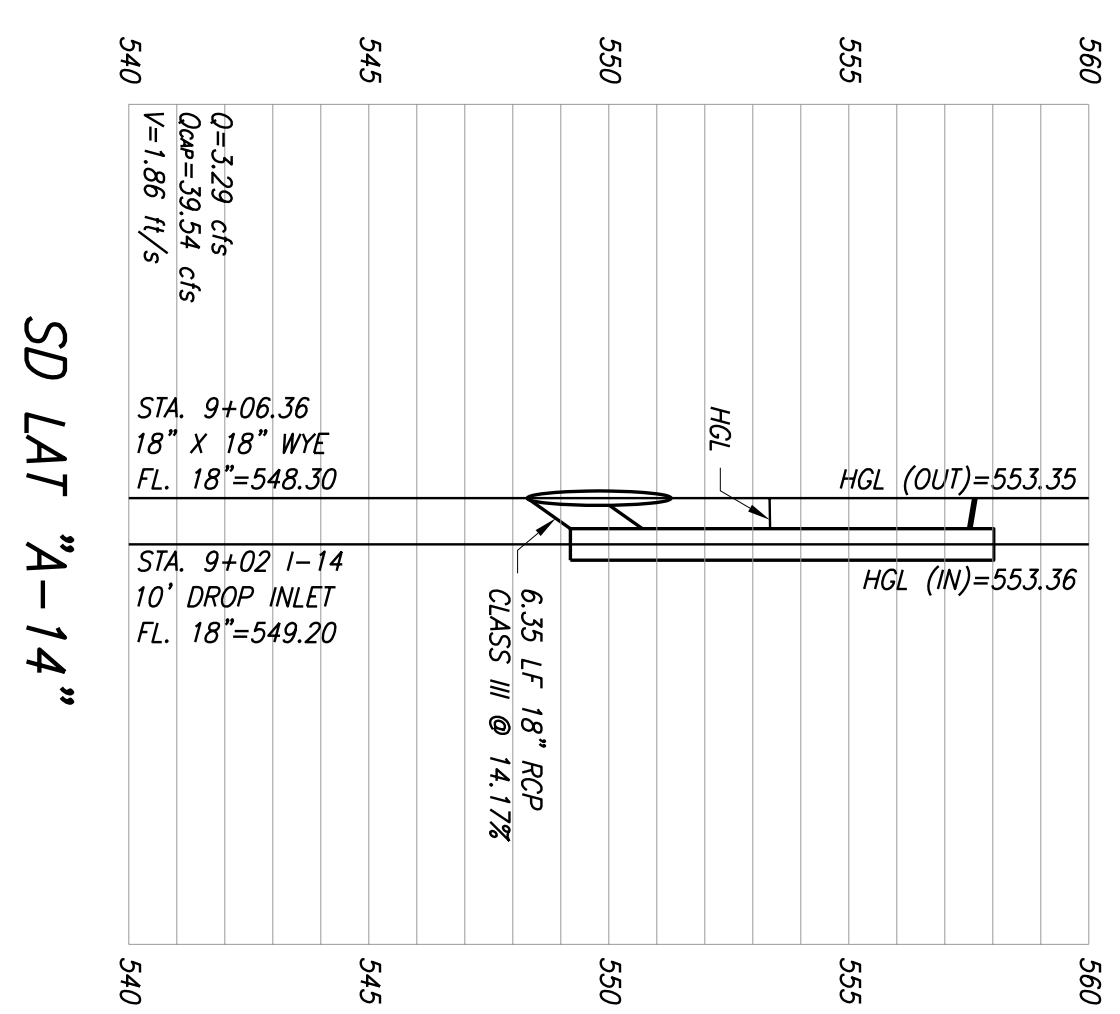
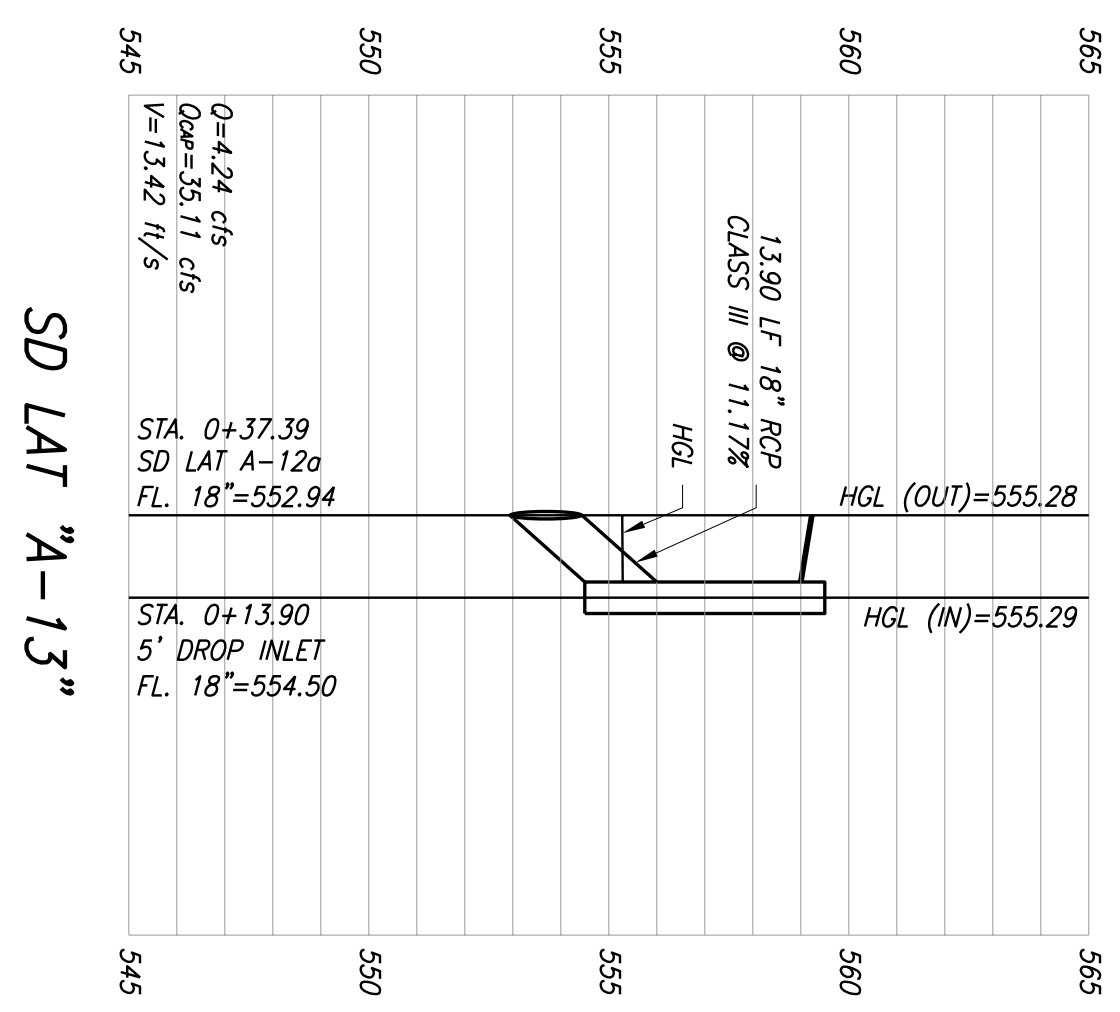
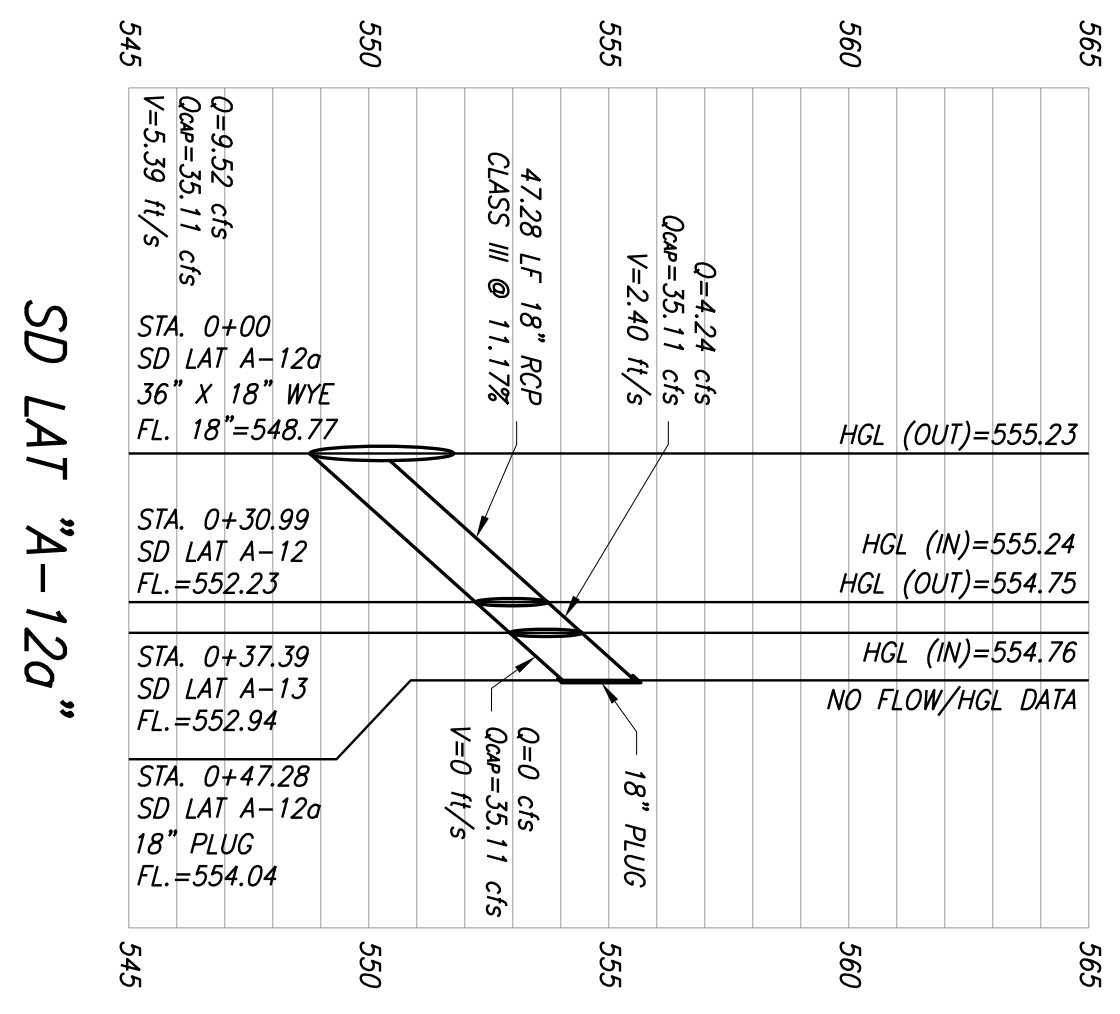
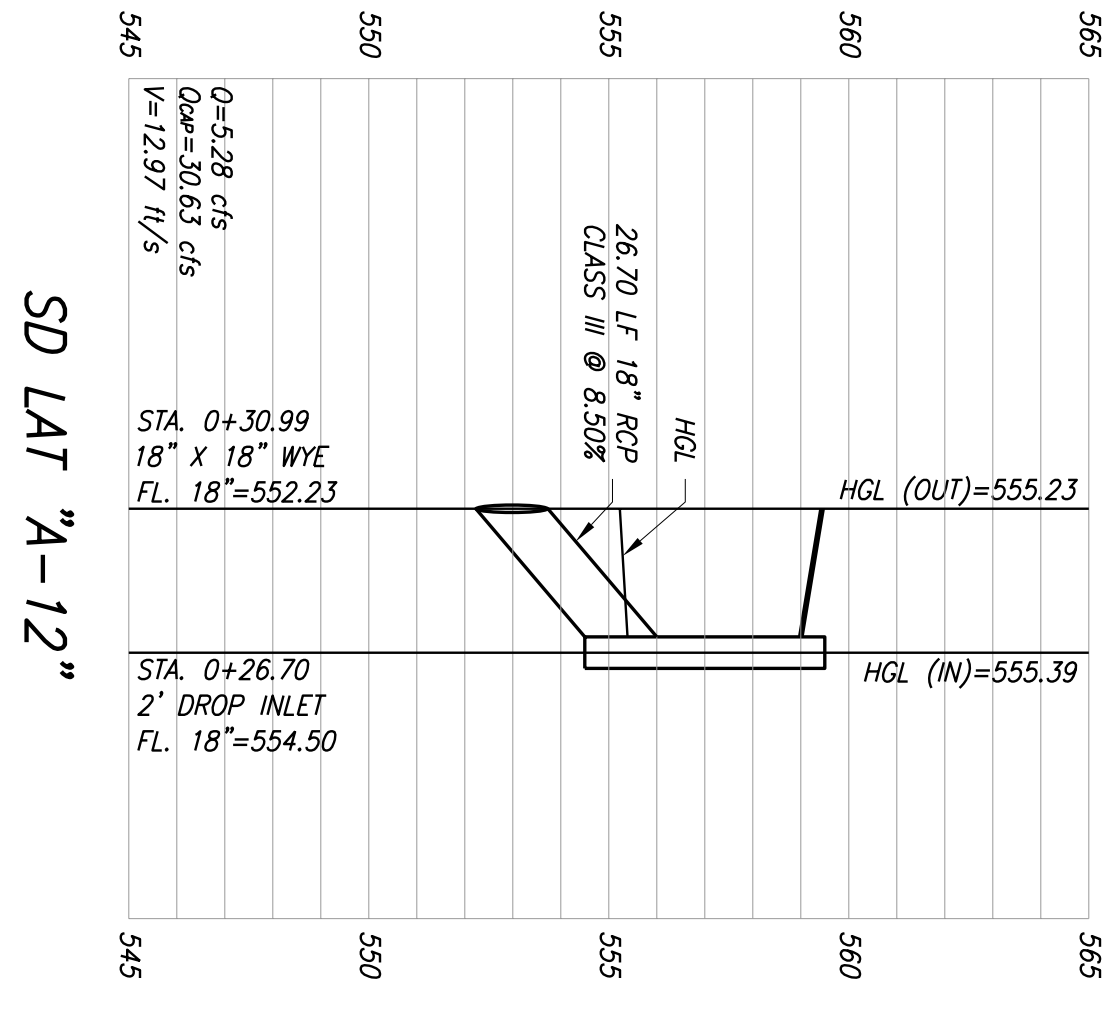
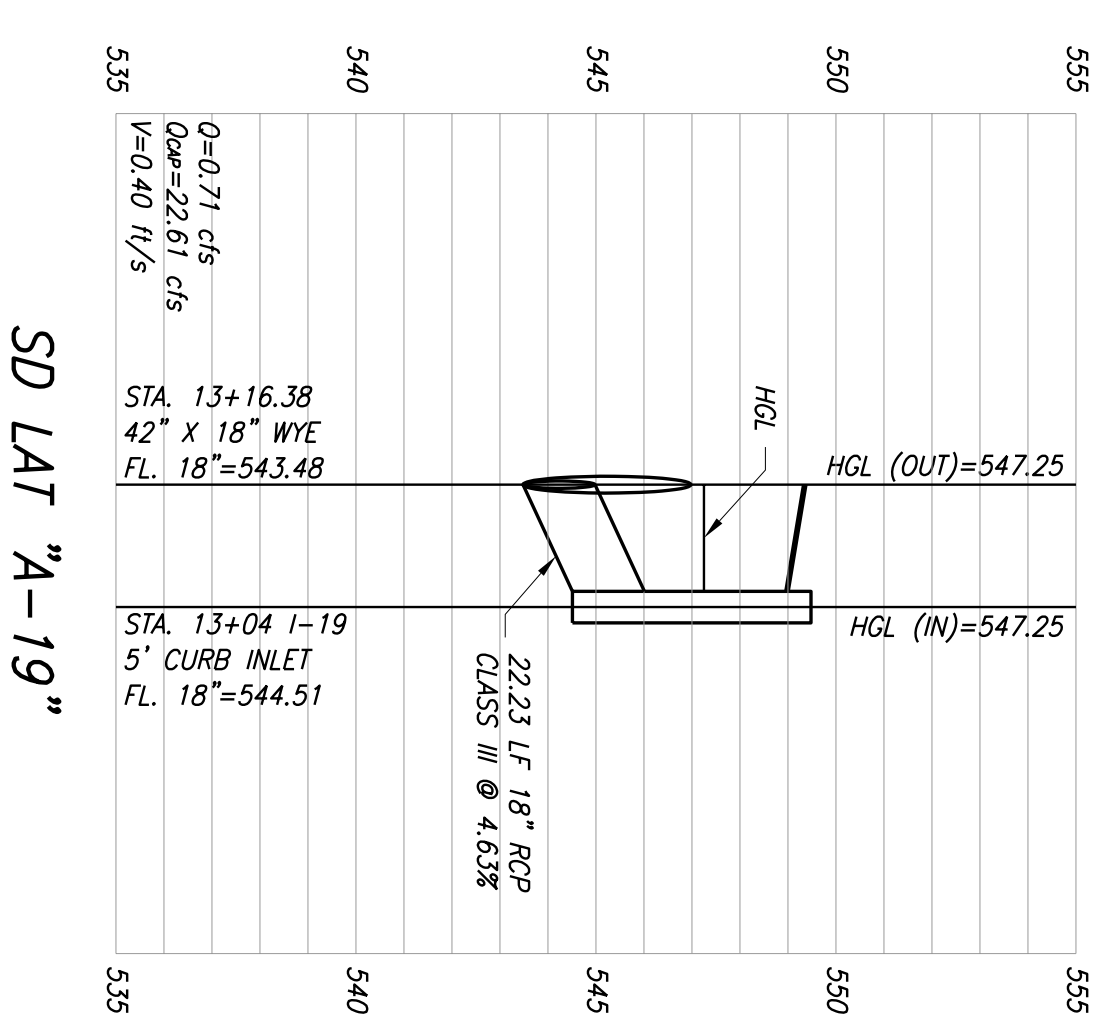
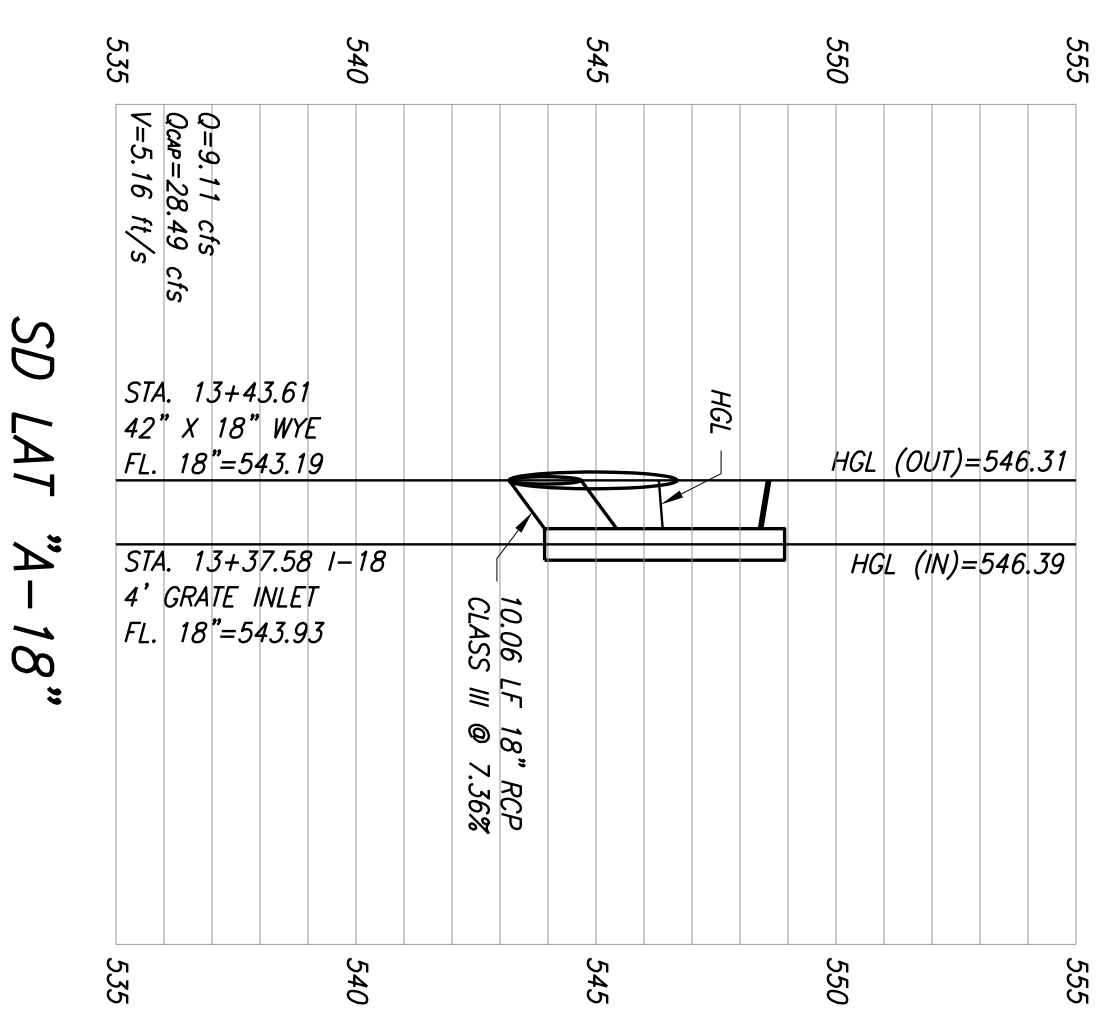
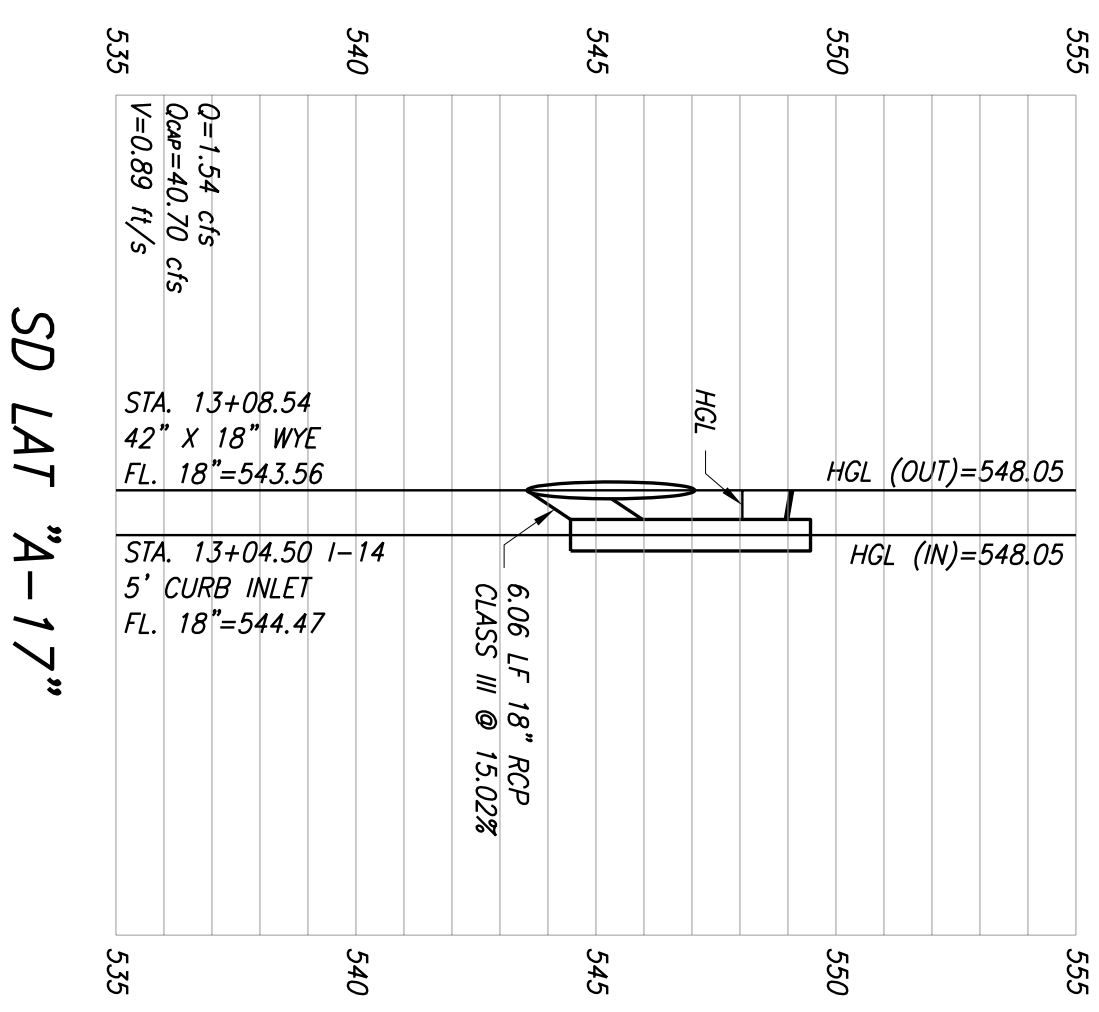
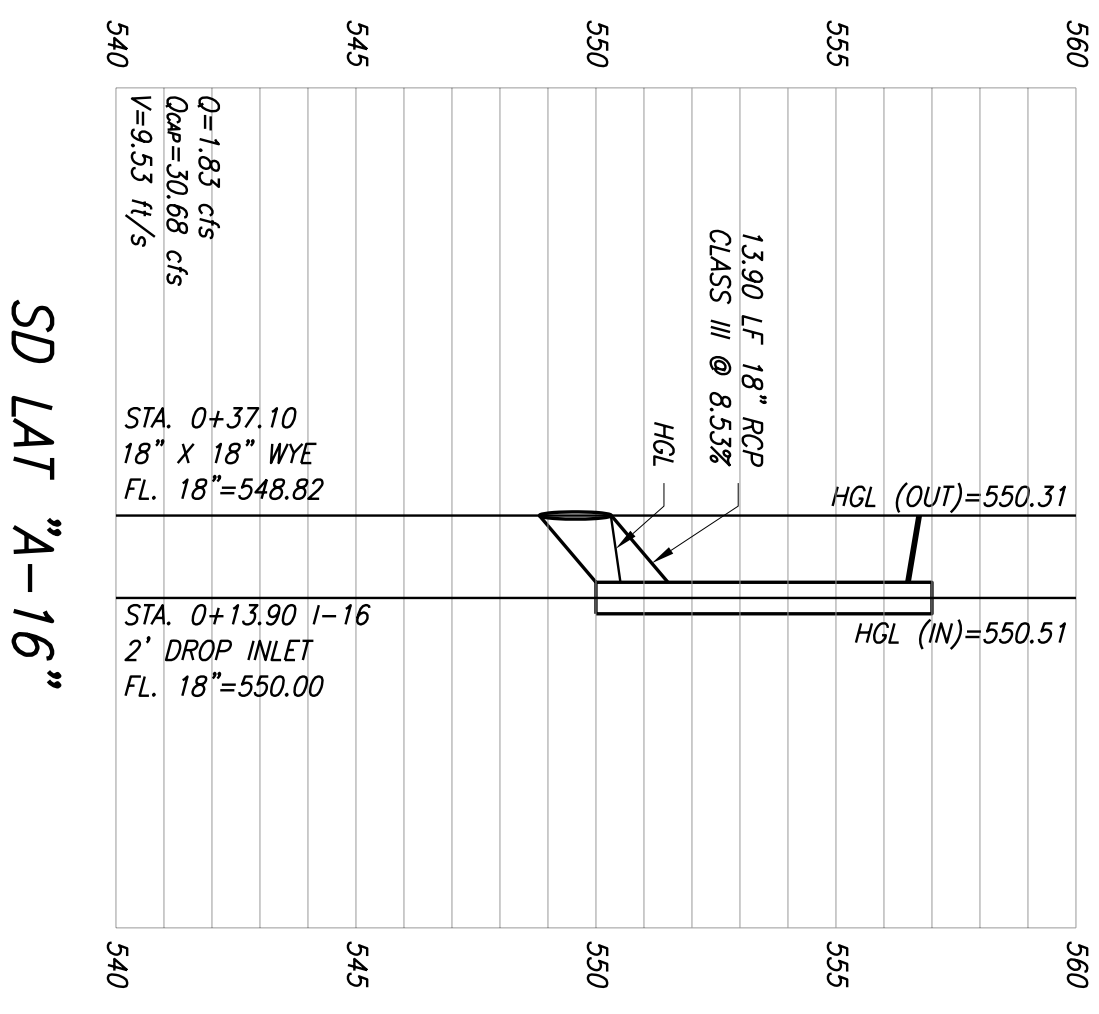


Date: Jul 16, 2007 4:23pm

User: cfm


File: N:\Record\IF-CV-ROK-PR-PIPE02.dwg

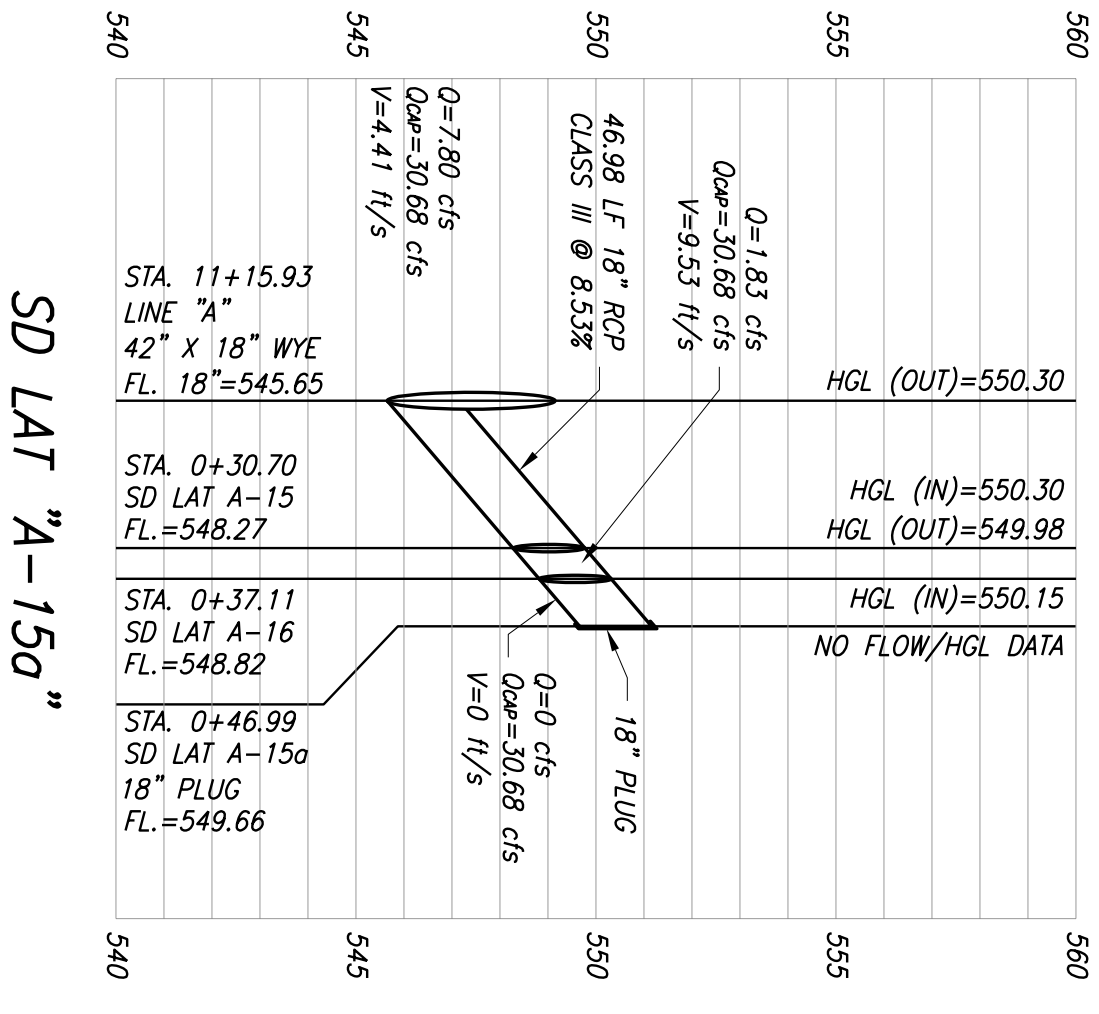

This Record Drawing is a combination of the sealed engineering contract drawings for this project, modified by information furnished by the contractor reflecting changes in the field. The original drawings are on file at the offices of
FRESE AND NICHOLS, INC.
 4055 INTERNATIONAL PLAZA, SUITE 200
 FORT WORTH, TEXAS 76109-4895
 DRAWINGS PREPARED ON:
 RECORD DRAWING 7/13/2007

SCALE:
 HORIZ: 1"=40'
 VERT: 1"=4'

| NO. | ISSUE | BY | DATE | F&N JOB NO. |
|-----|-------------------------|-----|-----------|--------------------------------|
| 1 | ISSUED FOR CONSTRUCTION | CJE | 3/01/2006 | ROK05274 |
| | | | | DATE 3/01/2006 |
| | | | | DESIGNED RAW |
| | | | | DRAWN CJE |
| | | | | REVISED CJE |
| | | | | CHECKED RAW |
| | | | | FILE NAME CV-ROK-PR-PIPE02.dwg |

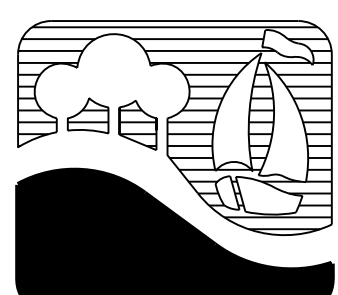

CITY OF ROCKWALL, TEXAS
ROSS STREET REHABILITATION AND DRAINAGE IMPROVEMENTS
STORM SEWER LATERAL PROFILES

Freese and Nichols
 1701 N. Market Street, Suite 500, LB 51
 Dallas, Texas 75202-2001
 Phone - (214) 920-2500
 Fax - (214) 920-2565

THE SEAL THAT ORIGINALLY APPEARED ON THIS DOCUMENT WAS AUTHORIZED BY TED B. SIGG, P.E. TEXAS NO. 82275 ON 7/13/2007. ALTERATION OF A SEALED DOCUMENT WITHOUT PROPER NOTIFICATION OF THE RESPONSIBLE ENGINEER IS AN OFFENSE UNDER THE TEXAS ENGINEERING PRACTICE ACT.