



Date: Jul 16, 2007 - 4:24pm User: dlm File: N:\Record\CV-ROK-PR-STDN01.dwg

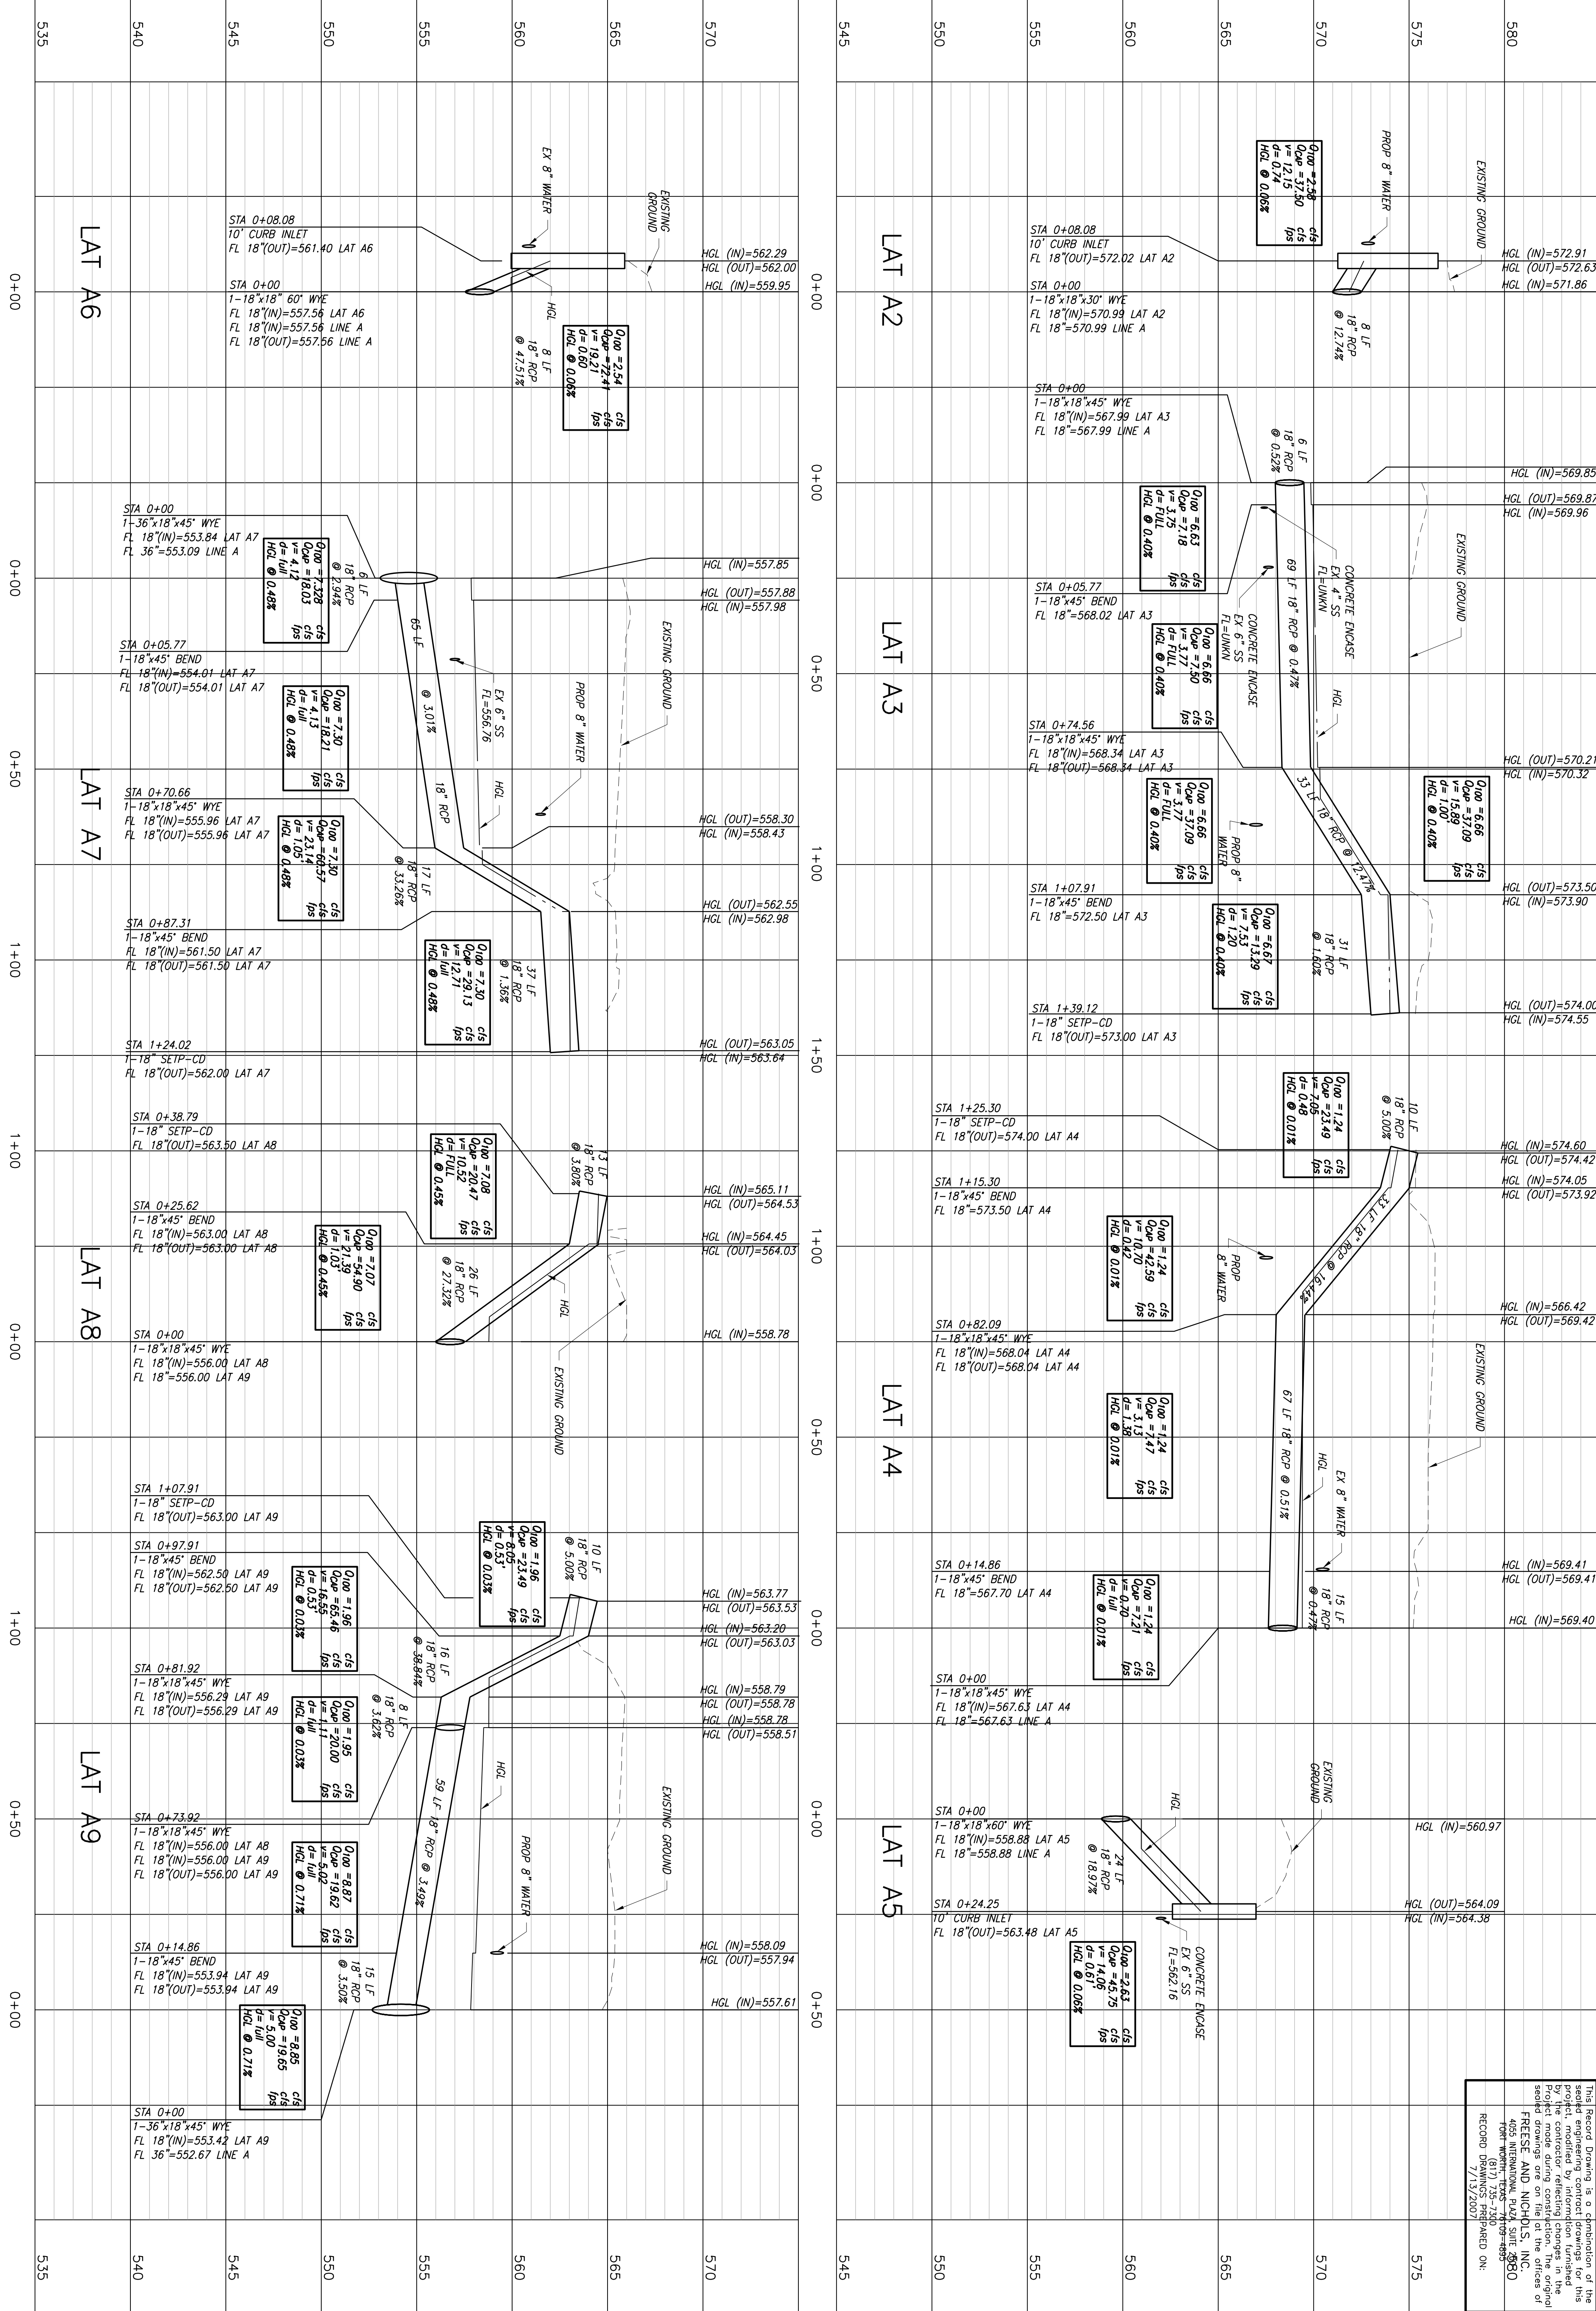

This Record Drawing is a combination of the
 project, modified by information furnished
 project made during construction. The original
 drawings are on file at the offices of
 FRESE AND NICHOLS, INC.
 4055 INTERNATIONAL PLAZA, SUITE 2080
 FORT WORTH, TEXAS 76109-4899
 RECORD DRAWINGS PREPARED ON:
 7/13/2007

NO.	ISSUE	BY	DATE	F&N JOB NO.
1				ROK05274
2			3/01/2006	
3				DESIGNED RAW
4				DRAWN NO/EAM
5				REVISED NO
6				CHECKED RAW
7				FILE NAME
8				CV-ROK-PR-STDN01.dwg

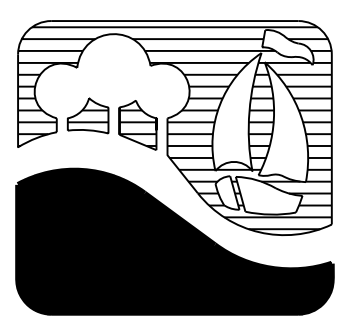

CITY OF ROCKWALL, TEXAS
**ROSS STREET REHABILITATION
 AND DRAINAGE IMPROVEMENTS**
**ROSS STREET STORM DRAIN
 LATERAL PROFILES**

Freese and Nichols
 1701 N. Market Street, Suite 500, LB 51
 Dallas, Texas 75202-2001
 Phone - (214) 920-2500
 Fax - (214) 920-2565

THE SEAL THAT ORIGINALLY APPEARED ON THIS DOCUMENT WAS
 AUTHORIZED BY T.E.B. SINGH, P.E.
 TEXAS NO. 82725 ON 7/13/2007
 ALTERATION OF A SEALED DOCUMENT WITHOUT PROPER
 NOTIFICATION OF THE RESPONSIBLE ENGINEER IS AN
 OFFENSE UNDER THE TEXAS ENGINEERING PRACTICE ACT

SHEET
C-10
 SEQ.

VERIFY SCALE 1
 Bar is one inch on original
 drawing. If not one inch on
 this sheet, adjust scale.