



Date: Jul 16, 2007 - 4:25pm User: dlm File: N:\Record\CV-ROK-PR-STDN02.dwg

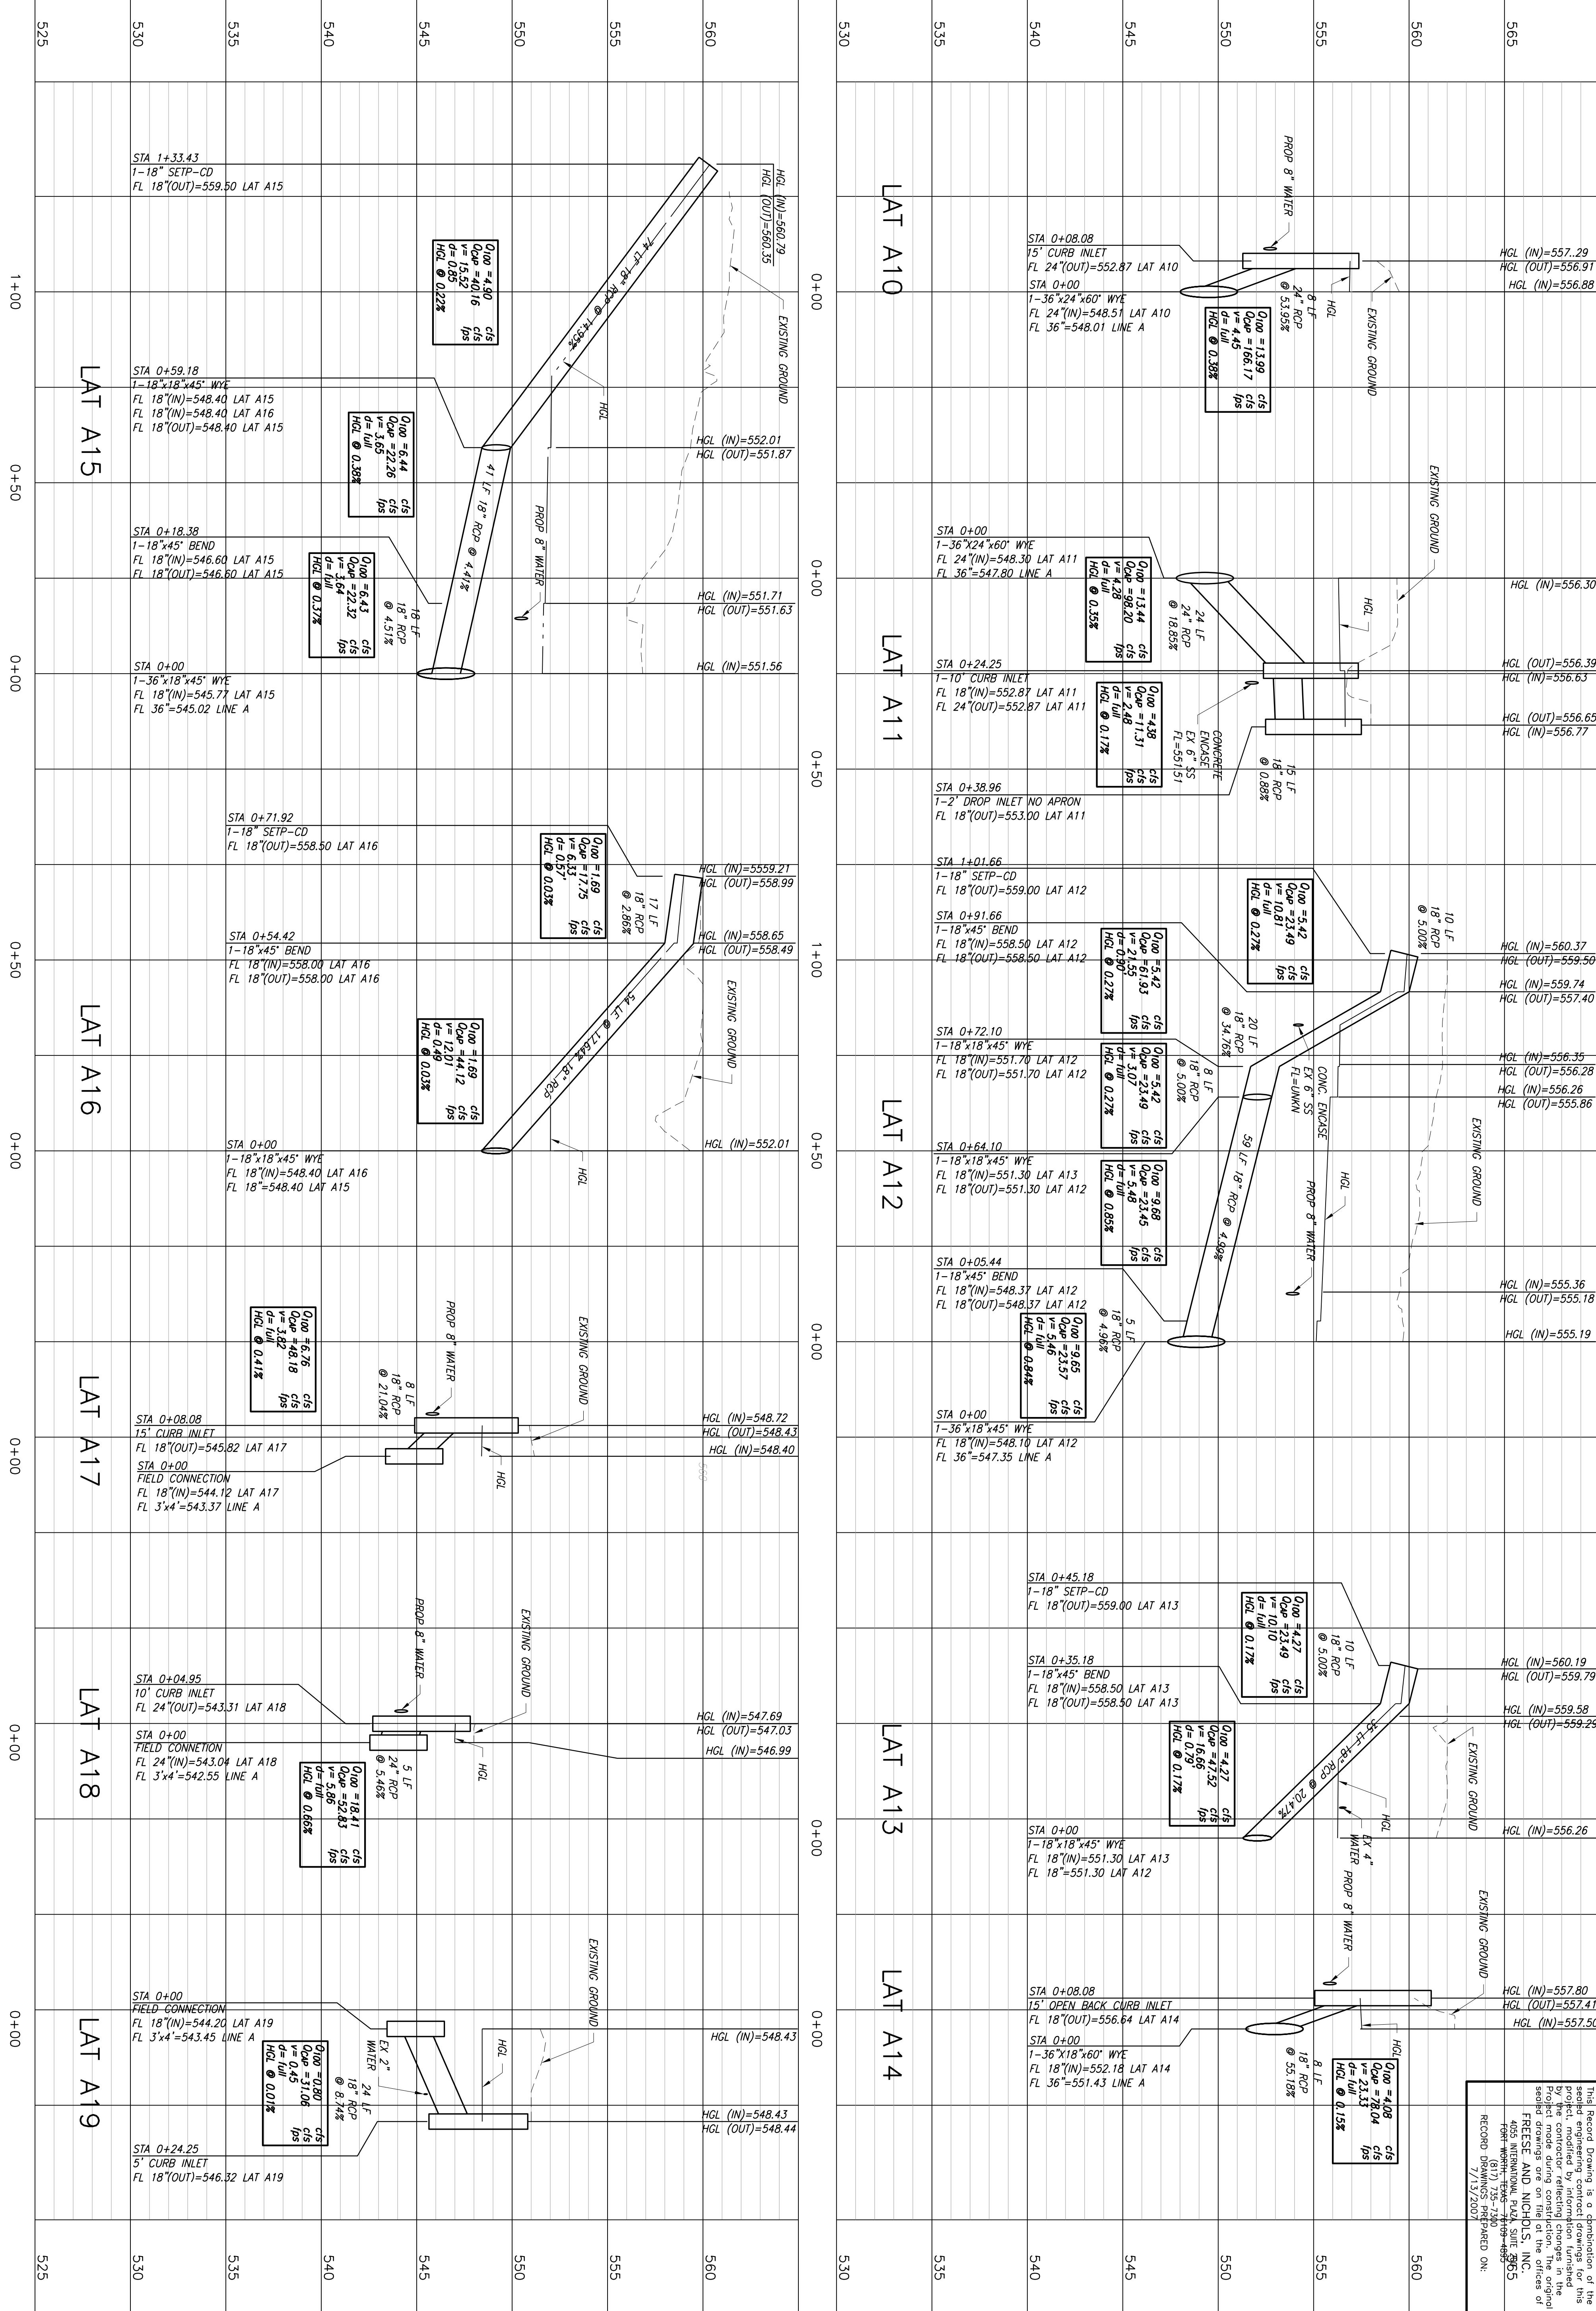

This Record Drawing is a combination of the project engineering contract drawings for this project modified by information furnished by the contractor during construction. The original project drawings are on file at the offices of FRESSE AND NICHOLS, INC. 4055 INTERNATIONAL PARKWAY, SUITE 2005 FORT WORTH, TEXAS 76109-4955 (817) 725-7100 (817) 725-7101 RECORD DRAWINGS PREPARED ON: 7/13/2007

NO.	ISSUE	BY	DATE	F&N JOB NO.
1				ROK05274
2				DATE 3/01/2006
3				DESIGNED RAW
4				DRAWN NO/EAM
5				REVISED NO
6				CHECKED RAW
7				FILE NAME
8				CV-ROK-PR-STDN02.dwg

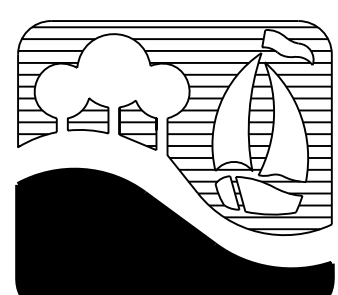

CITY OF ROCKWALL, TEXAS
**ROSS STREET REHABILITATION
 AND DRAINAGE IMPROVEMENTS**
**ROSS STREET STORM DRAIN
 LATERAL PROFILES**

Fresse and Nichols
 1701 N. Market Street, Suite 500, LB 51
 Dallas, Texas 75202-2001
 Phone - (214) 920-2500
 Fax - (214) 920-2565

THE SEAL THAT ORIGINALLY APPEARED ON THIS DOCUMENT WAS AUTHORIZED BY T.E.B. SUGGS, P.E. TEXAS NO. 82275 ON 7/13/2007. ALTERATION OF A SEALED DOCUMENT WITHOUT PROPER NOTIFICATION OF THE RESPONSIBLE ENGINEER IS AN OFFENSE UNDER THE TEXAS ENGINEERING PRACTICE ACT.

VERIFY SCALE 1
 Bar is one inch on original drawing. If not one inch on this sheet, adjust scale.

SHEET C-11