


This Record Drawing is a combination of the project engineering contract drawings for this project, modified by information furnished by the contractor during construction. The original project drawings are on file at the offices of FREESE AND NICHOLS, INC., 4055 INTERNATIONAL PLAZA, SUITE 200 FORT WORTH, TEXAS 76109-4895 (817) 735-7300. RECORD DRAWINGS PREPARED ON: 7/13/2007

THE SEAL THAT ORIGINALLY APPEARED ON THIS DOCUMENT WAS AUTHORIZED BY TED B. SIBBS, P.E. TEXAS NO. 82275 ON 7/13/2007. ALTERATION OF A SEALED DOCUMENT WITHOUT PROPER NOTIFICATION OF THE RESPONSIBLE ENGINEER IS AN OFFENSE UNDER THE TEXAS ENGINEERING PRACTICE ACT.



CITY OF ROCKWALL, TEXAS  
 ROSS STREET REHABILITATION  
 AND DRAINAGE IMPROVEMENTS

CROSS SECTIONS

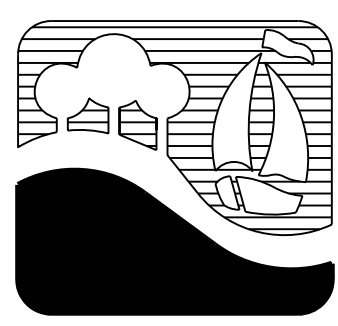

F&N JOB NO.	ROK05274
DATE	3/01/2006
DESIGNED	RAW
DRAWN	NO/EAM
REVISED	NO
CHECKED	RAW
FILE NAME	CV-ROK-XS-SECT01.dwg

NO.	ISSUE	BY	DATE

VERIFY SCALE 1 Bar is one inch on original drawing. If not one inch on this sheet, adjust scale.

SCALE:  
 HORIZ: 1"=20'  
 VERT: 1"=4'

SHEET XS-1