


This Record Drawing is a combination of the selected engineering contract drawings for this project, as approved by the City of Rockwall, Texas. It is intended to be used for construction purposes. The original drawings are on file at the offices of FREESE AND NICHOLS, INC., 4055 INTERNATIONAL BLVD, SUITE 200, FORT WORTH, TEXAS 76117. TEL: 817-725-4893. RECORD DRAWING PREPARED ON: 7/13/2007

THE SEAL THAT ORIGINALLY APPEARED ON THIS DOCUMENT WAS AUTHORIZED BY TED B. SUGGS, P.E. TEXAS NO. 82275 ON 7/13/2007. ALTERATION OF A SEALED DOCUMENT WITHOUT PROPER NOTIFICATION OF THE RESPONSIBLE ENGINEER IS AN OFFENSE UNDER THE TEXAS ENGINEERING PRACTICE ACT.

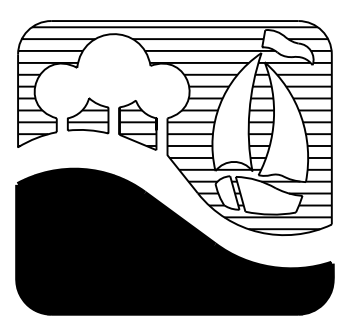

CITY OF ROCKWALL, TEXAS
 ROSS STREET REHABILITATION
 AND DRAINAGE IMPROVEMENTS
 CROSS SECTIONS
 INTERSECTION DRIVES



F&N JOB NO.	ROK05274
DATE	3/01/2006
DESIGNED	RAW
DRAWN	NO/EAM
REVISED	NO
CHECKED	RAW
FILE NAME	CV-ROK-XS-SECT06.dwg

NO.	ISSUE	BY	DATE

VERIFY SCALE 1 Bar is one inch on original drawing. If not one inch on this sheet, adjust scale.

SCALE: HORIZ: 1"=20' VERT: 1"=4'
 SHEET XS-6