


DRAINAGE AREA MAP RATIONAL METHOD

Drainage Area Calculations- City of Rockwall					
Drainage Area Name	"C"	Intensity (in/hr)	Area (ac)	Q 100 (cfs)	Notes
EX-1	0.9	9.8	1.68	14.82	To exist. 2-2x4' RCB under 205 bypass
EX-2	0.5	9.8	3.31	16.22	To exist. 3x3' "Y" inlet
EX-3	0.9	9.8	0.51	4.50	To exist. 10' curb inlet
EX-4	0.5	9.8	2.38	11.66	To exist. 10' curb inlet
EX-5	0.9	9.8	4.67	41.19	Exist. area inlet connected to 21" RCP
EX-6	0.5	9.8	4.00	19.60	Exist. 36" RCP
EX-7	0.5	9.8	61.88	303.21	To Exist. 8x4' RCB
EX-10	0.9	9.8	3.37	29.72	To exist. 10' curb inlet
EX-11	0.9	9.8	2.11	18.61	To exist. 10' curb inlet
EX-12	0.5	9.8	2.20	10.78	To exist. 10' curb inlet
EX-13	0.5	9.8	1.81	8.87	To exist. 10' curb inlet
EX-14	0.5	9.8	2.45	12.01	To Culvert A Outfall
A-0	0.9	9.8	3.24	28.58	To 3x3' area inlet and 27" stubbed RCP
A-1	0.9	9.8	3.41	30.08	Proposed inlets
A-2	0.9	9.8	1.63	14.38	Proposed 20' curb inlet
A-3	0.9	9.8	2.09	18.43	Proposed 20' curb inlet
A-4	0.9	9.8	0.80	7.06	Proposed 15' curb inlet
A-5	0.9	9.8	1.63	14.38	Proposed 15' curb inlet
A-6	0.9	9.8	0.72	6.35	Proposed 15' curb inlet
A-7	0.9	9.8	0.64	5.64	Proposed 10' curb inlet
A-8	0.9	9.8	1.84	16.23	Proposed 20' curb inlet
B-1	0.9	9.8	1.66	14.64	Proposed 20' curb inlet
B-2	0.9	9.8	1.00	8.82	Proposed 15' curb inlet
B-3	0.9	9.8	1.50	13.23	Proposed 20' curb inlet
C-1	0.9	9.8	1.40	12.35	Proposed 24" Culvert to Culvert B
OS-1	0.5	9.8	69.63	341.19	Offsite area going to proposed Culvert A
OS-2	0.5	9.8	30.52	149.55	Offsite area going to proposed Culvert A
OS-3	0.5	9.8	83.00	406.70	Offsite area going to proposed Culvert A
OS-4	0.5	9.8	70.03	343.15	Offsite area going to proposed Culvert B
OS-5	0.5	9.8	5.72	28.03	Offsite area going to proposed Culvert B

This Record Drawing is a combination of the sealed engineering contract drawings for this project, modified by information furnished by the contractor reflecting changes in the field. The contractor shall be responsible for sealed drawings are on file at the offices of
FREEST AND NICHOLS, INC.
 4055 INTERNATIONAL PLAZA, SUITE 200
 FORT WORTH, TEXAS 76109-4885
 (817) 737-7500
 RECORD DRAWING PREPARED ON:
 3/16/2009

THIS SEAL THAT ORIGINALLY APPEARED ON THIS DOCUMENT WAS REPRODUCED BY JEDICA M. FALGOUTS. ALTERATION OF A SEALED DOCUMENT WITHOUT PROPER PERMISSION IS A VIOLATION OF THE PROFESSIONAL ENGINEERING PRACTICE ACT.

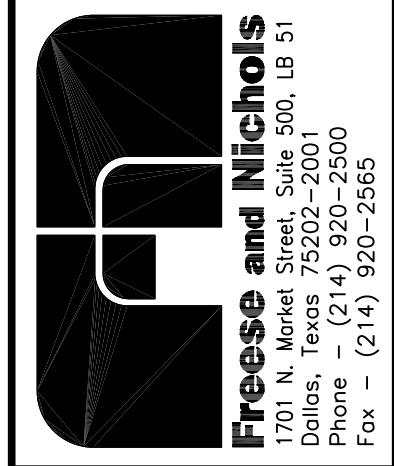

INLET CAPACITY CALCULATIONS

GUTTER FLOW/ INLET COMPUTATIONS																													
ID	INLET			D.A. No.	D.A. Area	C	Time to Inlet	Intensity	Q	CO	Qr	n	SL	SX	a	W	S'w	S'w	Eo	Se	y	T	Lr	L	E	Qf	Qa-Qf	Bypass Target:	Remarks
	LOCATION	TYPE																											
1	2	3	4	5	6	7	8	9	10	11	12	13	14	15	16	17	18	19	20	21	22	23	24	25	26	27	28	29	
A0	Sta10+40.29 205 Bypass (RT)	On Grade	A0	3.24	0.50	10	9.80	15.88	0.00	15.88	0.0175	0.0015	n/a	n/a	n/a	n/a	n/a	n/a	n/a	n/a	n/a	3.00	3	1.00	15.88	0.00		3x3' "Y" inlet	
A1a	Sta 14+73.50 205 Bypass (RT)	On Grade	A1	0.72	0.90	10	9.80	6.35	0.00	6.35	0.0175	0.0055	0.021	0.5	2.00	0.25	0.27	0.30	0.09	0.34	16.27	12.76	10	0.78	4.98	1.37		A1N	
A1N	Sta 15+21.50 205 Bypass (RT)	Sag	A1	1.00	0.90	10	9.80	8.82	1.37	10.19	0.0175	0.0030	0.021	0.5	2.00	0.25	0.27	0.23	0.08	0.45	21.78	14.63	20	1.00	10.19	0.00			
A1S	Sta 15+21.50 205 Bypass (RT)	Sag	A1	1.00	0.90	10	9.80	8.82	1.70	10.52	0.0175	0.0030	0.021	0.5	2.00	0.25	0.27	0.22	0.08	0.46	22.04	14.90	20	1.00	10.52	0.00			
A1b	Sta15+67.88 205 Bypass (RT)	On Grade	A1	0.69	0.90	10	9.80	6.09	0.00	6.09	0.0175	0.0090	0.021	0.5	2.00	0.25	0.27	0.33	0.10	0.30	14.60	13.89	10	0.72	4.38	1.70		A1S	
A2	Sta 40+63.09 205 Bypass (LT)	On Grade	A2	1.90	0.90	10	9.80	16.76	0.00	16.76	0.0175	0.0080	0.021	0.5	2.00	0.25	0.27	0.23	0.08	0.45	21.83	24.23	20	0.83	13.84	2.92		A3	
A3	Sta 51+02.57 205 Bypass (LT)	On Grade	A3	2.09	0.90	10	9.80	18.43	2.92	21.36	0.0175	0.0200	0.021	0.5	2.00	0.25	0.27	0.24	0.08	0.42	20.13	33.93	20	0.59	12.59	8.77		A4	
A4	Sta 54+26.66 205 Bypass (LT)	On Grade	A4	0.80	0.90	10	9.80	7.06	8.77	15.82	0.0175	0.0100	0.021	0.5	2.00	0.25	0.27	0.24	0.08	0.43	20.49	23.48	15	0.64	10.11	5.72		A6N	
A6N	Sta 55+22.50 205 Bypass (LT)	Sag	A6	0.36	0.90	10	9.80	3.18	5.72	8.89	0.0175	0.0030	0.021	0.5	2.00	0.25	0.27	0.24	0.08	0.43	20.69	11.40	15	1.00	8.89	0.00			
A6S	Sta 55+22.50 205 Bypass (LT)	Sag	A6	0.36	0.90	10	9.80	3.18	4.11	7.29	0.0175	0.0030	0.021	0.5	2.00	0.25	0.27	0.25	0.08	0.40	19.20	10.15	15	1.00	7.29	0.00			
A5N	Sta 55+22.50 205 Bypass (RT)	Sag	A5	1.03	0.90	10	9.80	9.08	0.00	9.08	0.0175	0.0030	0.021	0.5	2.00	0.25	0.27	0.24	0.08	0.43	20.85	11.54	15	1.00	9.08	0.00			
A5S	Sta 55+22.50 205 Bypass (RT)	Sag	A5	0.60	0.90	10	9.80	5.29	0.00	5.29	0.0175	0.0030	0.021	0.5	2.00	0.25	0.27	0.28	0.09	0.35	17.03	8.35	15	1.00	5.29	0.00			
A7	Sta 56+17.35 205 Bypass (LT)	On Grade	A7	0.64	0.90	10	9.80	5.64	4.25	9.89	0.0175	0.0080	0.021	0.5	2.00	0.25	0.27	0.27	0.09	0.37	17.91	17.11	10	0.58	5.78	4.11		A6S	
A8	Sta 58+00 205 Bypass (LT)	On Grade	A8	1.84	0.90	10	9.80	16.23	0.00	16.23	0.0175	0.0150	0.021	0.5	2.00	0.25	0.27	0.25	0.08	0.40	19.17	27.09	20	0.74	11.98	4.25		A7	
B1N	Sta 69+22.50 205 Bypass (LT)	Sag	B1	0.88	0.90	10	9.80	7.76	3.37	11.13	0.0175	0.0030	0.021	0.5	2.00	0.25	0.27	0.22	0.08	0.47	22.50	12.95	20	1.00	11.13	0.00			
B1S	Sta 69+22.50 205 Bypass (LT)	Sag	B1	0.78	0.90	10	9.80	6.88	0.00	6.88	0.0175	0.0030	0.021	0.5	2.00	0.25	0.27	0.26	0.09	0.39	18.79	9.81	20	1.00	6.88	0.00			
B2N	Sta 69+22.50 205 Bypass (RT)	Sag	B2	0.74	0.90	10	9.80	6.53	0.00	6.53	0.0175	0.0030	0.021	0.5	2.00	0.25	0.27	0.26	0.09	0.38	18.42	9.50	15	1.00	6.53	0.00			
B2S	Sta 69+22.50 205 Bypass (RT)	Sag	B2	0.26	0.90	10	9.80	2.29	0.00	2.29	0.0175	0.0030	0.021	0.5	2.00	0.25	0.27	0.37	0.11	0.26	12.44	4.69	15	1.00	2.29	0.00			
B3	Sta 67+00 Bypass (LT)	On Grade	B3	1.50	0.90	10	9.80	13.23	0.00	13.23	0.0175	0.0200	0.021	0.5	2.00	0.25	0.27	0.29	0.09	0.35	16.82	26.83	20	0.75	9.86	3.37		BIN	

LEGEND:
 Q - Discharge Calculated for D.A.
 CO - Carryover from upstream inlet
 Qr - Actual Discharge = Qr/CO
 n - Manning's roughness coefficient
 SL - Longitudinal slope of roadway
 Sx or Sw - Cross-slope or Gutter Slope
 y - Gutter depth of flow
 W - Width of gutter conveying flow
 a - depth of depression
 Lr - Required inlet for 100% interception
 L - Actual inlet length
 Q - Actual inlet interception
 T - Top width of spread
 E - Efficiency

ACAD: Rel 17.0s (LMS Tech) User: KAS
 [R0K06114]MCSRVJIN:\205 DALLAS N DRIVE\VF\DRAWINGS\CV-ALL-PL-DRNG04.DWG LAYOUT: Layout1 (2)
 NOV 17, 2006 2:00:42 A.M. LIS: .00 PSL: 1
 REFERENCE FILE: ...\\STANDARD\34BORDER

CITY OF ROCKWALL, TEXAS
205 BYPASS CONSTRUCTION
 CIVIL
STORM SEWER CALCULATIONS

NO. ISSUE: _____
 SHEET: _____
 SEQ. 25 OF 86

DATE: _____
 DESIGNED: KAS
 DRAWN: KAS
 CHECKED: TBS
 FILE NAME: CV-ALL-PL-DRNG04.dwg

RECORD DRAWINGS
 5/12/09
 Bar is one inch on original drawing, if not one inch on this sheet, adjust scale.

DA-4