


This Record Drawing is a combination of the sealed engineering contract drawings for this project, modified by information furnished by the contractor reflecting changes in the Project made during construction. The original sealed drawings are on file at the offices of
FREES AND NICHOLS, INC.
 4055 INTERNATIONAL PLAZA, SUITE 200
 FORT WORTH, TEXAS 76109-4895
 (817) 735-7300
 RECORD DRAWINGS PREPARED ON:
 3/16/2009

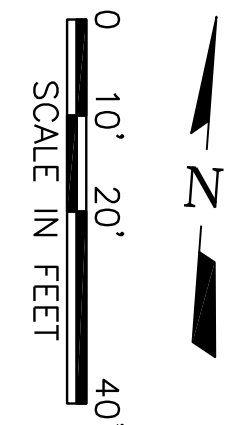

SCALE:
 HORIZ: 1"=20'
 VERT: 1"=5'

CITY OF ROCKWALL, TEXAS
205 BYPASS CONSTRUCTION

CIVIL
**STORM SEWER PLAN AND PROFILE
 STORM LINE A AND LATERAL A7**

THE SEAL THAT ORIGINALLY APPEARED ON THIS DOCUMENT WAS AUTHORIZED BY TRICIA N. HATLEY P.E. TEXAS REG. ENGINEER NO. 83285 ON 7/23/2008 ALTERATION OF A SEALED DOCUMENT WITHOUT PROPER NOTIFICATION OF THE RESPONSIBLE ENGINEER IS AN OFFENSE UNDER THE TEXAS ENGINEERING PRACTICE ACT

NO.	ISSUE	BY	DATE	F&N JOB NO.
1	RECORD DRAWINGS	CJP	5/12/09	ROK06114
	DESIGNED			KAS
	DRAWN			KAS
	REVISIONS			
	CHECKED			TBS

FILE NAME: CV-DNG-PP-STRM04.dwg

SHEET NO. 30 OF 86
 SD-4

VERIFY SCALE: Bar is one inch on original drawing. If not one inch on this sheet, adjust scale.