


SCALE:
 HORIZ: 1"=20'
 VERT: 1"=5'

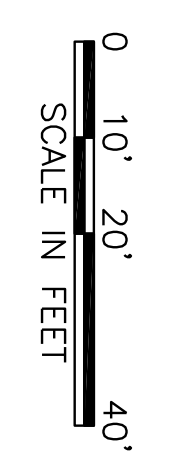

This Record Drawing is a combination of the sealed engineering contract drawings for this project, modified by information furnished by the contractor reflecting changes in the Project made during construction. The original sealed drawings are on file at the offices of

FREESSE AND NICHOLS, INC.
 4055 INTERNATIONAL PLAZA, SUITE 200
 FORT WORTH, TEXAS 76109-4895
 (817) 735-7300
 RECORD DRAWINGS PREPARED ON:
 3/16/2009

515 520 525 530 535 540 545 550 555 560


1+00 2+00 3+00 1+00 2+00

515 520 525 530 535 540 545 550 555 560

SD-5
 SHEET 31 OF 86

NO.	ISSUE	BY	DATE	F&N JOB NO.
1	RECORD DRAWINGS	CJP	5/12/09	ROK06114
2	VERIFY SCALE			05/2007
3	Bar is one inch on original drawing. If not one inch on this sheet, adjust scale.			DESIGNED: KAS
				DRAWN: KAS
				REVISED: TBS
				CHECKED: TBS
				FILE NAME: CV-DNG-PP-STRM05.dwg

CITY OF ROCKWALL, TEXAS
205 BYPASS CONSTRUCTION
 CIVIL
STORM SEWER PLAN AND PROFILE
STORM LATERALS A8 AND B3

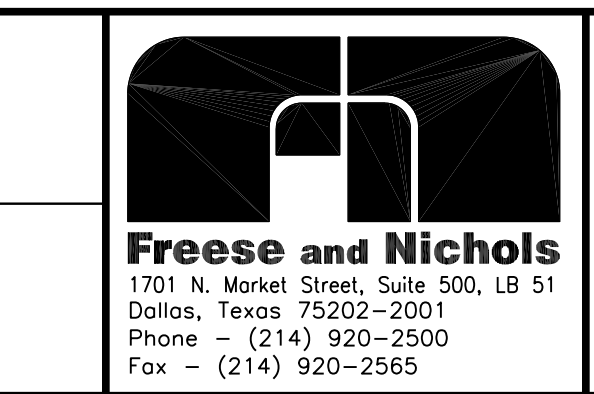

THE SEAL THAT ORIGINALLY APPEARED ON THIS DOCUMENT WAS AUTHORIZED BY TRICIA N. HATLEY, P.E., TEXAS REG. NO. 8326, ON 2/22/2008. ALTERATION OF A SEALED DOCUMENT WITHOUT PROPER NOTIFICATION OF THE RESPONSIBLE ENGINEER IS AN OFFENSE UNDER THE TEXAS ENGINEERING PRACTICE ACT.