
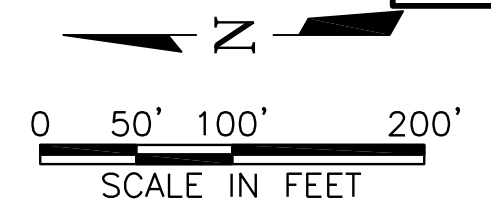




ACAD Rel 17.1s (LMS Tech) User: IS
 [R0K06114]DALSRV\N:\RECORD\CV-RDS-PL-HORZ01.DWG LAYOUT: Layout1
 MAR 16, 2009 3:44:41 P.M. LTS: 1.00 PSLTS: 1
 6 REFERENCE FILES: \BASE\CV-ALL-PL-SHAD, \BASE\CV-ALL-PL-SITE, \BASE\CV-ALL-PL-TOPO, \SEAL\S\83282, \SEAL\S\93882 and \STANDARD\4450RDR

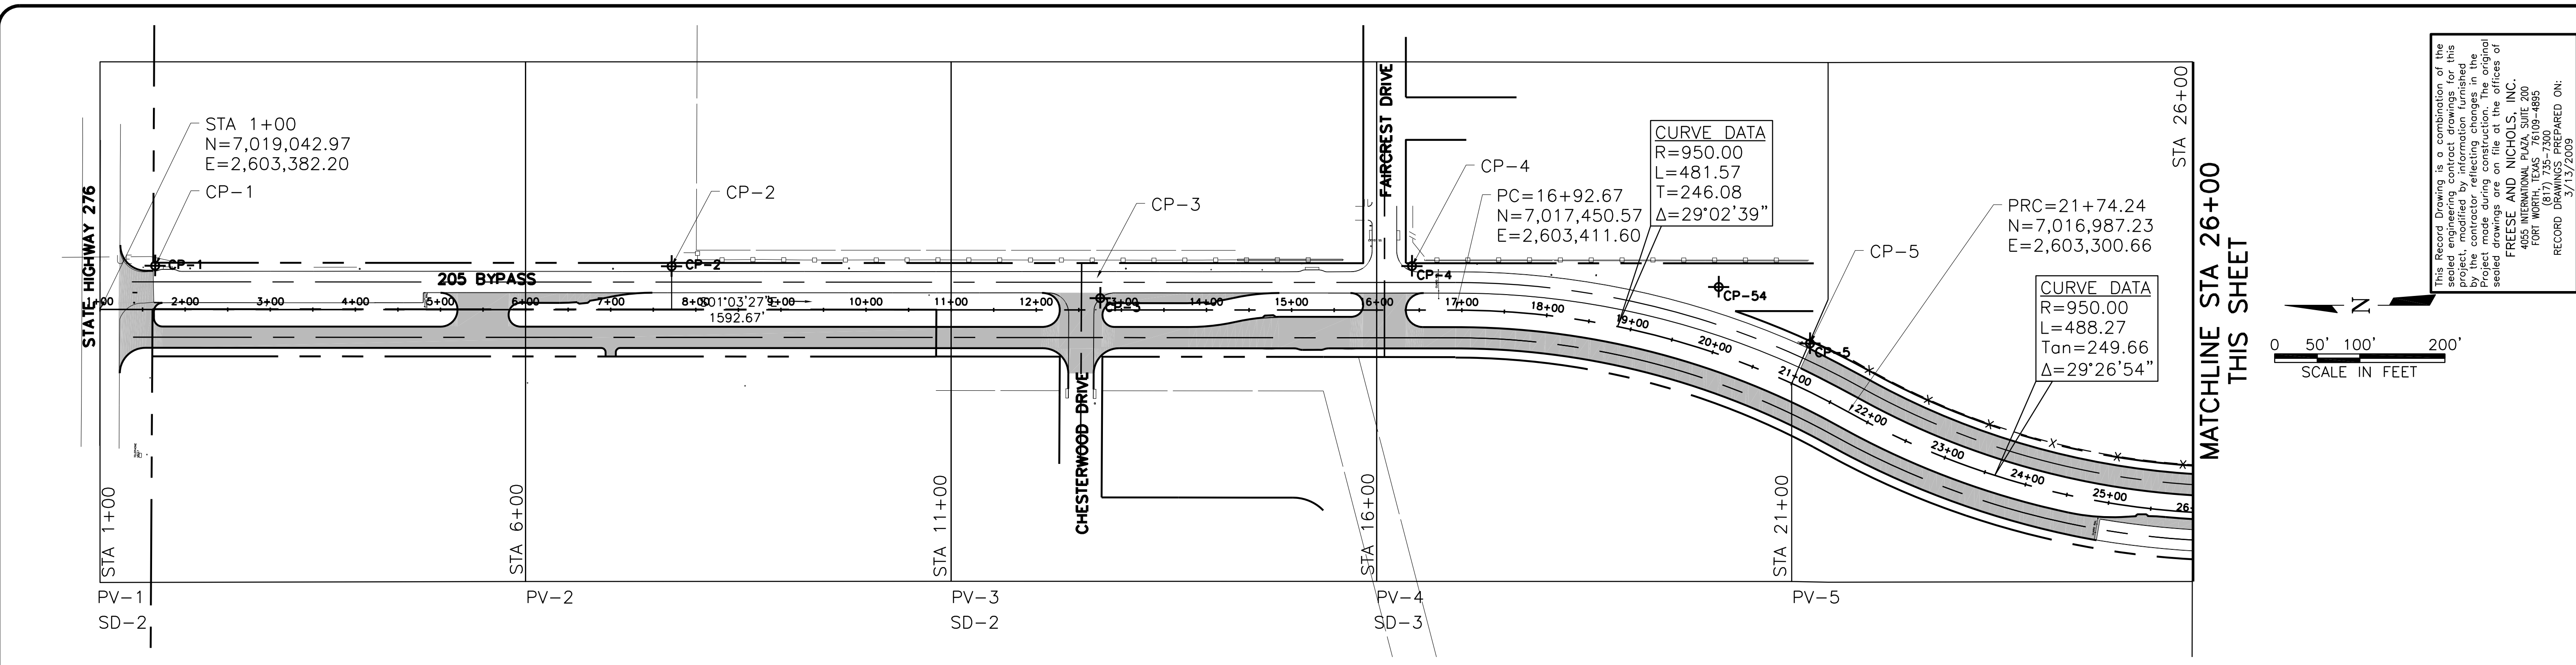

This Record Drawing is a combination of the original engineering and construction drawings and this project, modified by the contractor. The original drawings are on file at the offices of FRESSE AND NICHOLS, INC. 4001 WORTH, TEXAS 76109-4895 (817) 735-7300 RECORD DRAWINGS PREPARED ON: 5/13/2009

THIS SEAL THAT ORIGINALLY APPEARED ON THIS DOCUMENT WAS TRANSMITTED BY E-MAIL TO THE ENGINEER OF RECORD FOR ALTERATION OF A SEALER DOCUMENT WITHOUT PROPER PERMISSION UNDER THE TEXAS ENGINEERING PRACTICE ACT

Fresse and Nichols
 1701 N. Meckel Street, Suite 500, LB 51
 Dallas, Texas 75202-2001
 Phone - (214) 920-2500
 Fax - (214) 920-2565

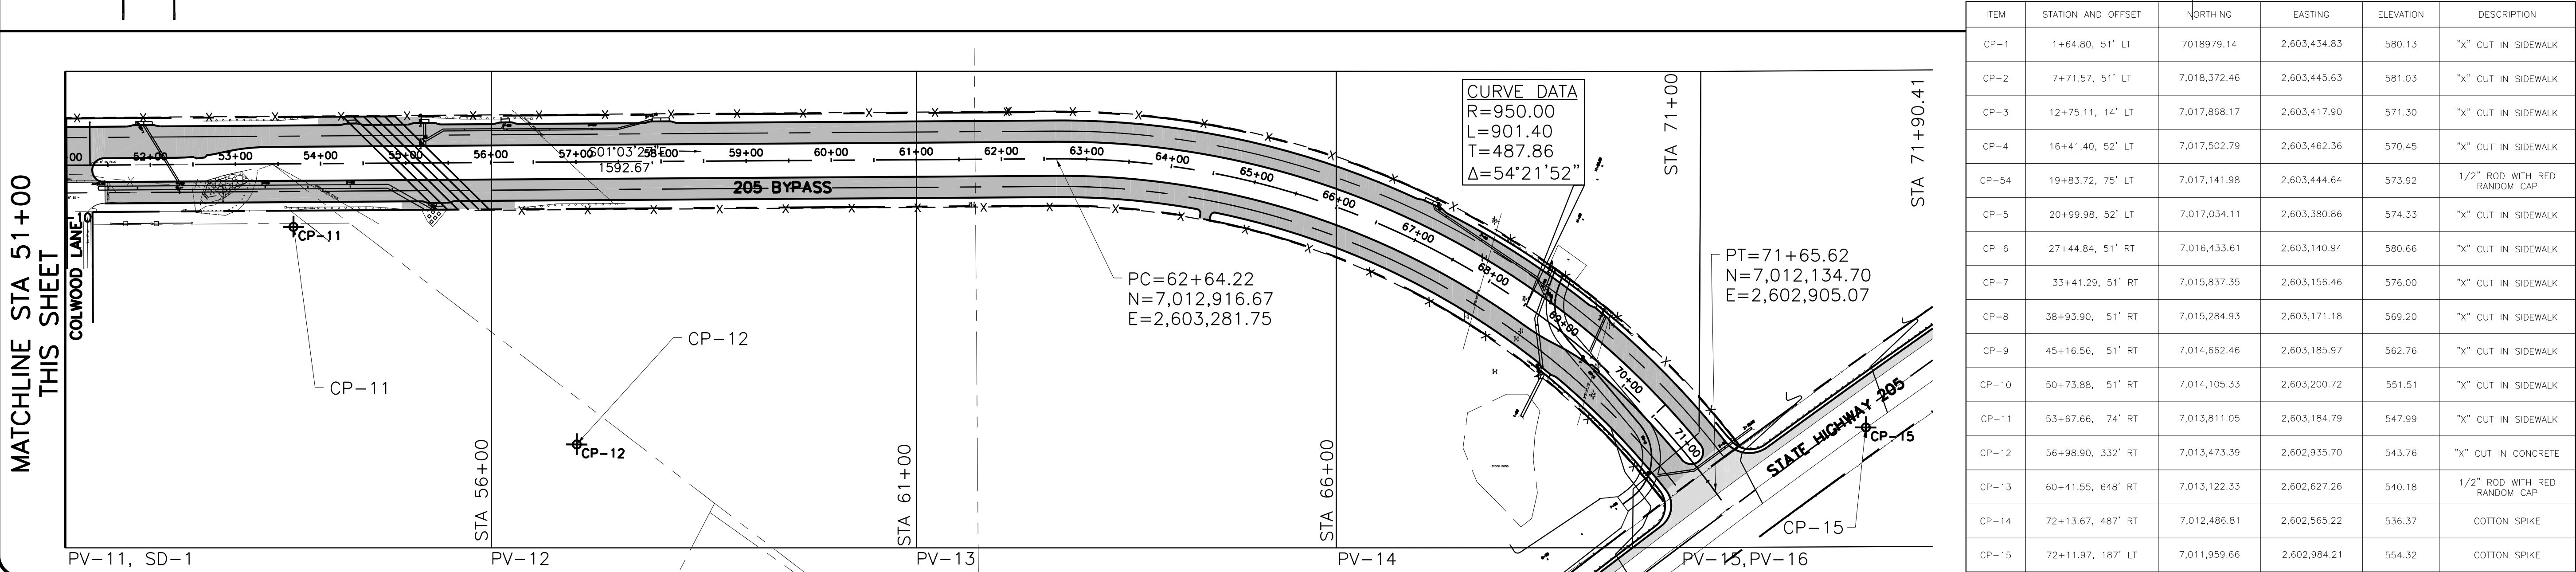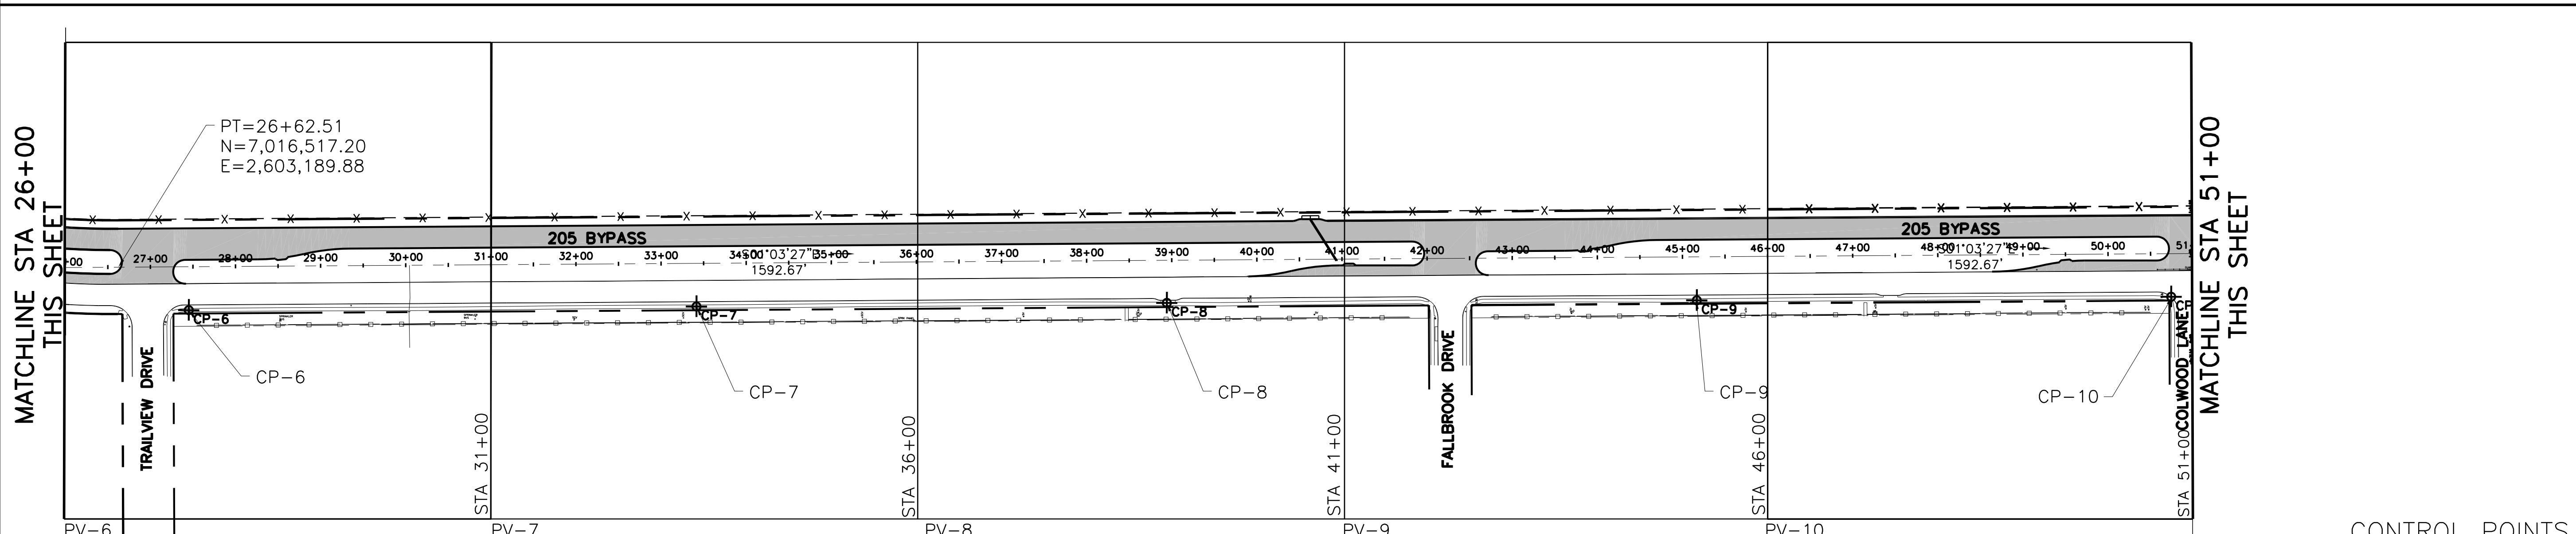

CONTROL POINTS

ITEM	STATION AND OFFSET	NORTHING	EASTING	ELEVATION	DESCRIPTION
CP-1	1+64.80, 51' LT	7018979.14	2,603,434.83	580.13	"X" CUT IN SIDEWALK
CP-2	7+71.57, 51' LT	7,018,372.46	2,603,445.63	581.03	"X" CUT IN SIDEWALK
CP-3	12+75.11, 14' LT	7,017,866.17	2,603,417.90	571.30	"X" CUT IN SIDEWALK
CP-4	16+41.40, 52' LT	7,017,502.79	2,603,462.36	570.45	"X" CUT IN SIDEWALK
CP-54	19+83.72, 75' LT	7,017,141.98	2,603,444.64	573.92	1/2" ROD WITH RED RANDOM CAP
CP-5	20+99.98, 52' LT	7,017,034.11	2,603,380.86	574.33	"X" CUT IN SIDEWALK
CP-6	27+44.84, 51' RT	7,016,433.61	2,603,140.94	580.66	"X" CUT IN SIDEWALK
CP-7	33+41.29, 51' RT	7,015,837.35	2,603,156.46	576.00	"X" CUT IN SIDEWALK
CP-8	38+93.90, 51' RT	7,015,284.93	2,603,171.18	569.20	"X" CUT IN SIDEWALK
CP-9	45+16.56, 51' RT	7,014,662.46	2,603,185.97	562.76	"X" CUT IN SIDEWALK
CP-10	50+73.88, 51' RT	7,014,105.33	2,603,200.72	551.51	"X" CUT IN SIDEWALK
CP-11	53+67.66, 74' RT	7,013,811.05	2,603,184.79	547.99	"X" CUT IN SIDEWALK
CP-12	56+98.90, 332' RT	7,013,473.39	2,602,935.70	543.76	"X" CUT IN CONCRETE
CP-13	60+41.55, 648' RT	7,013,122.33	2,602,627.26	540.18	1/2" ROD WITH RED RANDOM CAP
CP-14	72+13.67, 487' RT	7,012,486.81	2,602,565.22	536.37	COTTON SPIKE
CP-15	72+11.97, 187' LT	7,011,959.66	2,602,984.21	554.32	COTTON SPIKE

CITY OF ROCKWALL, TEXAS
205 BYPASS CONSTRUCTION
 CIVIL
HORIZONTAL CONTROL PLAN

NO.	ISSUE	BY	DATE	FROM JOB NO.	ROK06114
				DATE	05/2007
				DESIGNED	KAS
				DRAWN	CHM
				REVISION	
				FILE NAME	CV-RDS-PL-HORZ01.dwg
				CHECKED	TBS
				REVISION	
				DATE	5/12/09
				FILE NAME	CV-RDS-PL-HORZ01.dwg
				CHECKED	TBS
				REVISION	
				DATE	
				FILE NAME	
				CHECKED	
				REVISION	
				DATE	
				FILE NAME	
				CHECKED	
